


"AS BUILT"
 Information shown on these plans was furnished by the Contractor. All responsibility for the accuracy belongs to the Contractor.

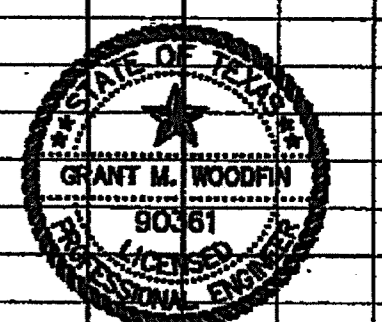

The Seal Appearing On This Document Was Authorized By
 R.M. Woodruff
 2.8.17

**PAVING PLAN & PROFILE
 ALLEY 'C', & 'D'
 THE PRESERVE - PHASE 2
 CITY OF ROCKWALL, TEXAS**

C&P Engineering, LTD.
 Engineering • Planning • Surveying

1801 GATEWAY BLVD. - SUITE 101
 RICHARDSON, TEXAS 75080
 email: info@c-and-p-engineering.com

(972) 644-2800 OFD
 DRAWN BY: C&P DATE: 2/06 SCALE: 1"=40'-H, 1"=8'-V JOB NUMBER: 05109 SHEET NO.: 14A of 14