

60 30 0 60 120
SCALE FEET
1" = 60'

LEGEND

- Ex 60.0 = Existing Ground Elev.
- FP 60.0 = Prop. Finished Pad Elev.
- TC 60.0 = Top of Curb Elev.
- F 60.0 = Finished Grade Elev.
- = Retaining Wall
- * = Location of Driveways

BENCH MARK: #1
BRASS CAP IN CL. OF MEDIAN NORTH ON LAKESHORE DRIVE NORTH OF THE INTERSECTION OF NORTH ALAMO AND LAKESHORE DRIVE.


ELEV. 524.78

BENCH MARK: #2
BRASS CAP IN CL. OF MEDIAN ON LAKESHORE DRIVE BETWEEN TO STREETS, STONEBROOK AND AMESBURY BEING NORTH OF HAVEN HILL.

ELEV. 518.83

- Notes:
1. No part of any retaining wall (footing, tie-backs, etc) shall not be located in any City right-of-way, easement, or visibility clip.
 2. Retaining Wall backfill and base to be compacted to 95% Standard Proctor Density.

Information shown on these plans was furnished by the Contractor. All responsibility for the accuracy belongs to the Contractor.

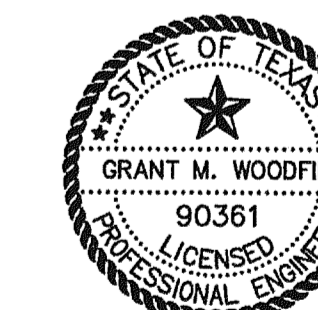

The Seal Appearing On This Document Was Authorized By
Grant M. Woodfin
90361, On 2/16/06

GRADING PLAN
THE PRESERVE - PHASE 2
CITY OF ROCKWALL, TEXAS

C&P Engineering, LTD.

Engineering • Planning • Surveying
1801 GATEWAY BLVD. - SUITE 101
RICHARDSON, TEXAS 75080
email: info@c-pengineering.com

(972) 644-2800 OFC (972) 644-2817 FAX
DRAWN BY: C&P DATE: 2/06 SCALE: 1"=60'-H JOB NUMBER: 05109 SHEET: 05109-Grd1
15 OF

