


**RECORD DRAWINGS**

NOTE: THESE PLANS HAVE BEEN REVISED TO CONFORM WITH CONSTRUCTION RECORDS PROVIDED TO SPARS ENGINEERING, INC. BY CONTRACTOR AND CITY STAFF AFTER AS-BUILTS WERE ORIGINALLY SUBMITTED TO THE CITY OF ROCKWALL BY OTHERS. MODIFICATIONS TO HAVING, PAD AND UTILITY ELEVATIONS AS REFLECTED IN THESE PLANS WERE VERIFIED BY FIELD SURVEY PERFORMED IN DECEMBER, 2008.

BENCH MARK: #1  
BRASS CAP INTCL. OF MEDIAN NORTH ON LAKESHORE DRIVE NORTH OF THE INTERSECTION OF NORTH ALAMO AND LAKESHORE DRIVE.  
ELEV. 524.78

BENCH MARK: #2  
BRASS CAP INTCL. OF MEDIAN ON LAKESHORE DRIVE BETWEEN TO STREETS, STONEBROOK AND AMESBURY BEING NORTH OF HAVEN HILL.  
ELEV. 518.83

"AS BUILTS"  
Information shown on these plans was furnished by the Contractor. All responsibility for the accuracy belongs to the Contractor.

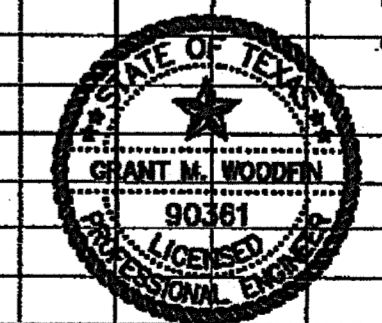

The Seal Appearing On This Document Was Authorized By

*Grant M. Woodfin*  
90381  
2.8.09

**SANITARY SEWER PROFILES**  
**THE PRESERVE - PHASE 2**  
**CITY OF ROCKWALL, TEXAS**

**C&P Engineering, LTD.**  
Engineering • Planning • Surveying  
1801 GATEWAY BLVD. - SUITE 101  
RICHARDSON, TEXAS 75080  
email: info@c-pengineering.com

(972) 844-2800 OFC (972) 844-2817 FAX  
DRAWN BY: DATE: SCALE: JOB NUMBER: SHEET: 05109-551  
C&P 2/06 1"=40'-H 05109 23 of