


**RECORD DRAWINGS**

NOTE: THESE PLANS HAVE BEEN REVISED TO CONFORM WITH CONSTRUCTION RECORDS PROVIDED TO SPIARS ENGINEERING, INC. BY CONTRACTOR AND CITY STAFF AFTER AS-BUILTS WERE ORIGINALLY SUBMITTED TO THE CITY OF ROCKWALL BY OTHERS. MODIFICATIONS TO PAVING PAD AND UTILITY ELEVATIONS, AS REFLECTED ON THESE PLANS, WERE VERIFIED BY FIELD SURVEY PERFORMED IN DECEMBER, 2008.

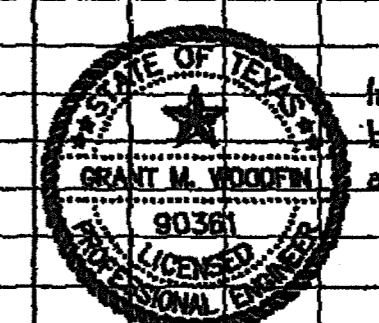

The Seal Appearing on This Document Was Authorized By  
 90381-01  
 7/14/07

"AS BUILTS"  
 Information shown on these plans was furnished by the Contractor. All responsibility for the accuracy belongs to the Contractor.

**SANITARY SEWER PROFILES**  
**THE PRESERVE - PHASE 2**  
 CITY OF ROCKWALL, TEXAS

**C&P Engineering, LTD.**  
 Engineering • Planning • Surveying

1801 GATEWAY BLVD. - SUITE 101  
 RICHARDSON, TEXAS 75080  
 email: info@c-pengineering.com

DRAWN BY: DATE: SCALE: JOB NUMBER: SHEET: 05109-552  
 C&P 2/08 1"=40'-H 1"=4'-V 05109 24 of