



BENCH MARK: #1
BRASS CAP IN CL. OF MEDIAN NORTH ON LAKESHORE DRIVE NORTH OF THE INTERSECTION OF NORTH ALAMO AND LAKESHORE DRIVE.
ELEV. 524.78

BENCH MARK: #2
BRASS CAP IN CL. OF MEDIAN ON LAKESHORE DRIVE BETWEEN TO STREETS, STONEBROOK AND AMESBURY BRING NORTH OF HAVEN HILL.
ELEV. 518.83

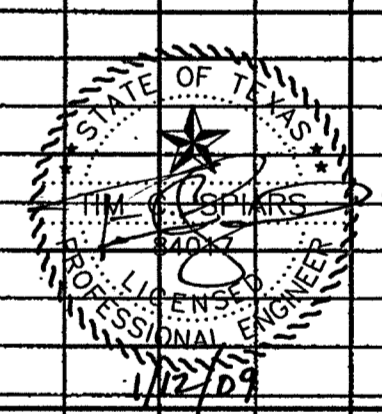

RECORD DRAWINGS

NOTE:
THESE PLANS HAVE BEEN REVISED TO CONFORM WITH CONSTRUCTION RECORDS PROVIDED TO SPIAS ENGINEERING, INC. BY CONTRACTOR AND CITY STAFF AFTER AS-BUILTS WERE ORIGINALLY SUBMITTED TO THE CITY OF ROCKWALL BY OTHERS. MODIFICATIONS TO PAVING, PAD AND UTILITY ELEVATIONS, AS REFLECTED ON THESE PLANS, WERE OBTAINED BY FIELD SURVEY PERFORMED IN DECEMBER, 2008.

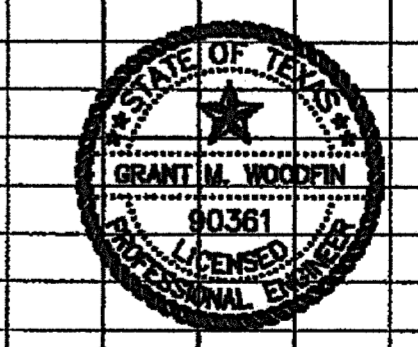

The Seal Appearing On This Document Was Authorized By
Grant M. Woodin
2/10/09

"AS BUILTS"
Information shown on these plans was furnished by the Contractor. All responsibility for the accuracy belongs to the Contractor.

LINE 'Q', 'P' & 'O'

SANITARY SEWER PROFILES
THE PRESERVE - PHASE 2
CITY OF ROCKWALL, TEXAS

C&P Engineering, LTD.
Engineering • Planning • Surveying
1801 GATEWAY BLVD., SUITE 101
RICHARDSON, TEXAS 75080
email: info@c-pengineering.com

DRAWN BY: C&P DATE: 2/06 SCALE: 1"=40'-11" JOB NUMBER: 05109 SHEET: 26 OF 26