
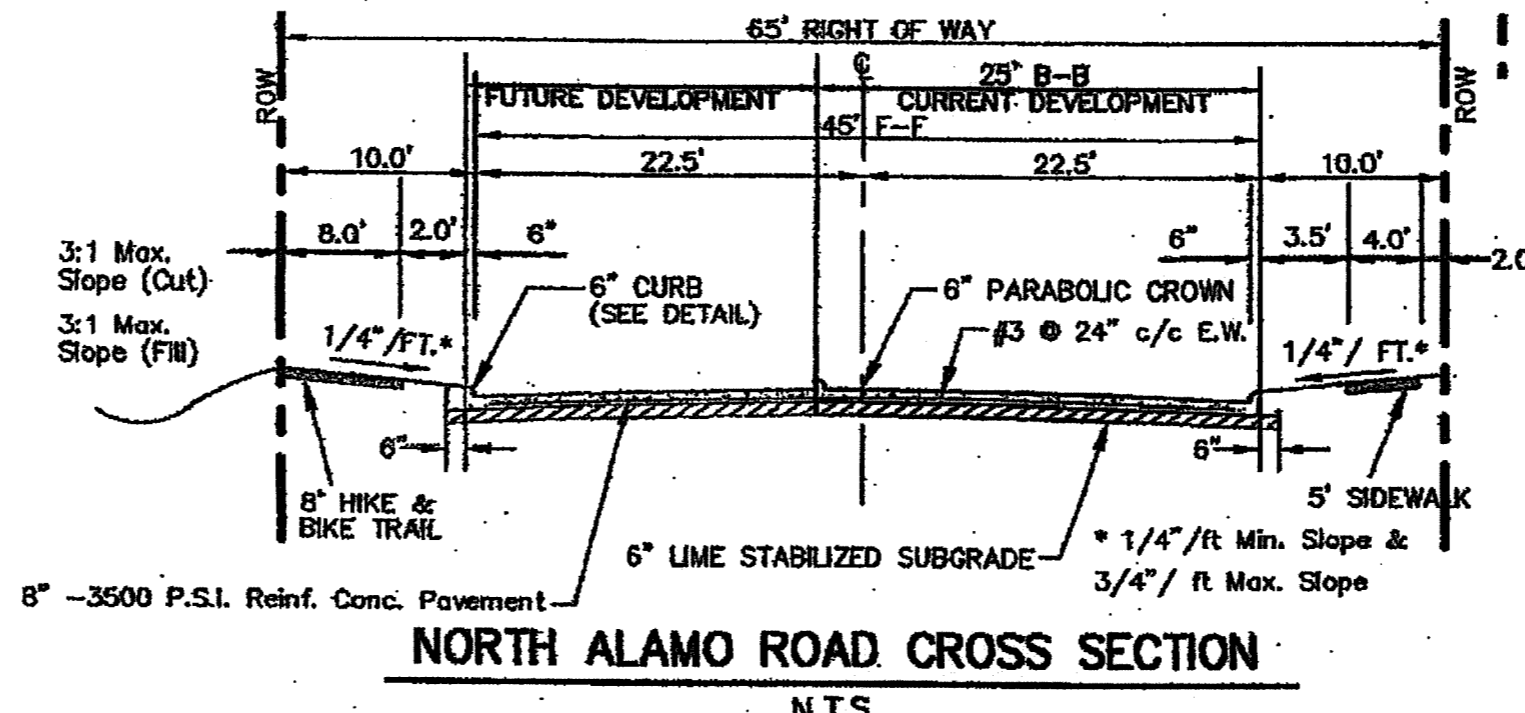


ASPHALT PAVEMENT SECTION

2" TYPE "D" FINE GRADED SURFACE COURSE
ITEM 334 PER TxDOT 1993 SPECIFICATIONS

4" TYPE "A" COARSE GRADED BASE COURSE
ITEM 334 PER TxDOT 1993 SPECIFICATIONS

6" LIME STABILIZED SUBGRADE
TO BE EXTENDED 2 FT. BEYOND EDGE OF PAVT.

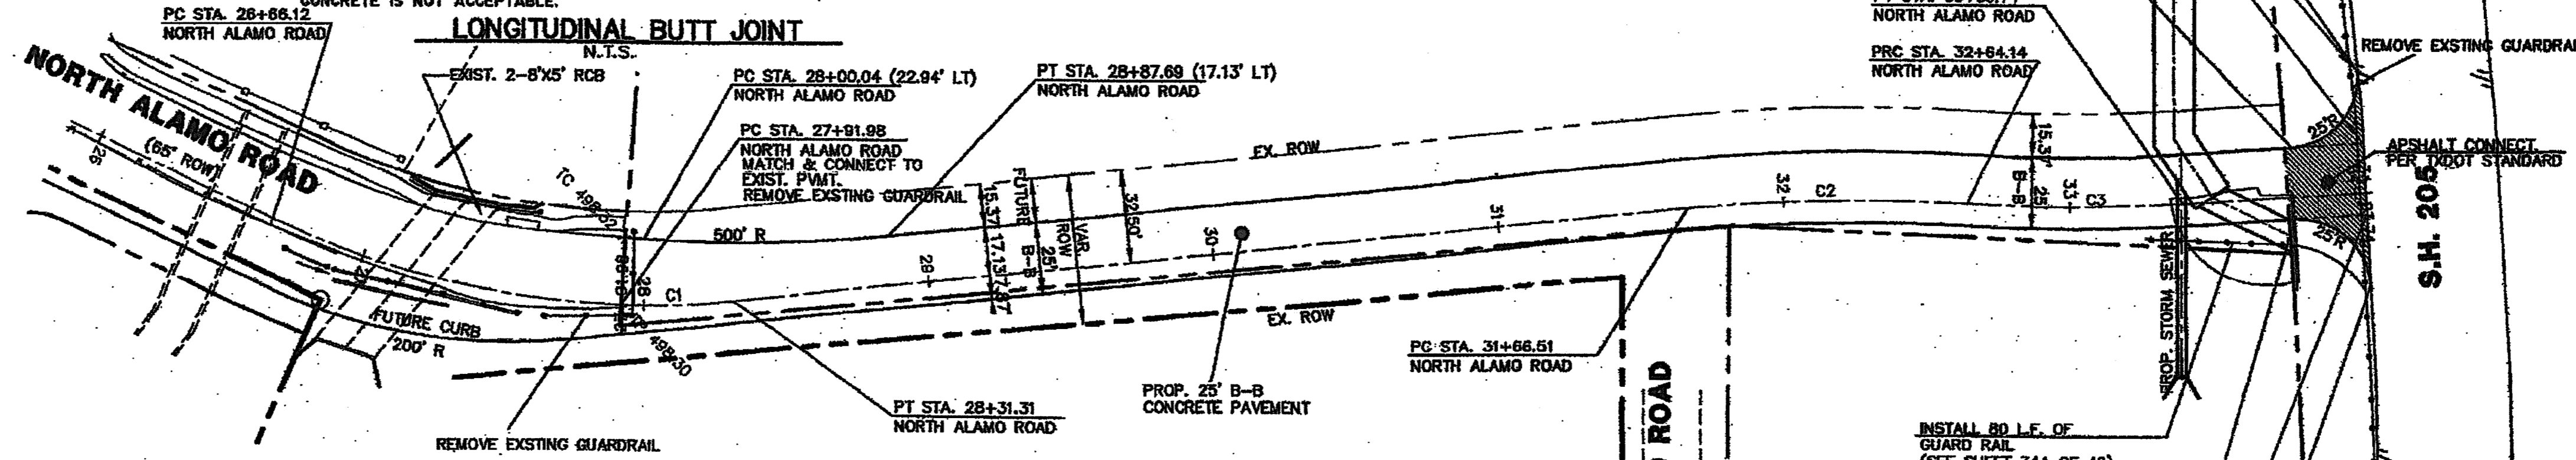

BENCHMARK:
CITY OF ROCKWALL CONTROL MONUMENT #R010 @ OF N. LAKESHORE DRIVE NORTH OF N. ALAMO IN MEDIAN ELEV. 524.79 (NAVD88)

BENCHMARK:
CITY OF ROCKWALL CONTROL MONUMENT #R011 @ OF N. LAKESHORE DR. NORTH OF N. HAVEN HILL CT. IN MEDIAN ELEV. 518.83 (NAVD88)


CURVE TABLE						
CURVE	LENGTH	RADIUS	DELTA	TANGENT	CHORD	BEARING
C1	39.33	300.00	7°30'39"	19.69	39.30	N67°46'13"E
C2	97.63	600.00	9°19'22"	48.92	97.52	S88°40'35"W
C3	75.59	600.00	7°13'07"	37.85	75.54	N89°43'43"E

NOTE:

- PAVEMENT FOR STREETS SHALL CONSIST OF 8" 3600 P.S.I. REINFORCED CONCRETE AND 6" LIME-STABILIZED SUBGRADE COMPACTED TO 95% PROCTOR WITH 7" PARABOLIC CROWN.
- CONTRACTOR TO RUN LIME SERIES BEFORE CONSTRUCTION.

LEGEND

TC	TOP OF CURB
TP	TOP OF PAVEMENT
CR	CURVE RETURN
FL	FLOW LINE
2	STREET STATION
⊕	HANDICAP RAMP @ STREET & STREET INTERSECTION
▨	EXIST. ASPHALT PAVT.
▩	EXIST. CONCRETE PAVT.

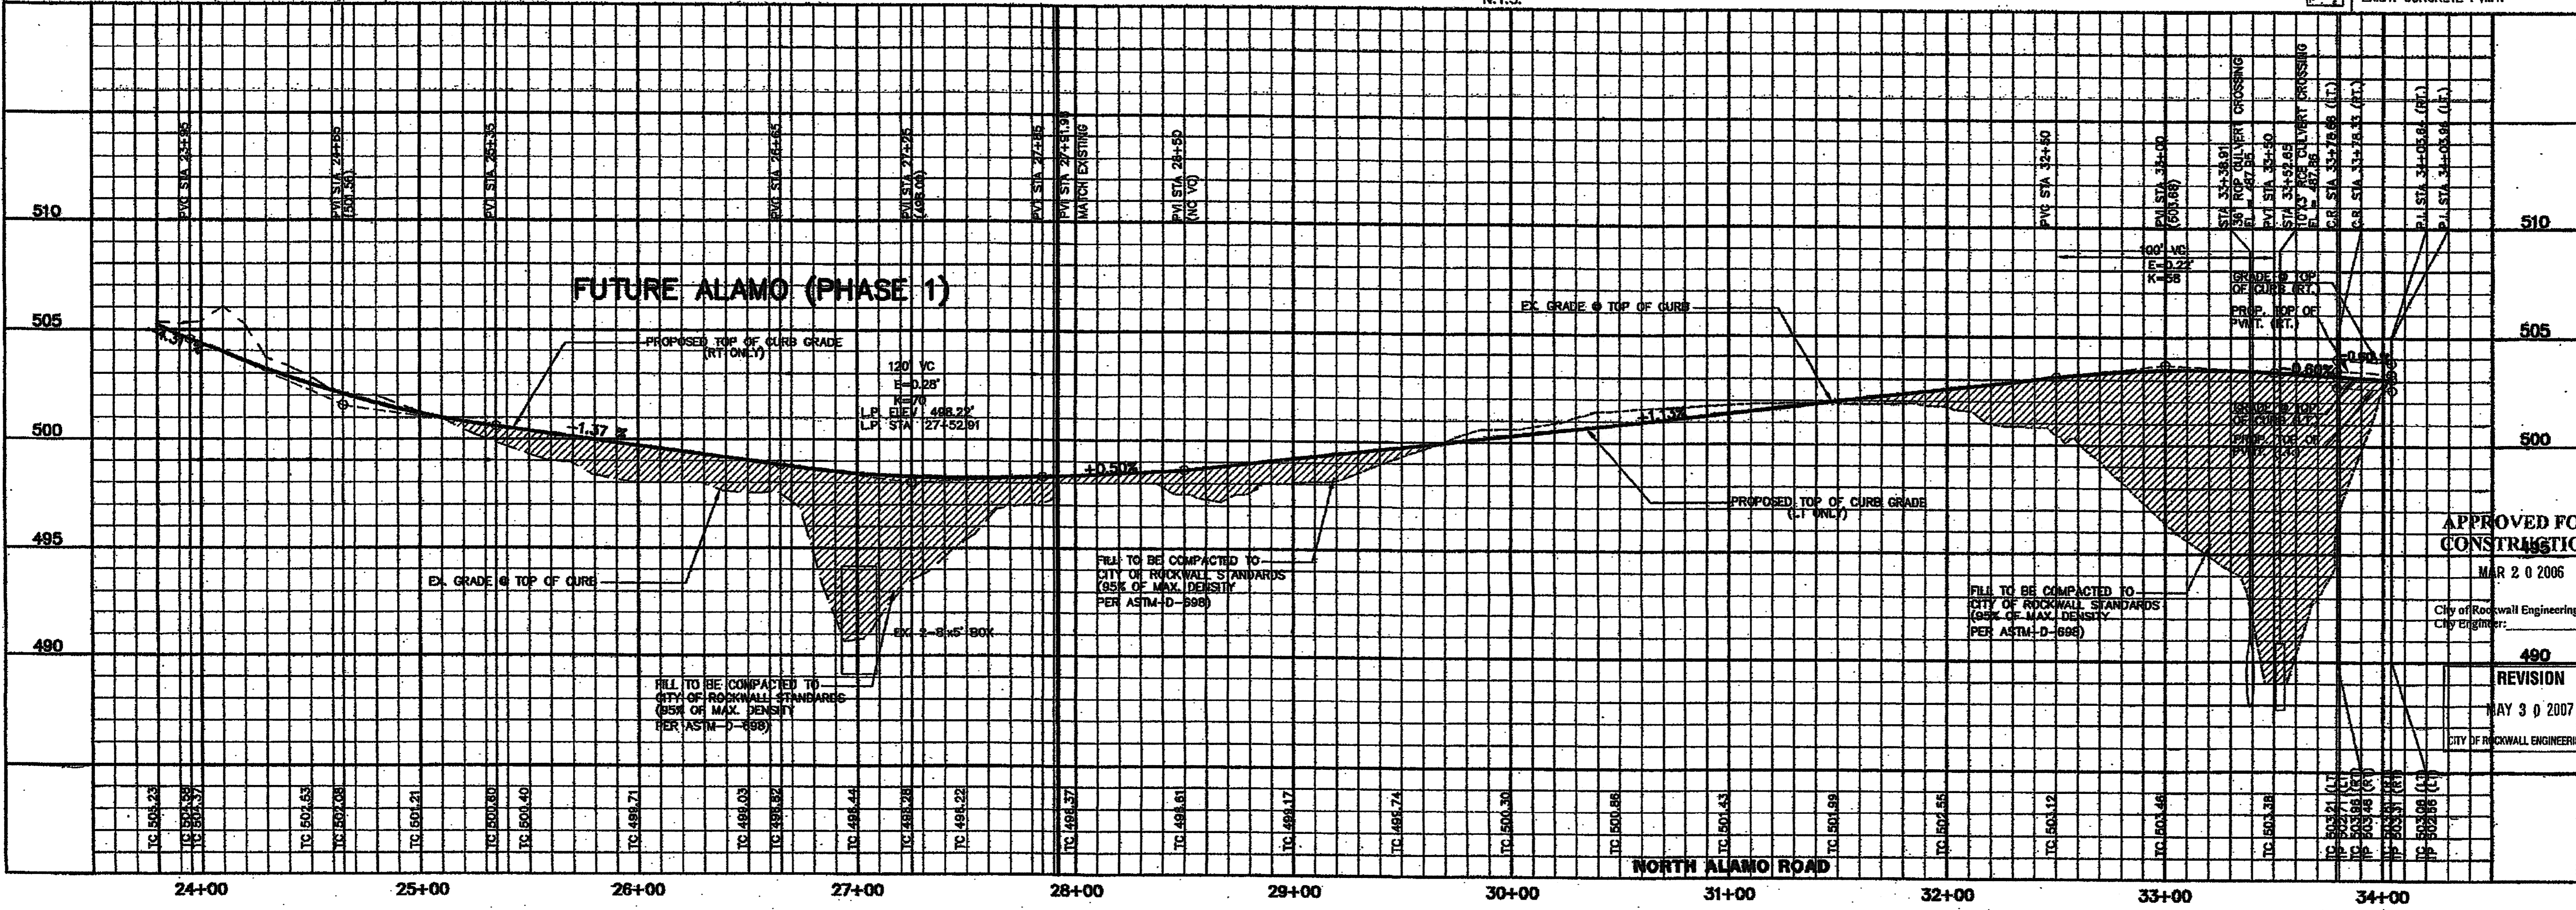

Winkelmann & Associates, Inc.
CONSULTING CIVIL ENGINEERS & SURVEYORS
505 VALLEY BLVD. SUITE 100
DALLAS, TEXAS 75240
(972) 342-7788 FAX

APPROVED FOR CONSTRUCTION
MAR 20 2006
City of Rockwall Engineering Dept.
City Engineer:

THESE CONSTRUCTION PLANS WERE PREPARED UNDER THE RESPONSIBLE SUPERVISION OF MD. NAIM UDDIN KHAN, REGISTERED PROFESSIONAL ENGINEER NO. 87776.

M.B. JONES SURVEY, ABSTRACT NO. 122
CITY OF ROCKWALL
ROCKWALL COUNTY, TEXAS
LUMBERMEN'S INVESTMENT CORPORATION
5485 BELLINE ROAD #225
DALLAS, TEXAS 75240

THE SEAL APPEARING ON THIS DOCUMENT WAS AUTHORIZED BY MD. NAIM UDDIN KHAN, P.E. #87776

PAVING PLAN & PROFILE
ALAMO DRIVE STA. 27+91.98 TO 34+03.99

REVISION

NO.	DATE	REVISION
1	MAY 30 2007	CITY OF ROCKWALL ENGINEERING DEPT.

Scale: 1" = 40'
Designed By: MB
Drawn By: MB
Checked By: NK
File: 40802P01A.dwg | View:
Project No.: 406020

SHEET
15
OF
46