


"AS BUILTS"
 Information shown on these plans was furnished by the Contractor. All responsibility for the accuracy belongs to the Contractor.

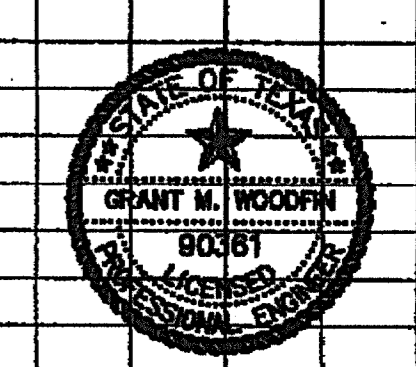

The Seal Appearing On This Document Was Authorized By
 Grant M. Hootner
 90001, on 4/16/07

PAVING PLAN & PROFILE
 ALLEY 'C'
 THE PRESERVE - PHASE 3
 CITY OF ROCKWALL, TEXAS

C&P Engineering, LTD.
 Engineering • Planning • Surveying
 1801 GATEWAY BLVD. - SUITE 101
 RICHARDSON, TEXAS 75080
 email: info@c-and-p-engineering.com

(972) 844-2800 OFC (972) 844-2817 FAX
 DRAWN BY: C&P DATE: 12/05 SCALE: 1"=40'-H 1"=4'-V JOB NUMBER: 05110 SHEET: 0511D-A11 OF 20