


**DRAINAGE TABLE**

AREA	ACRES	C	I <sub>100</sub>	Q <sub>100</sub>
1	0.75	.50	9.8	3.68
2	1.37	.50	9.8	6.71
2A	1.05	.50	9.8	5.15
3	2.35	.50	9.8	11.52
3A	0.21	.50	9.8	1.03
4	0.18	.50	9.8	0.88
5	1.99	.50	9.8	9.75
6	0.59	.50	9.8	2.89
7	1.60	.50	9.8	7.84
8	0.35	.50	9.8	1.72
9	0.31	.50	9.8	1.52
10	1.70	.50	9.8	8.33
11	3.12	.50	9.8	15.29
12	0.65	.50	9.8	3.19
13	0.55	.50	9.8	2.70
14	0.70	.50	9.8	3.43
15	0.06	.50	9.8	0.29
16	0.65	.50	9.8	3.18
17	0.38	.50	9.8	1.86
18	0.33	.50	9.8	1.61
19	0.87	.50	9.8	4.26
20	0.77	.50	9.8	3.77
21	2.72	.50	9.8	13.32
22	1.30	.50	9.8	6.37
23	0.98	.50	9.8	4.80
24	1.74	.50	9.8	8.52
25	1.30	.50	9.8	6.37
26	0.31	.50	9.8	1.52
27	0.81	.50	9.8	3.97
28	1.28	.50	9.8	7.00
28A	0.82	.50	9.8	4.02
29	1.18	.50	9.8	5.78
29A	0.32	.50	9.8	1.57
30	0.59	.50	9.8	2.89
31	0.37	.50	9.8	1.81
32	22.60	.50	9.8	110.74
33	38.04	.50	9.8	186.49
34	27.84	.50	9.8	136.42
35	0.45	.50	9.8	2.21
36	1.69	.50	9.8	8.28
37	2.10	.50	9.8	10.29
37A	0.53	.50	9.8	2.60
38	2.33	.50	9.8	11.41
39	1.28	.50	9.8	6.27
40	0.32	.50	9.8	1.56
41	0.70	.50	9.8	3.43
42	0.83	.50	9.8	4.06
43	0.73	.50	9.8	3.58
44	1.34	.50	9.8	6.57
45	1.34	.50	9.8	6.57
46	5.01	.50	9.8	24.55
47	1.03	.50	9.8	5.05
48	18.00	.50	9.8	88.20


LOT 1A  
DEDICATED TO CITY  
FOR LIFT STATION

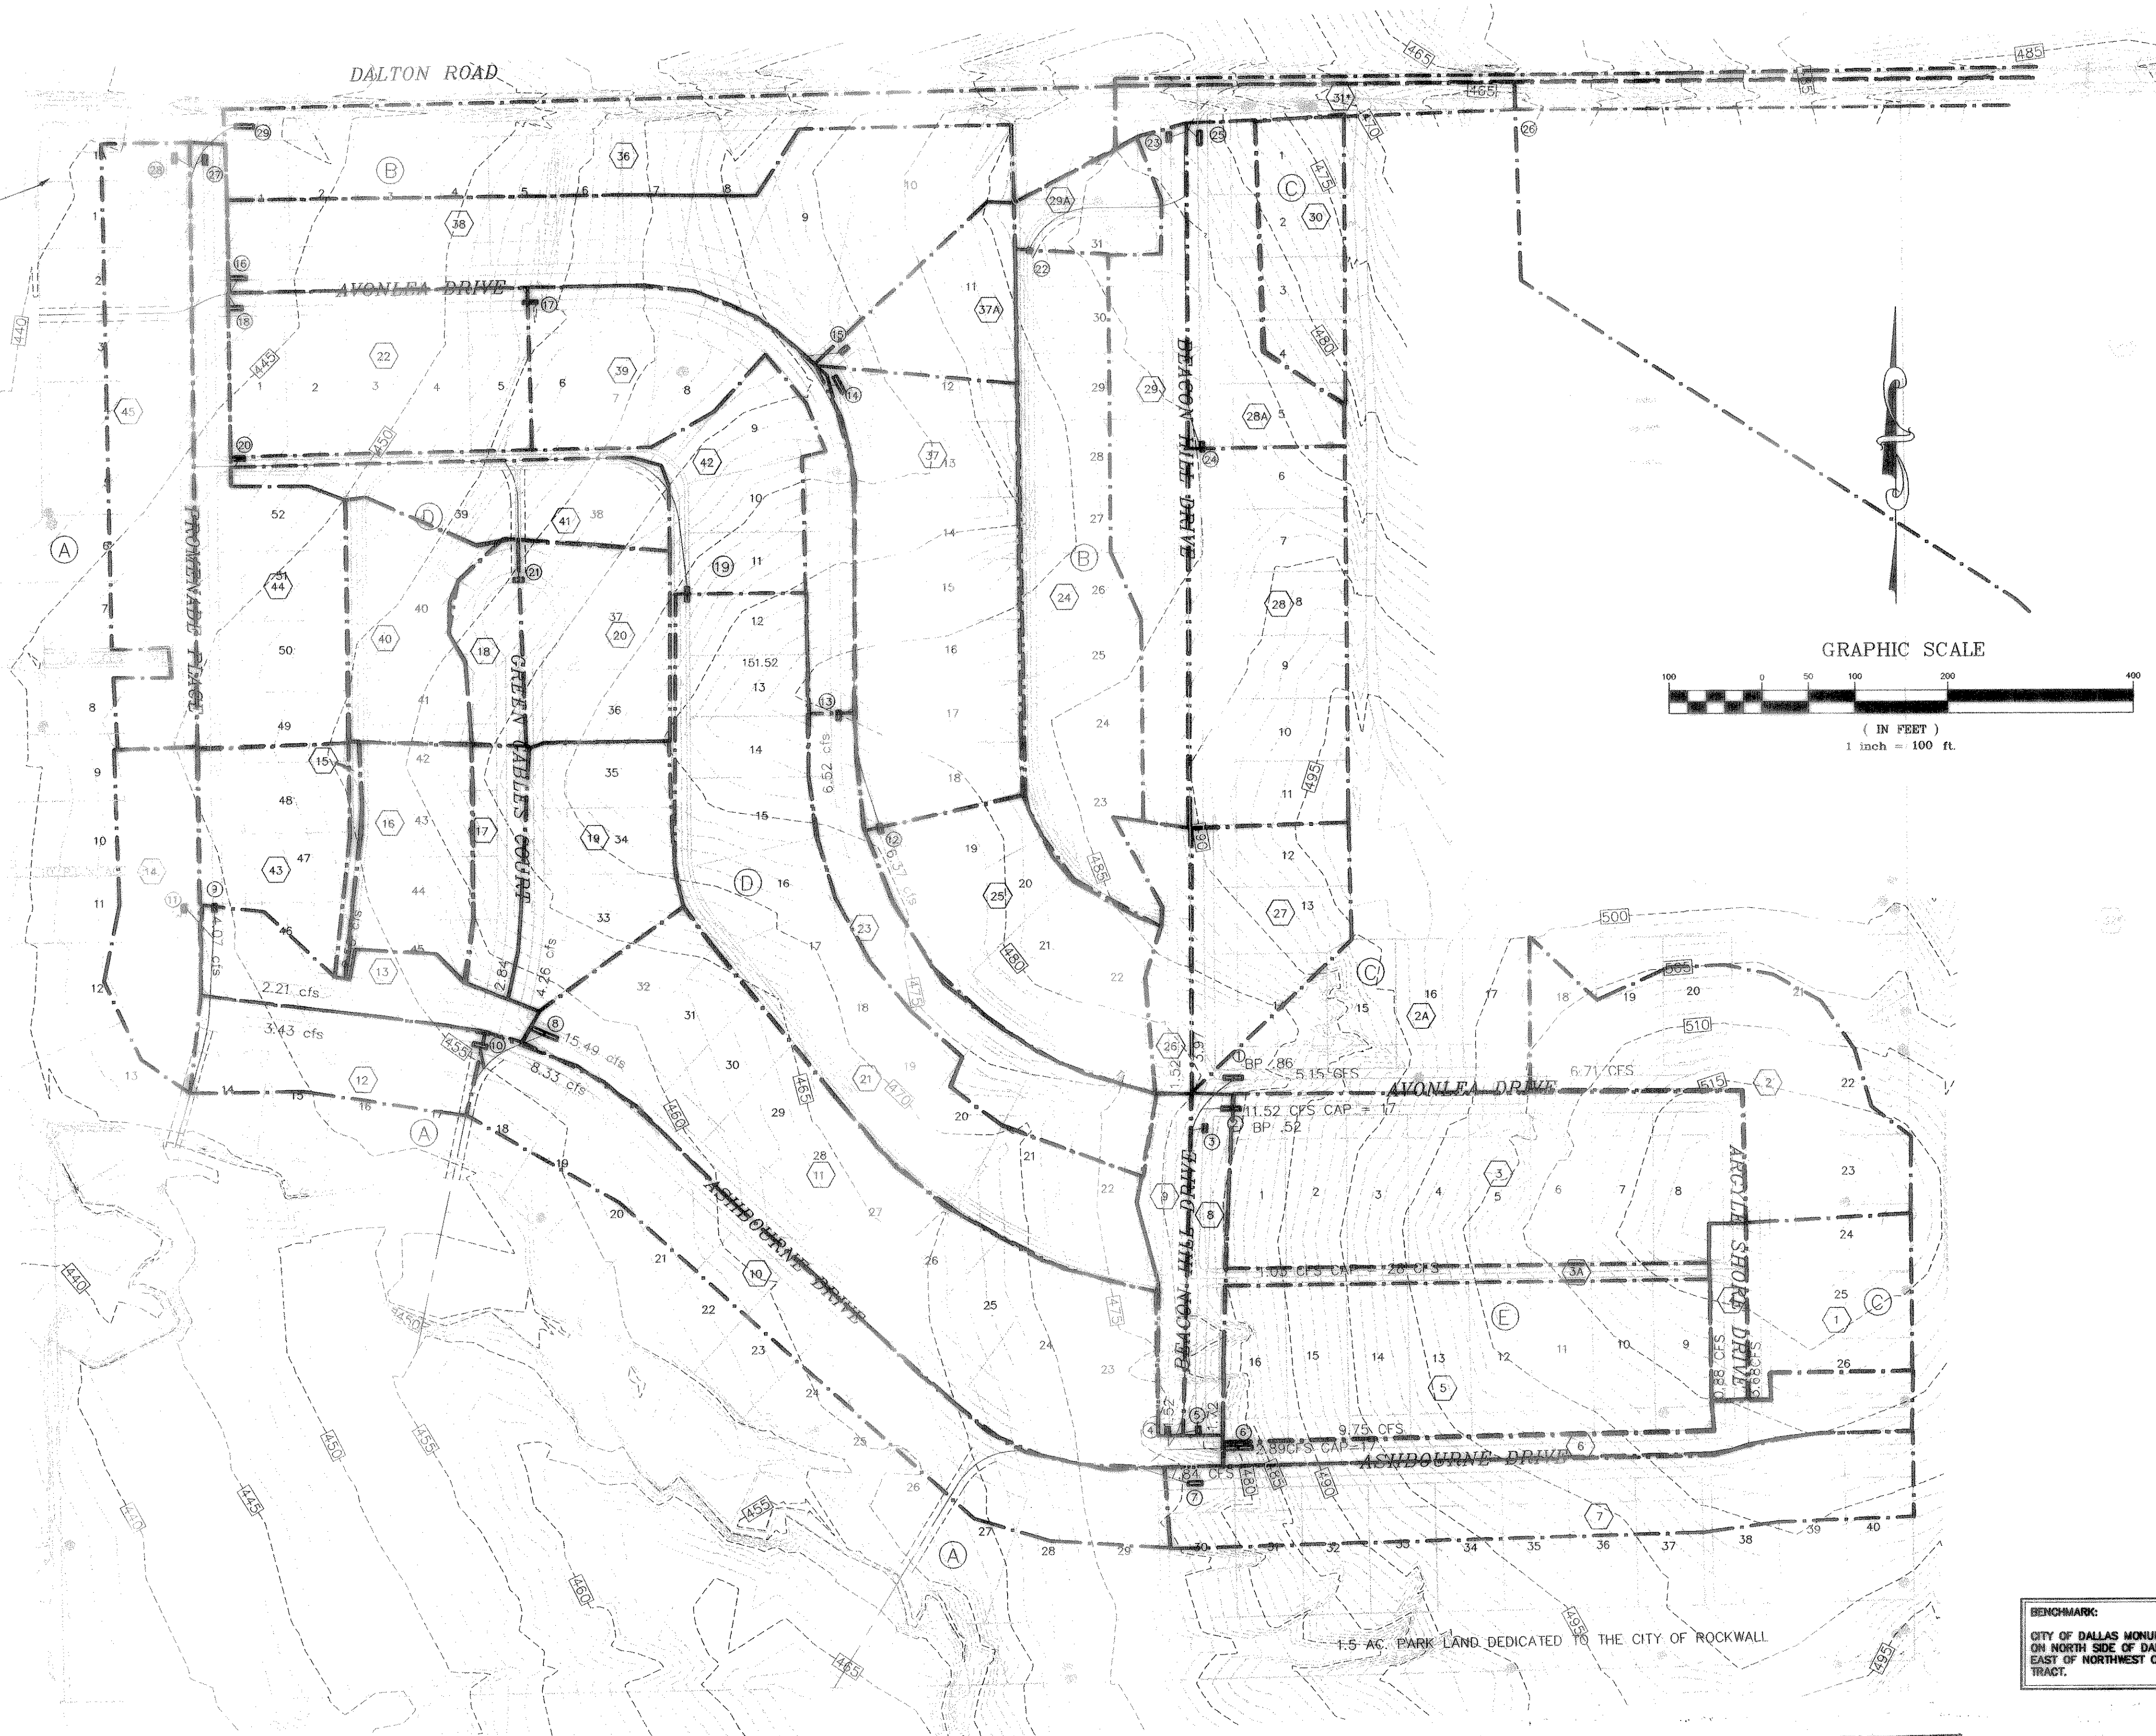

REVISED TO CONFORM TO CONSTRUCTION RECORDS.  
DATE: 11/25/02

BENCHMARK:  
CITY OF DALLAS MONUMENT NO. EEBID  
ON NORTH SIDE OF DALTON ROAD 685'±  
EAST OF NORTHWEST CORNER OF THIS  
TRACT. ELEV=463.08

# OFFSITE DRAINAGE

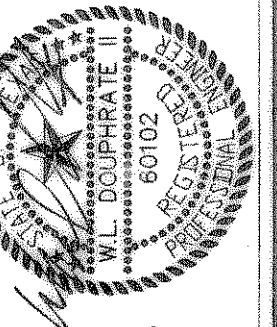

THE SEAL APPEARING ON THIS DOCUMENT WAS AUTHORIZED BY W.L. DOUPHRATE, INC. LICENSE NO. 60102 ON 12/27/04

**DOUPHRATE & ASSOCIATES, INC.**  
ENGINEERING - PROJECT MANAGEMENT - SURVEYING  
2235 RIDGE RD., # 200 ROCKWALL, TEXAS 75087  
PHONE: (972)771-9004 FAX: (972)771-9005

DRAINAGE AREA PLAN  
PROMENADE HARBOR  
CITY OF ROCKWALL  
ROCKWALL COUNTY, TEXAS

REVISION
W.L.D.
CHECKED
K.E.B.
DRAWN
7/01
DATE
0050DAM
PROJECT