


DOUPHRA  
 & ASSOCIATES, INC.  
 ENGINEERS - PROJECT MANAGEMENT - SURVEYING  
 2235 RIDGE RD., # 200 ROCKWALL, TEXAS 75087  
 PHONE: (972)771-9004 FAX: (972)771-9005


PAVING PLAN & PROFILE  
 ALLEY B  
 PROMENADE HARBOR  
 CITY OF ROCKWALL, ROCKWALL COUNTY, TEXAS

REVISION  
 W.L.D.  
 CHECKED  
 K.E.B.  
 DRAWN  
 9/01  
 DATE  
 0050PV12  
 PROJECT

20  
 OF

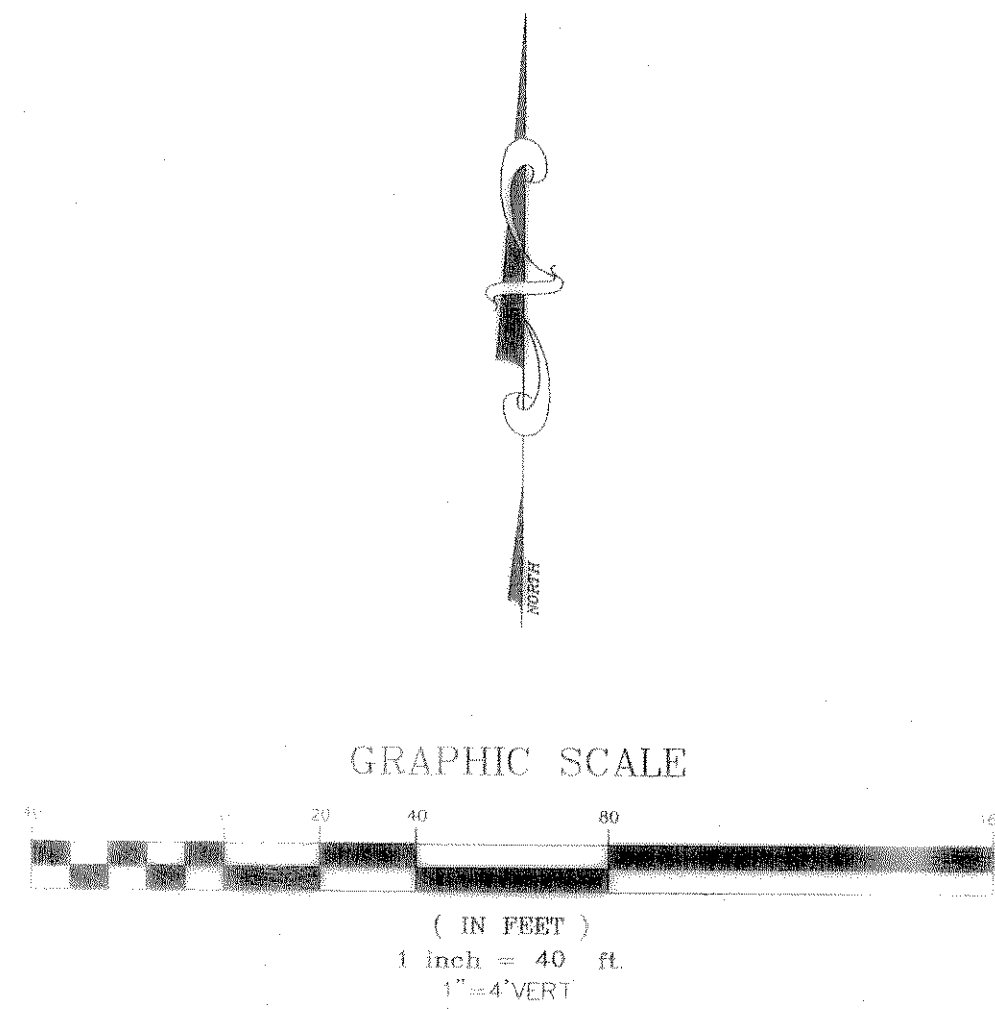


STA: 0+00  
 STA: 2+31.97

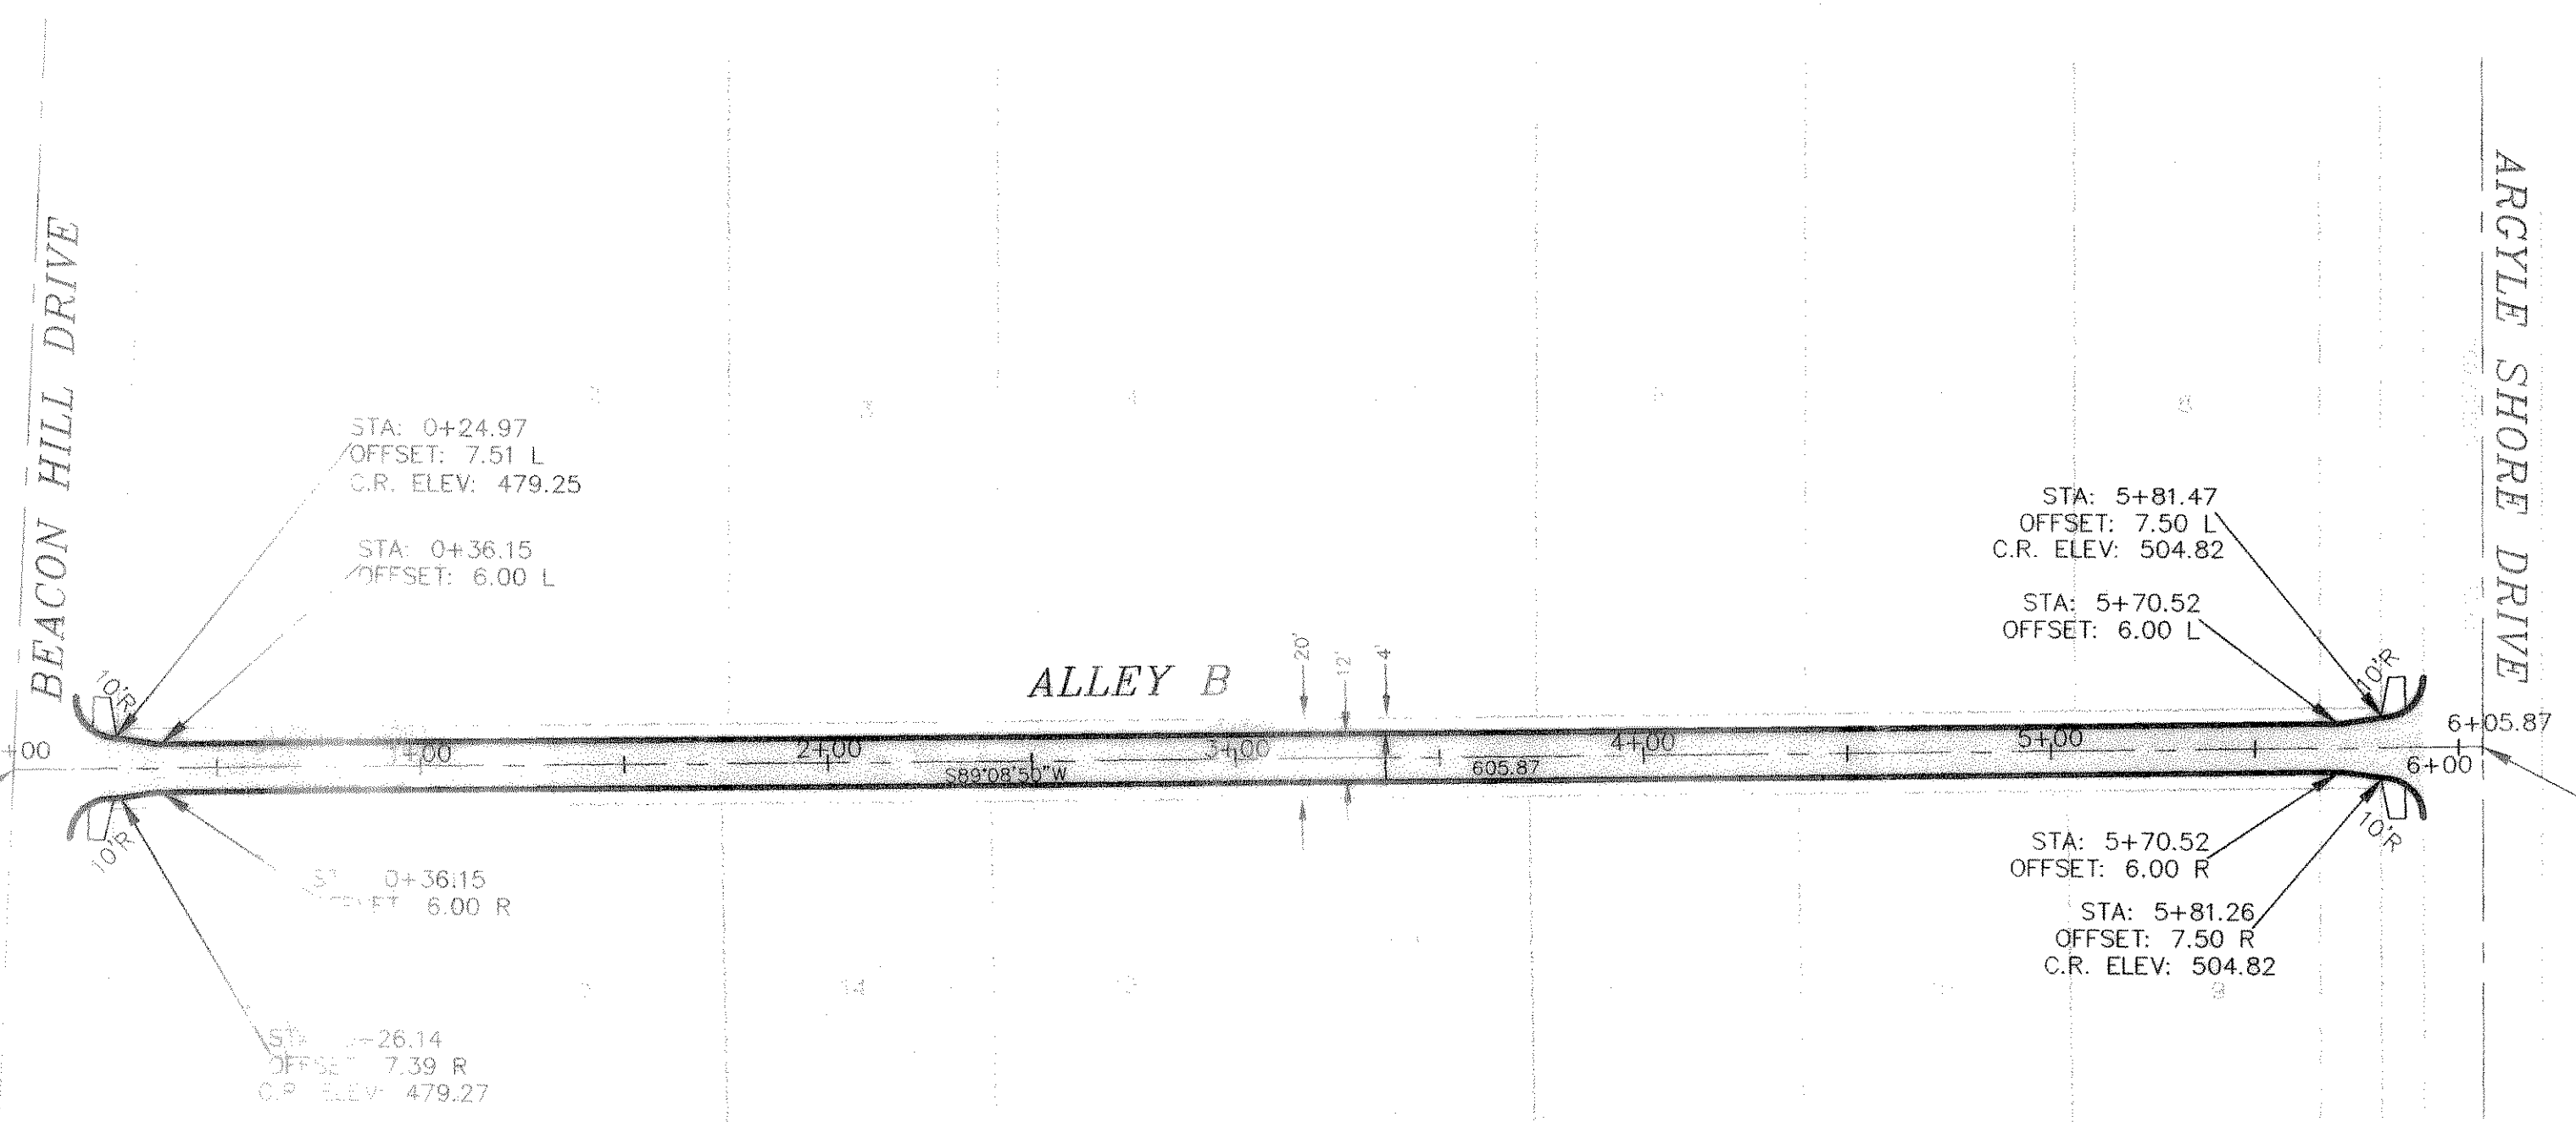

STA: 6+05.87 ALLEY "B"  
 STA: 24+71.25 ARGYLE SHORE DR.

BENCHMARK:  
 CITY OF DALLAS MONUMENT NO. EE81D  
 ON NORTH SIDE OF DALTON ROAD 685'±  
 EAST OF NORTHWEST CORNER OF THIS  
 TRACT. ELEV=463.08

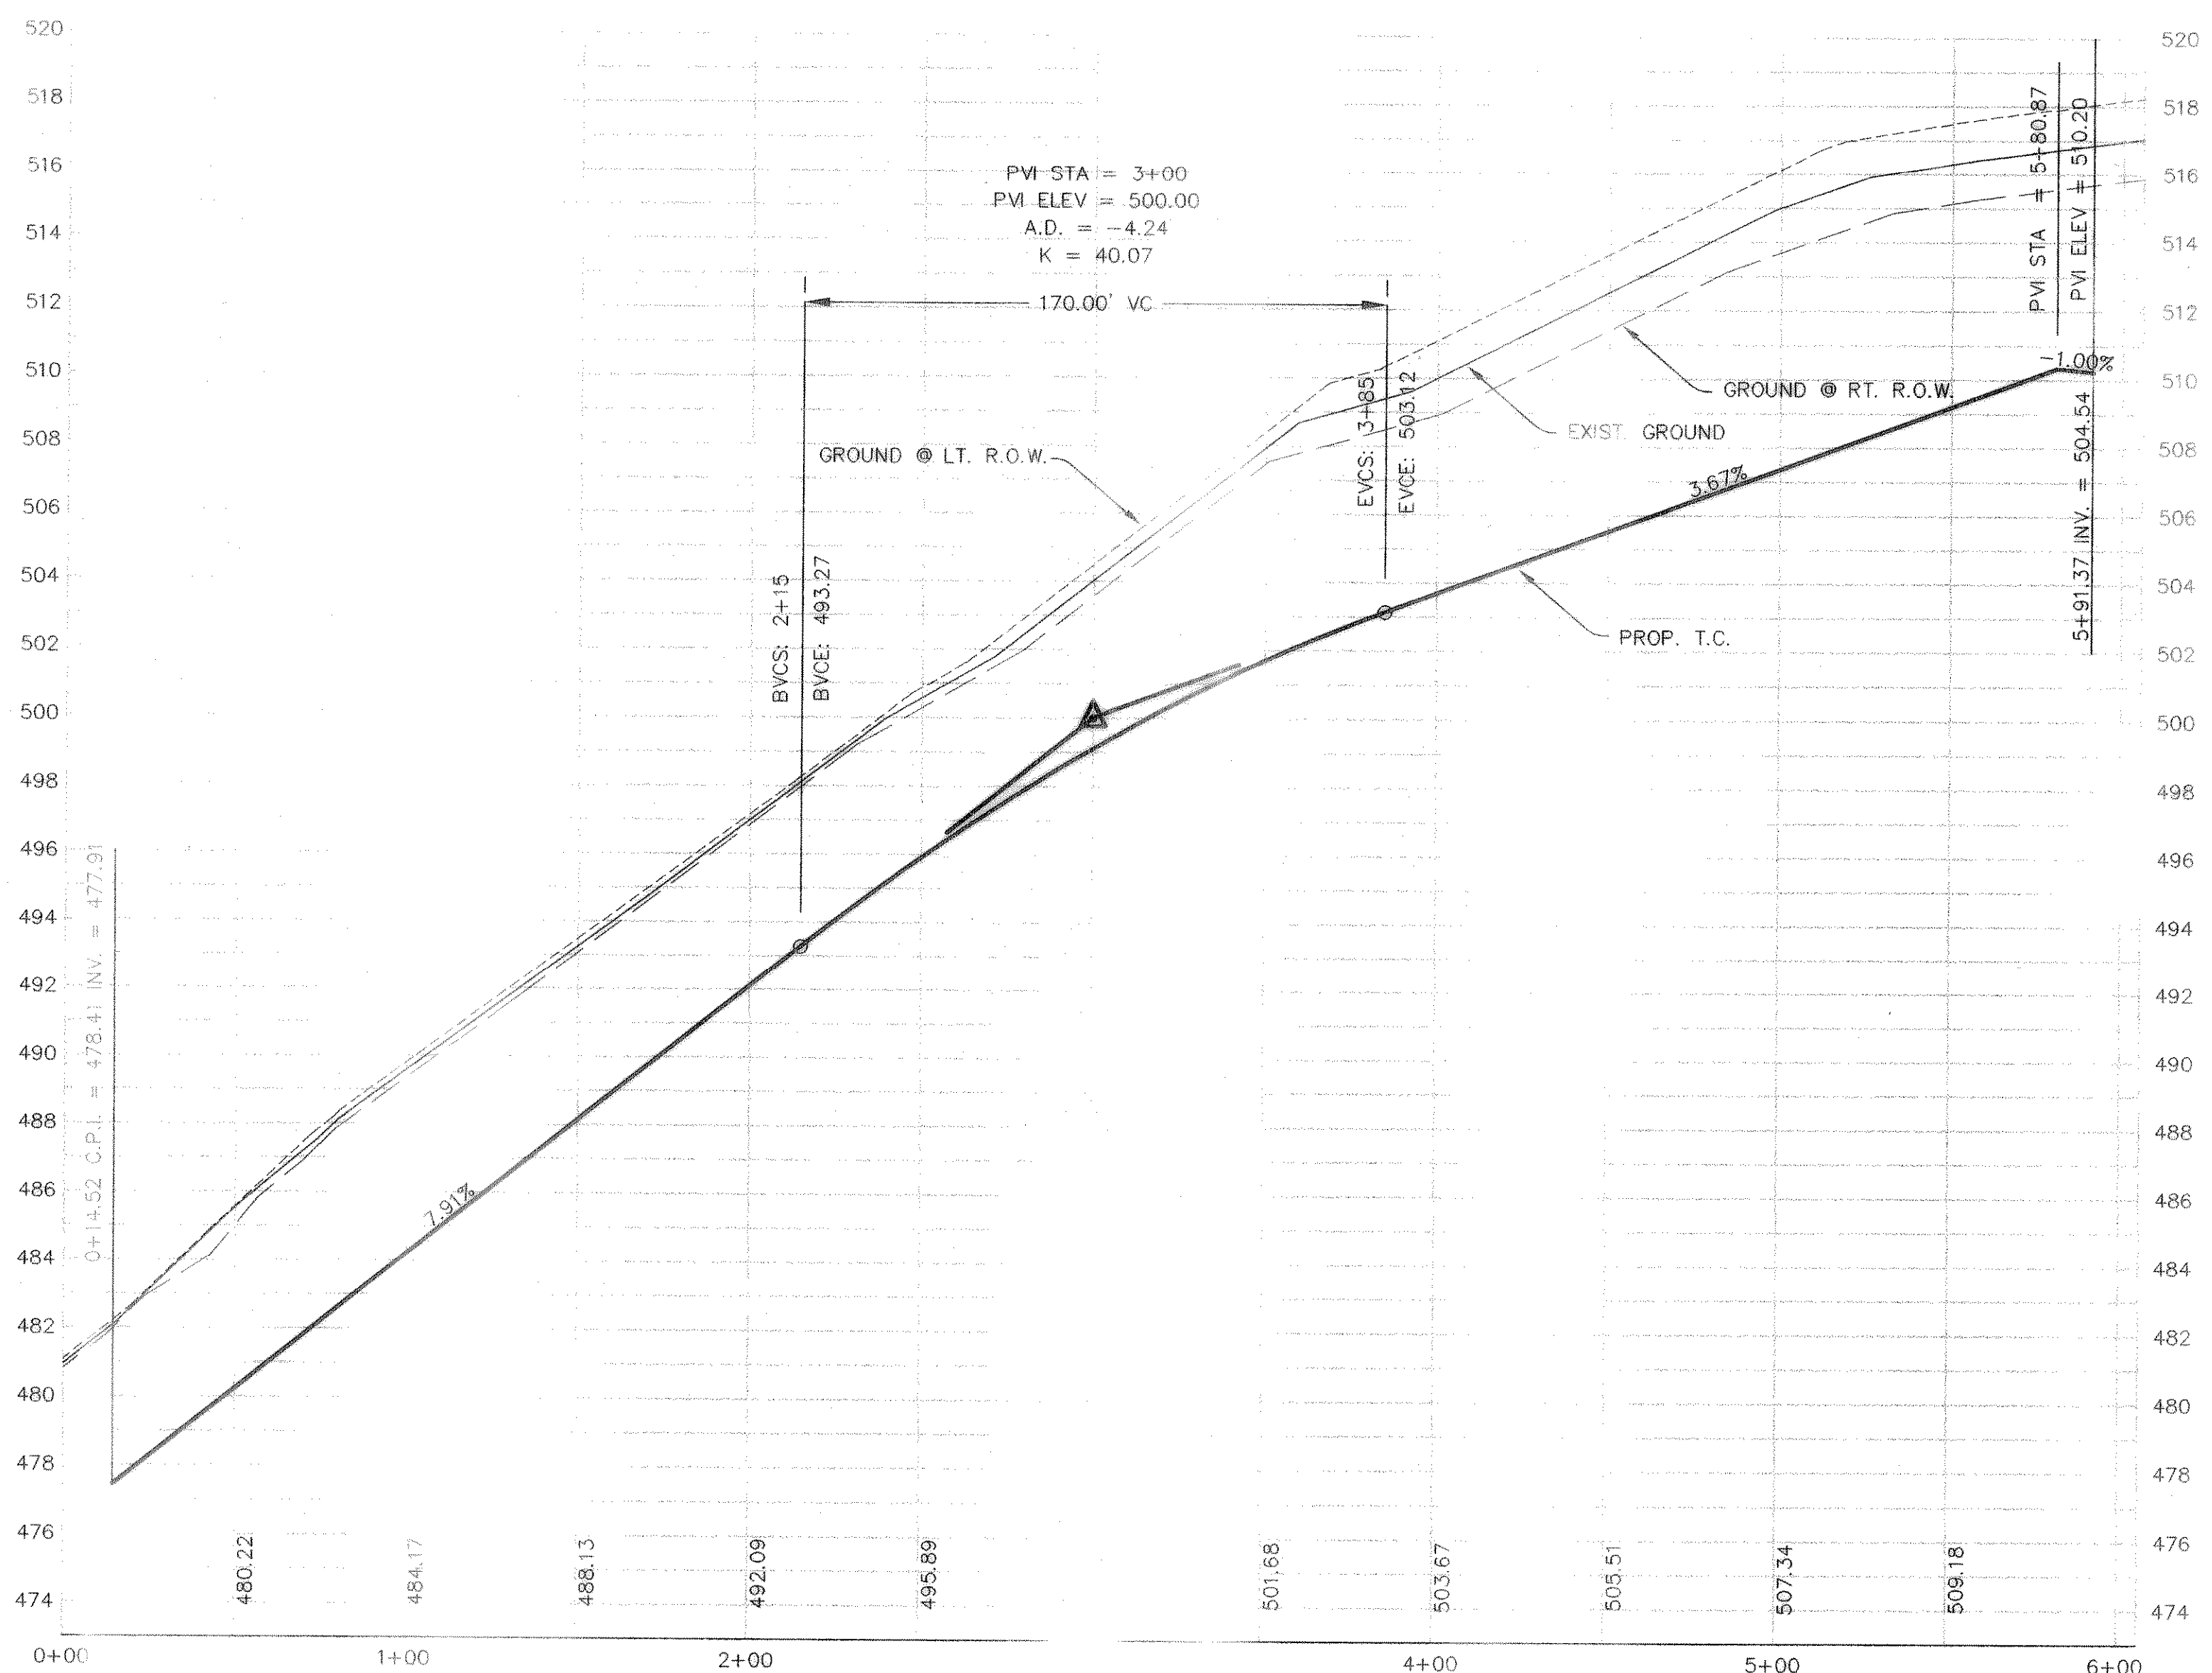

REVISED TO CONFORM TO CONSTRUCTION RECORDS.  
 [Signature] DATE: 11/25/02