
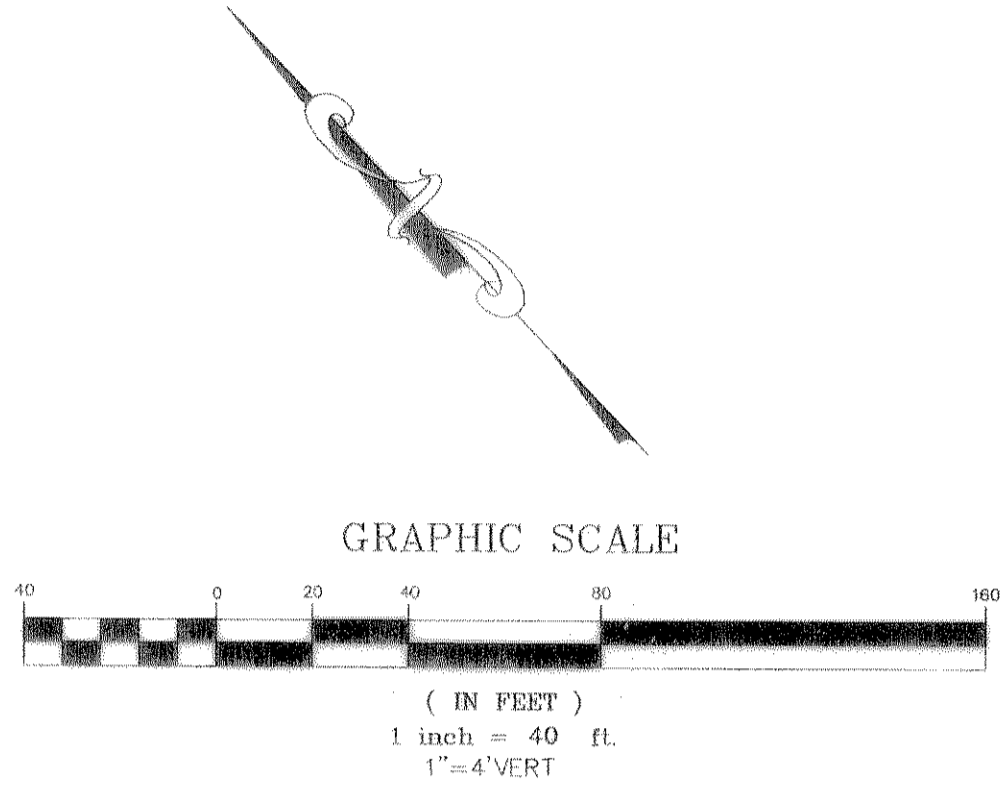


THE SEAL APPEARING ON THIS DOCUMENT WAS AUTHORIZED BY W.L. DOUPHRATE II TEXAS P.E. NO. 60102 ON 12/28/01


DOUPHRATE & ASSOCIATES, INC.
ENGINEERING • PROJECT MANAGEMENT • SURVEYING
2235 RIDGE RD., # 200 ROCKWALL, TEXAS 75087
PHONE: (972)771-9004 FAX: (972)771-9005

PAVING PLAN & PROFILE
ALLEY A
PROMENADE HARBOR
CITY OF ROCKWALL, ROCKWALL COUNTY, TEXAS

REVISION
W.L.D. CHECKED
K.E.B. DRAWN
6/01 DATE
0050PV14 PROJECT
22 OF

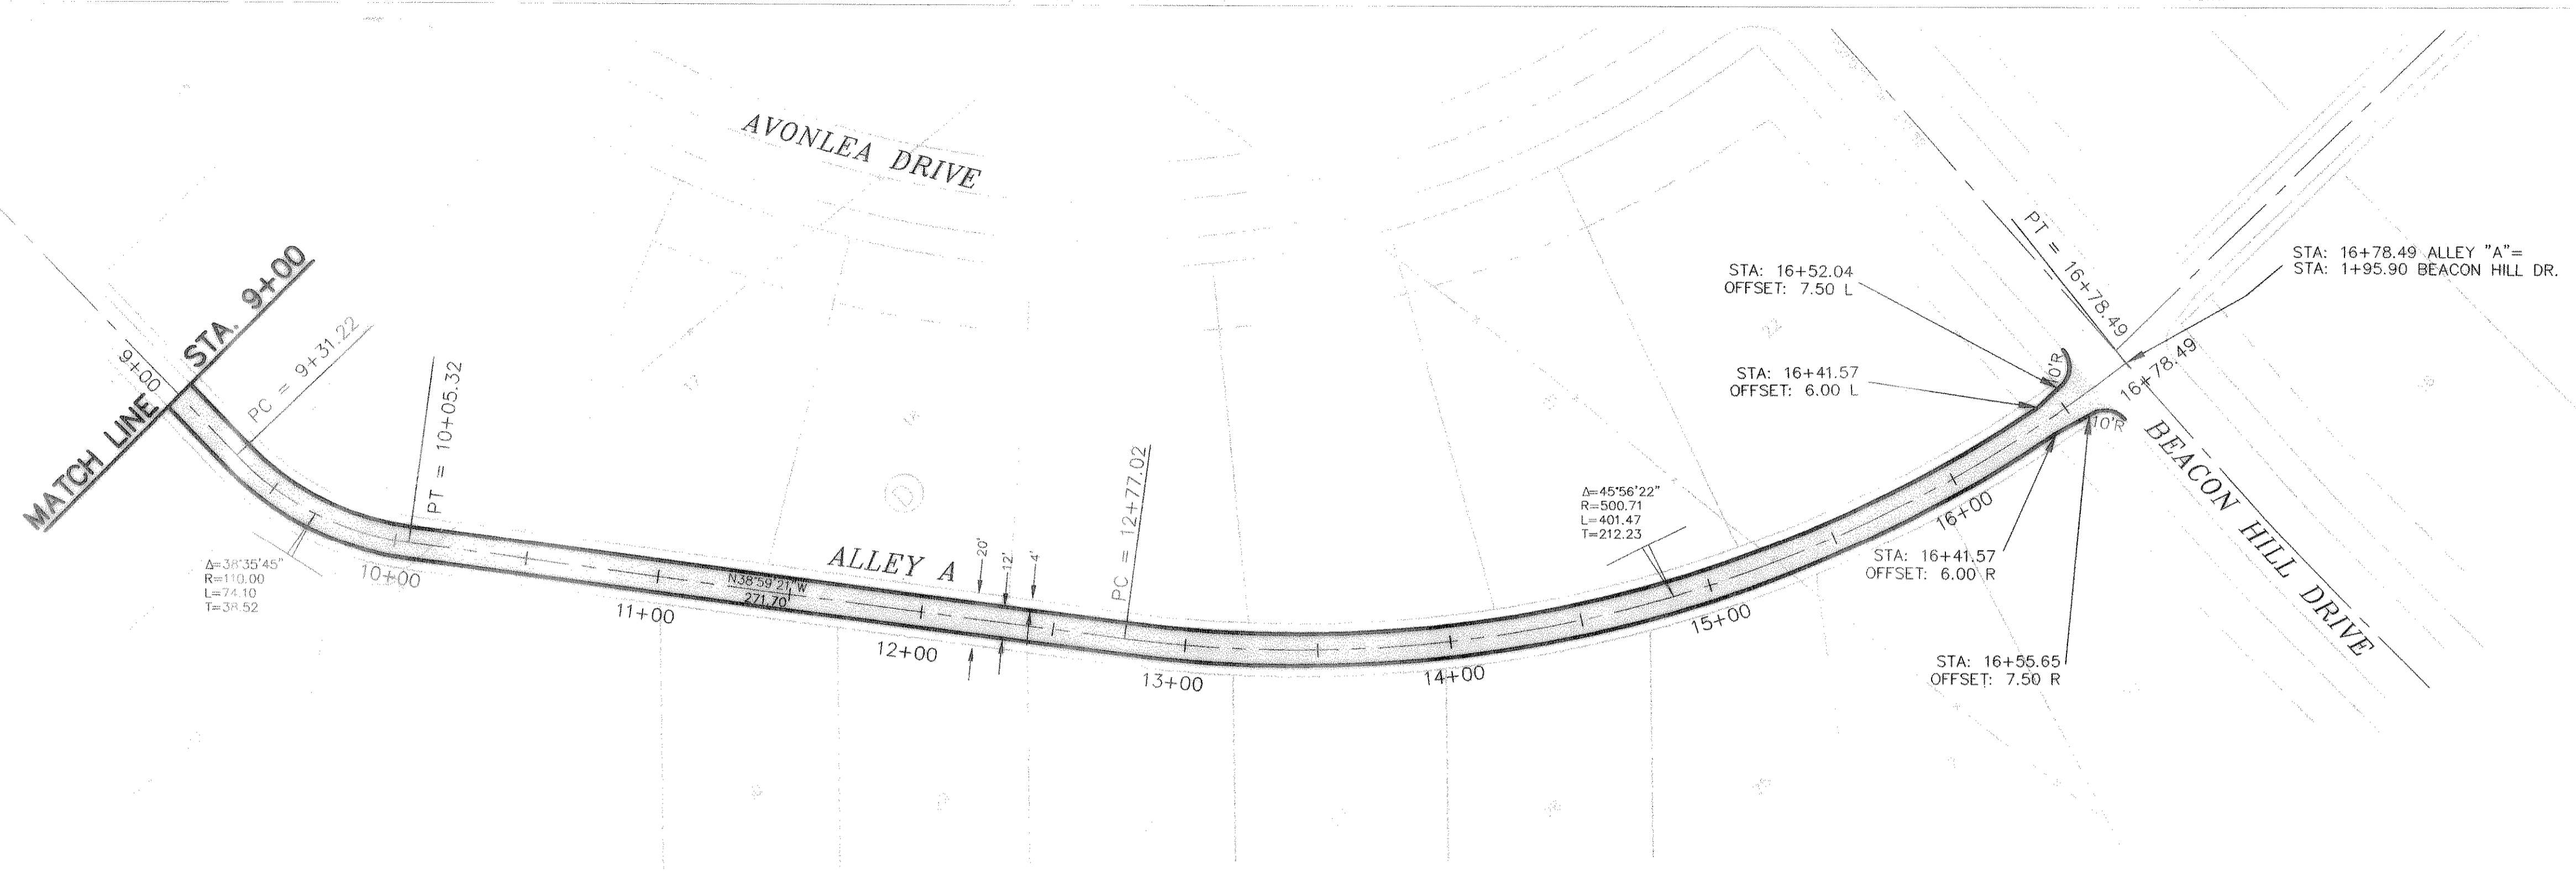

BENCHMARK:
 CITY OF DALLAS MONUMENT NO. EE81D
 ON NORTH SIDE OF DALTON ROAD 685'±
 EAST OF NORTHWEST CORNER OF THIS
 TRACT. ELEV=463.08

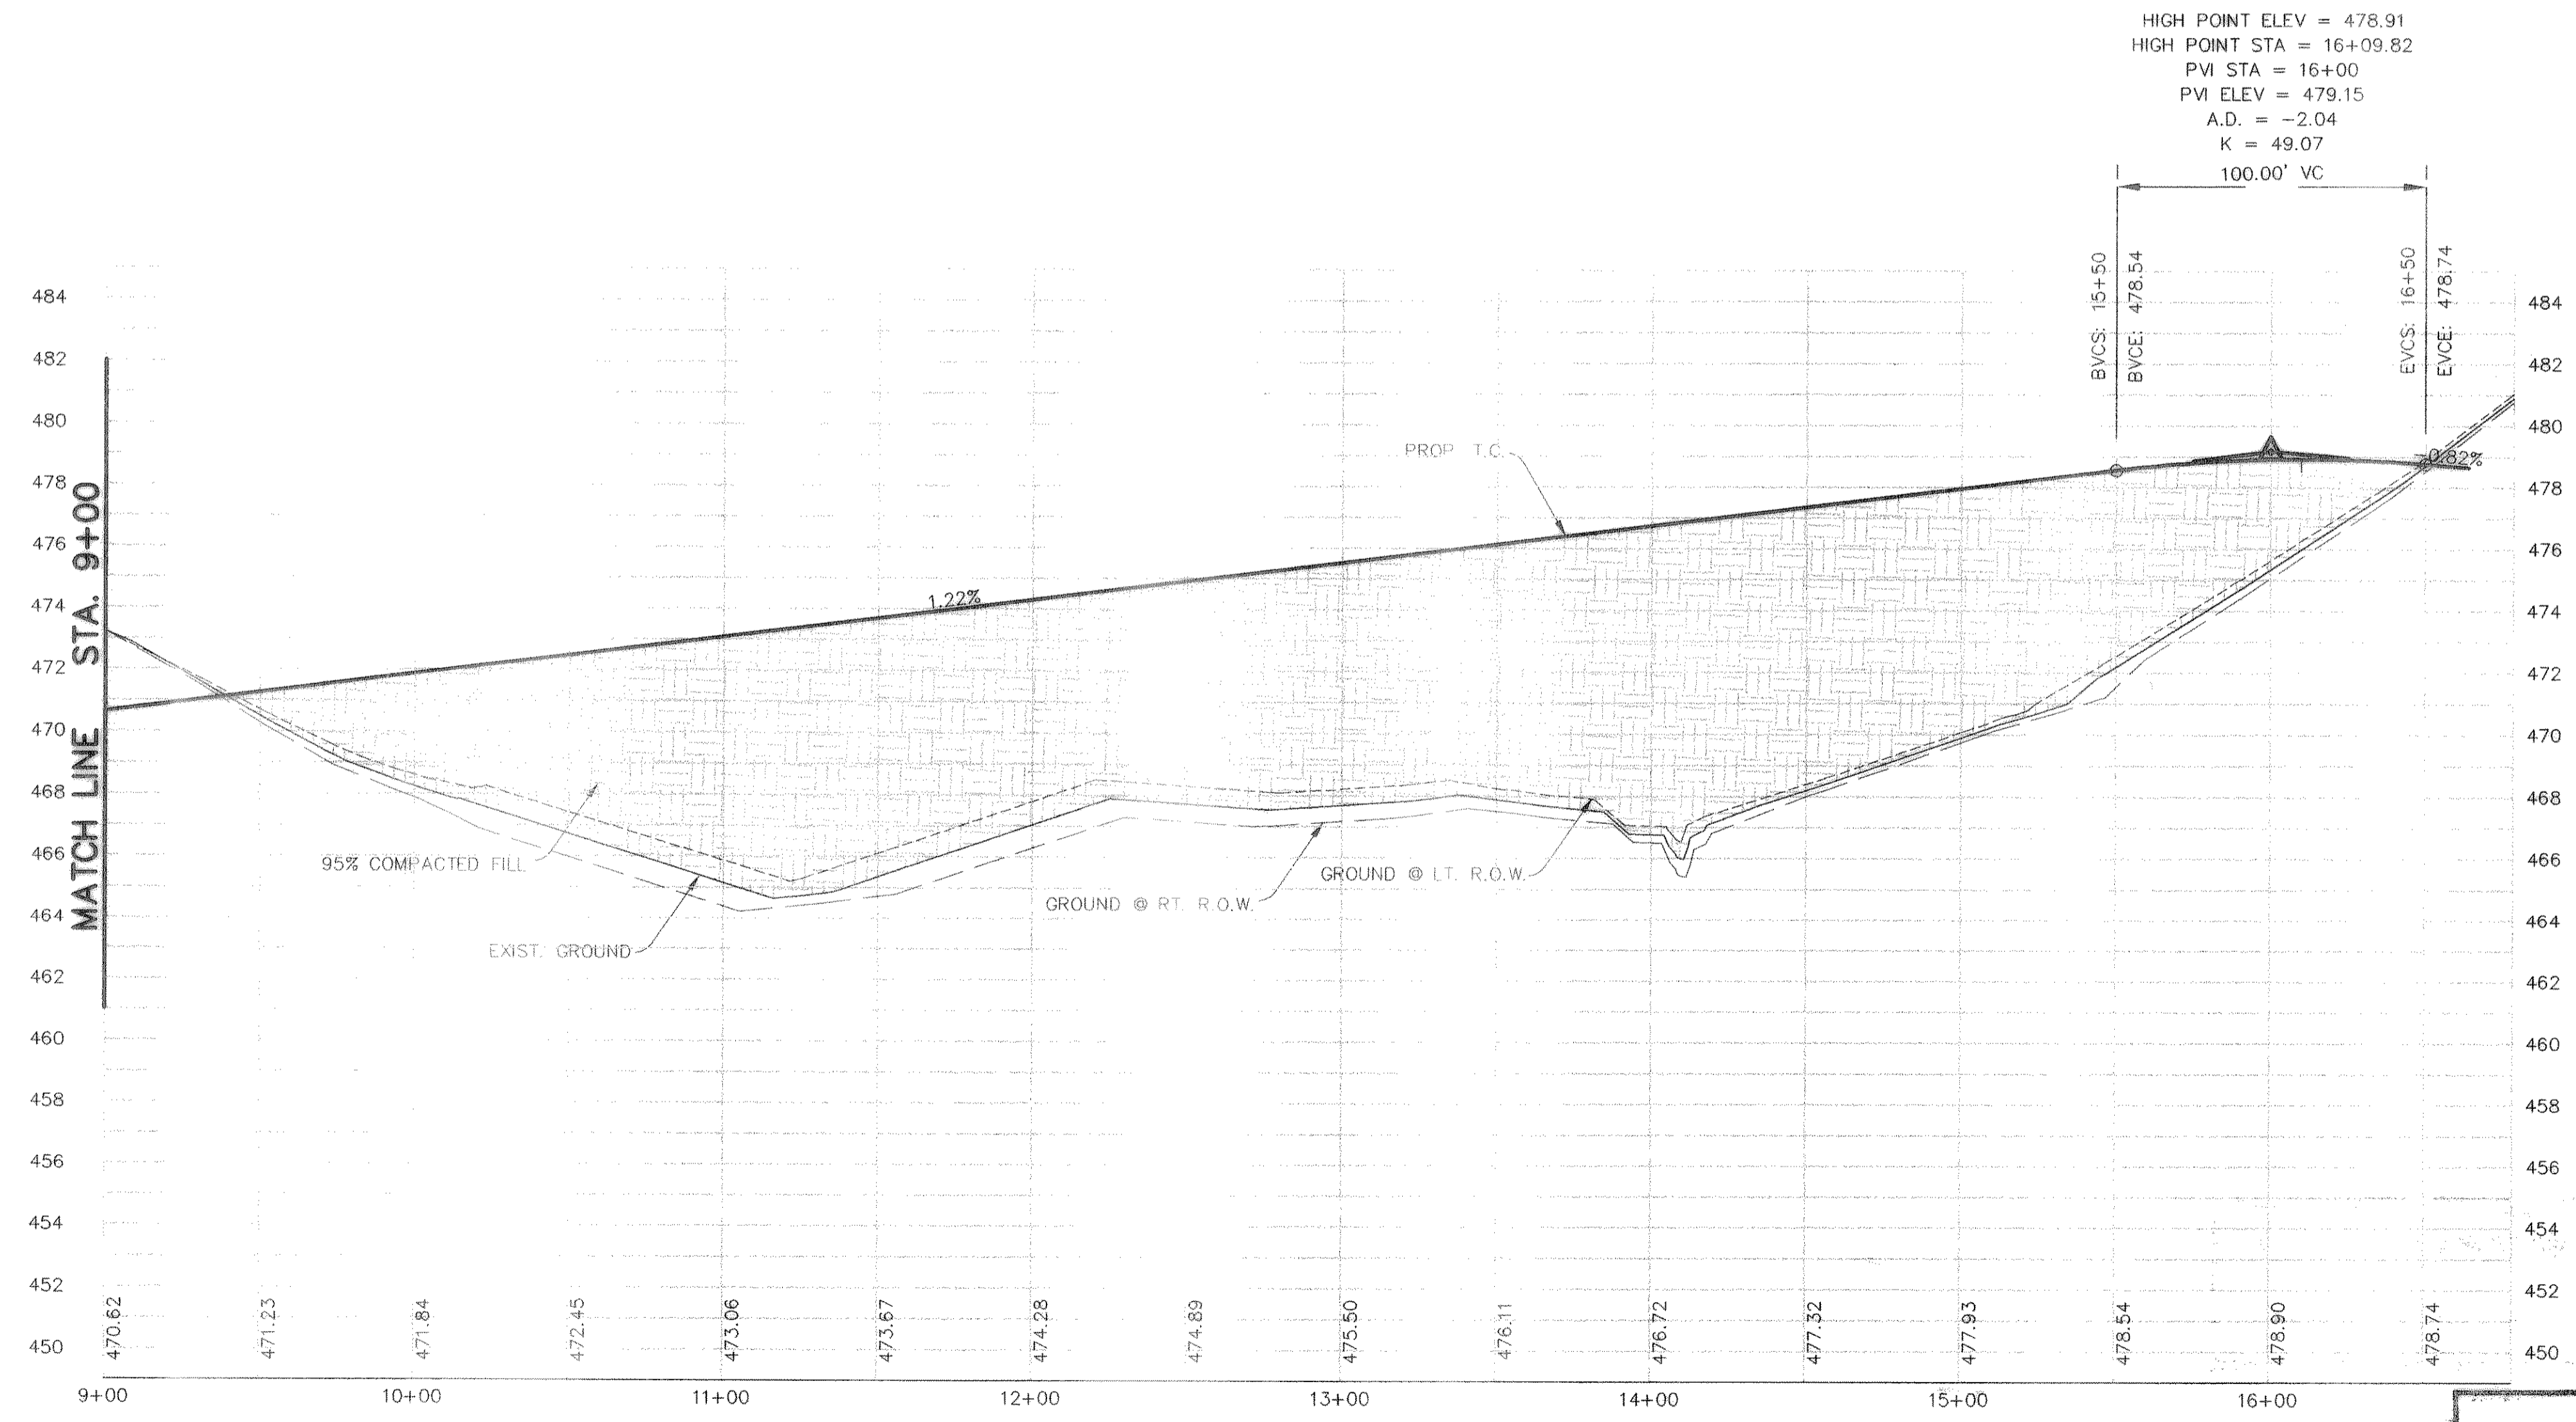

REVISED TO CONFORM TO CONSTRUCTION RECORDS.
 DATE: 11/27/02