
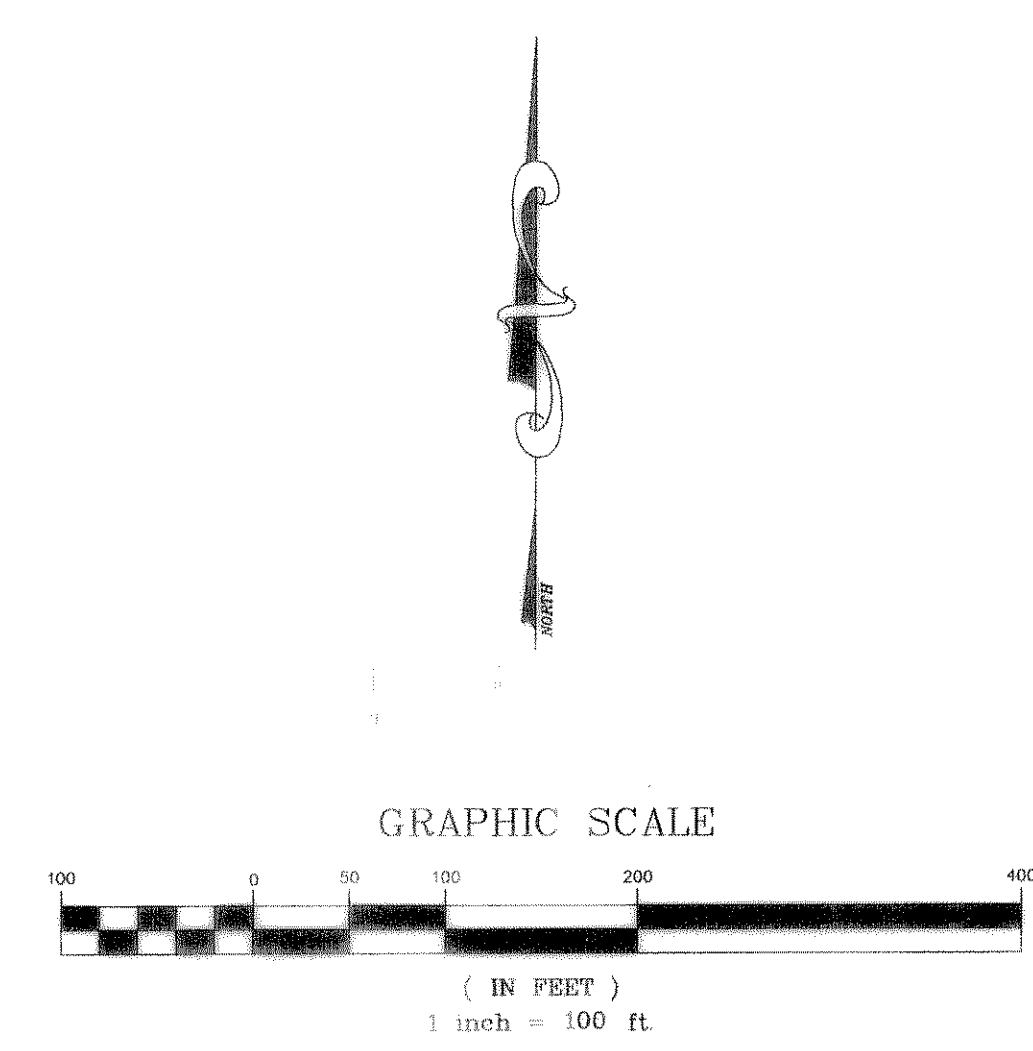




THE SEAL APPEARING ON THIS DOCUMENT WAS AUTHORIZED BY W.L. DOUPHRA TE II NO. 60102 ON 12/6/01

DOUPHRA TE & ASSOCIATES, INC.
 ENGINEERING • PROJECT MANAGEMENT • SURVEYING
 2235 RIDGE RD., # 200 ROCKWALL, TEXAS 75087
 PHONE: (972)771-9004 FAX: (972)771-9005

SANITARY SEWER PLAN
PROMENADE HARBOR
 CITY OF ROCKWALL
 ROCKWALL COUNTY, TEXAS

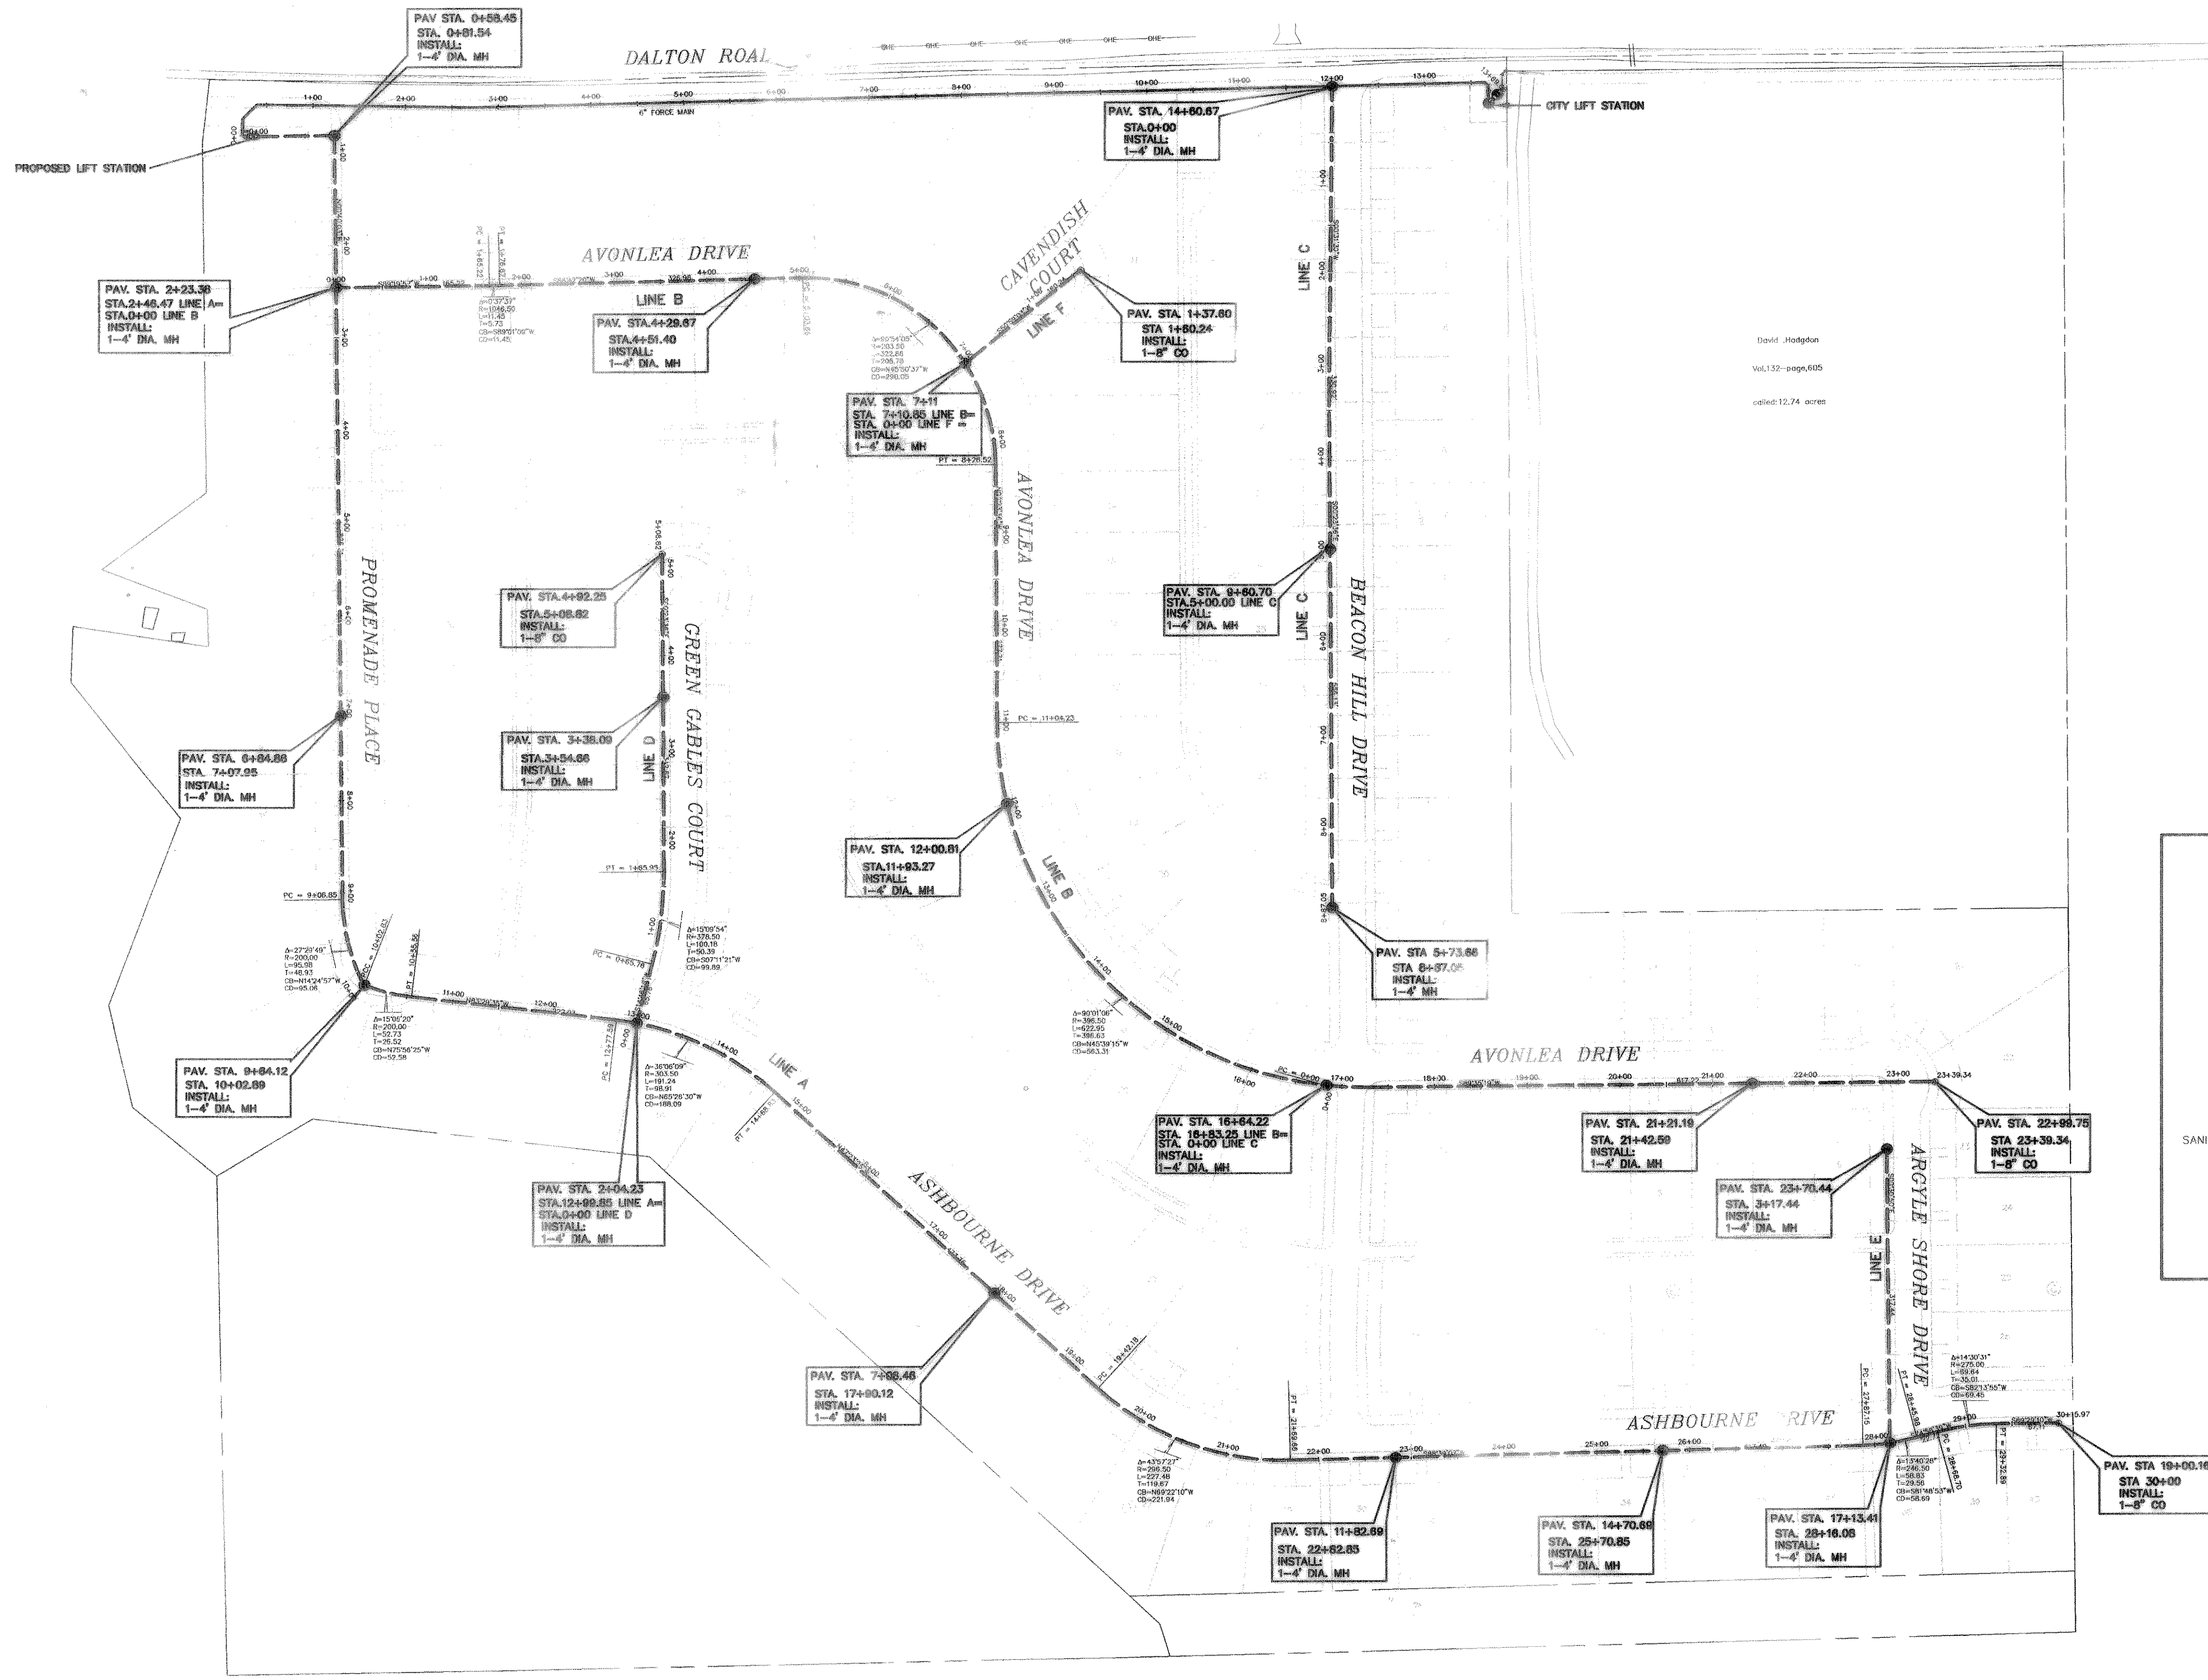

TYPICAL 4" SEWER SERVICE
 TYPICAL WATER SERVICE

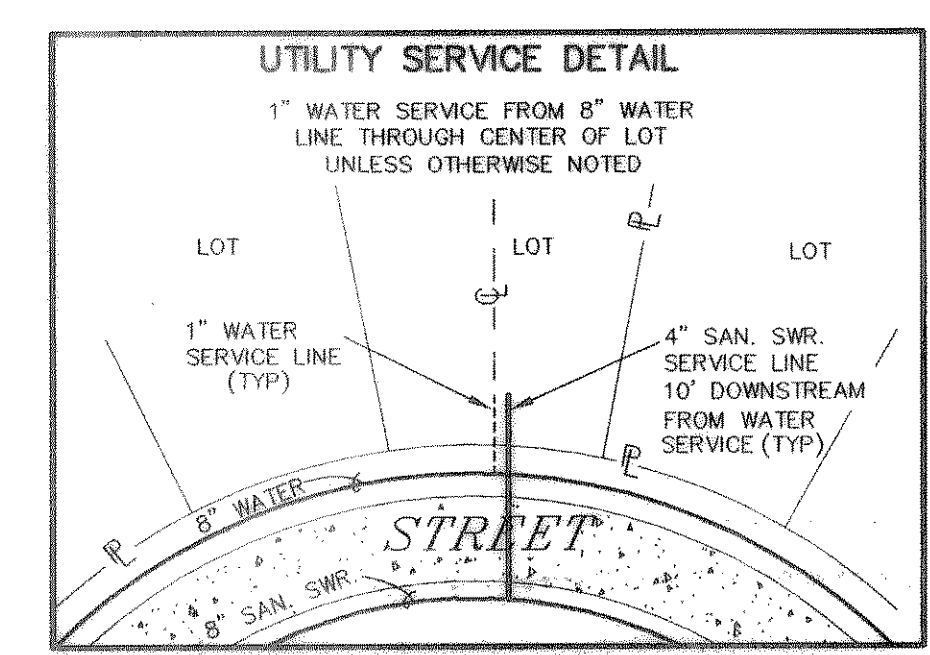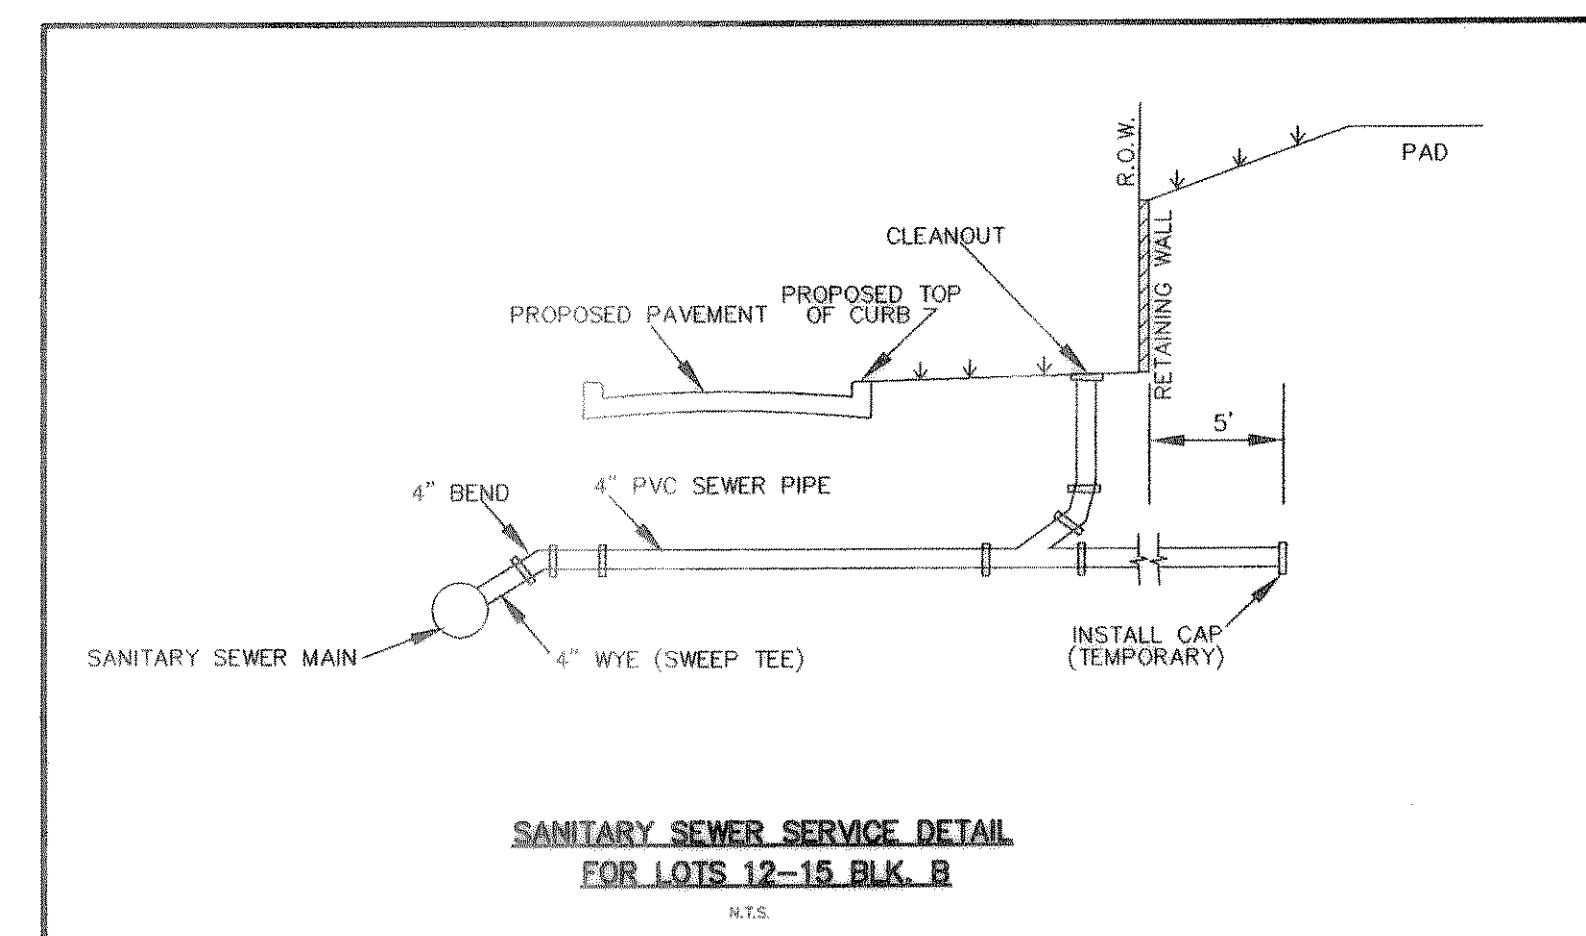

REVISED TO CONFORM TO CONSTRUCTION RECORDS.
 [Signature]
 DATE: 4/25/06

REVISION	
CHECKED	W.L.D.
DRAWN	K.E.B.
DATE	9/01
PROJECT	0050SEW
	25 OF