



THE SEAL APPEARING ON THIS DOCUMENT WAS AUTHORIZED BY W.L. DOUPHRATE II TEXAS P.E. NO. 60102 ON 2/12/82

**DOUPHRATE & ASSOCIATES, INC.**  
ENGINEERING - PROJECT MANAGEMENT - SURVEYING  
2225 RIDGE RD., # 200 ROCKWALL, TEXAS 75087  
PHONE: (972)771-0004 FAX: (972)771-9005

**SANITARY SEWER PROFILE**  
**LINE B**  
**PROMENADE HARBOR**  
**CITY OF ROCKWALL, ROCKWALL COUNTY, TEXAS**

REVISION
W.L.D. CHECKED
K.E.B. DRAWN
9/01 DATE
0050SS3 PROJECT
28 OF

LINE B

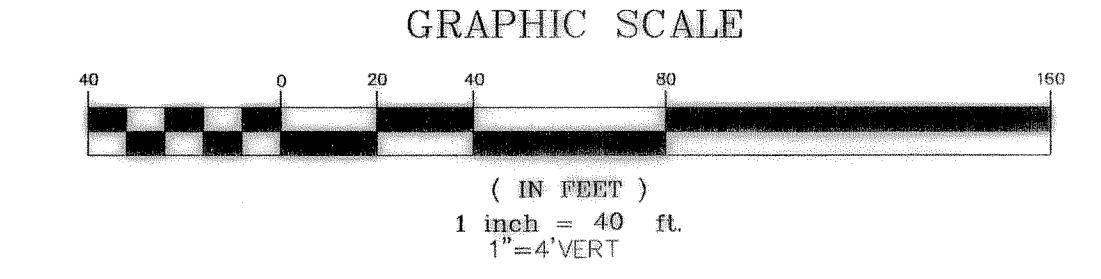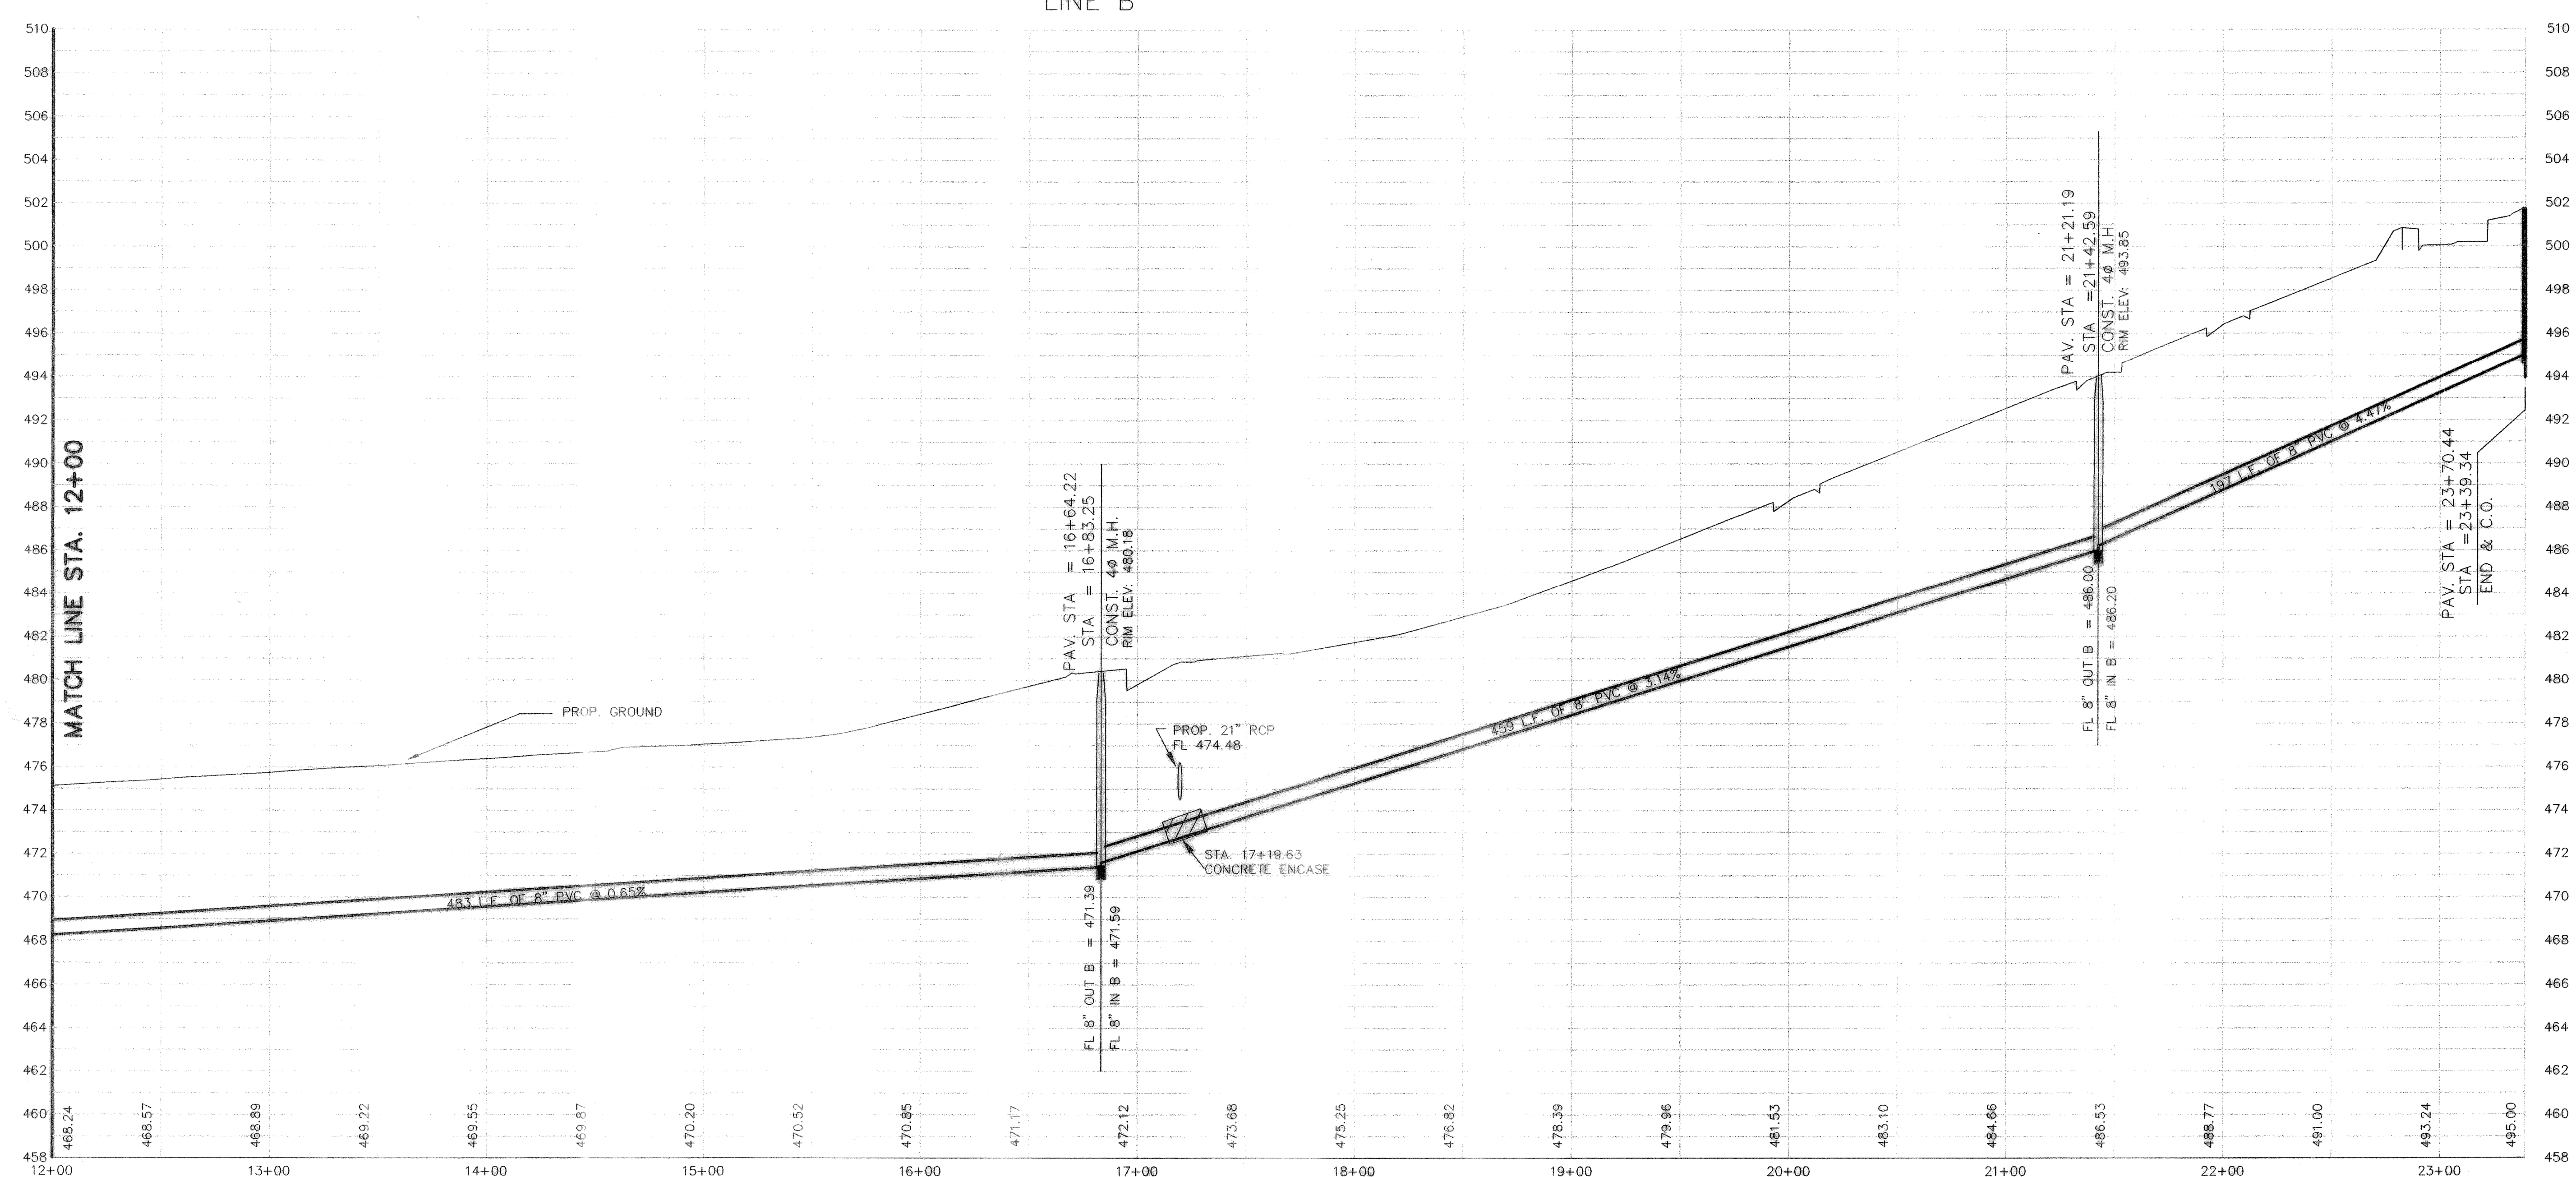

**BENCHMARK:**  
CITY OF DALLAS MONUMENT NO. EE81D  
ON NORTH SIDE OF DALTON ROAD 685'±  
EAST OF NORTHWEST CORNER OF THIS  
TRACT. ELEV=463.08

REVISED TO CONFORM TO CONSTRUCTION RECORDS.  
*[Signature]* DATE: 11/25/02