


**BENCHMARK:**  
 CITY OF DALLAS MONUMENT NO. EE81D  
 ON NORTH SIDE OF DALTON ROAD 685'±  
 EAST OF NORTHWEST CORNER OF THIS  
 TRACT. ELEV=463.08

REVISED TO CONFORM TO CONSTRUCTION RECORDS.  
 DATE: 11/25/02

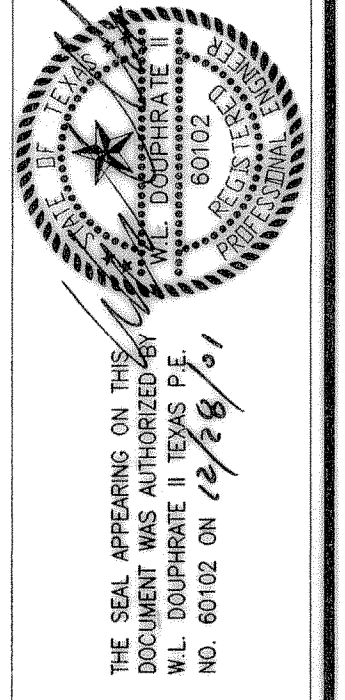

**DOUPHRADE & ASSOCIATES, INC.**  
 ENGINEERING - PROJECT MANAGEMENT - SURVEYING  
 2235 RIDGE RD., # 200 ROCKWALL, TEXAS 75087  
 PHONE: (972)771-9004 FAX: (972)771-9005

**SANITARY SEWER PROFILE**  
**LINE C**  
 PROMENADE HARBOR  
 CITY OF ROCKWALL, ROCKWALL COUNTY, TEXAS

REVISION	
CHECKED	W.L.D.
DRAWN	K.E.B.
DATE	9/01
PROJECT	0050SS5
	28-A
	OF