
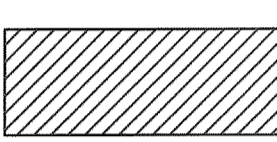
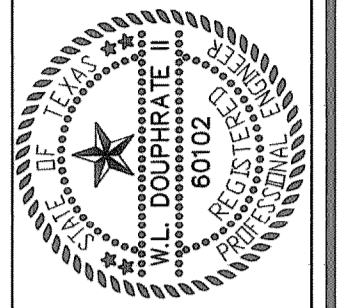


LEGEND

-  CONCRETE
-  PEA GRAVEL



THE SEAL APPEARING ON THIS DOCUMENT WAS AUTHORIZED BY W.L. DOUPHRATE II TEXAS P.E. NO. 60102 ON

DOUPHRATE & ASSOCIATES, INC.
 ENGINEERING - PROJECT MANAGEMENT - SURVEYING
 2235 RIDGE RD., # 200 ROCKWALL, TEXAS 75087
 PHONE: (972)771-9004 FAX: (972)771-9005

LIFT STATION GRADING PLAN
 PROMENADE HARBOR
 CITY OF ROCKWALL
 ROCKWALL COUNTY, TEXAS

REVISION
 W.L.D.
 CHECKED
 K.E.B.
 DRAWN
 7/25/01
 DATE
 0050-L83
 PROJECT