


PAVING PLAN & PROFILE
ASHBOURNE DRIVE STA: 0+00 TO 10+00
PROMENADE HARBOR
CITY OF ROCKWALL, ROCKWALL COUNTY, TEXAS

DOUPHRADE & ASSOCIATES, INC.
 ENGINEERING • PROJECT MANAGEMENT • SURVEYING
 2235 RIDGE RD., # 200 ROCKWALL, TEXAS 75087
 PHONE: (972)771-9004 FAX: (972)771-9005

THE SEAL APPEARING ON THIS DOCUMENT WAS AUTHORIZED BY W.L. DOUPHRADE II TEXAS P.E. NO. 60102 ON

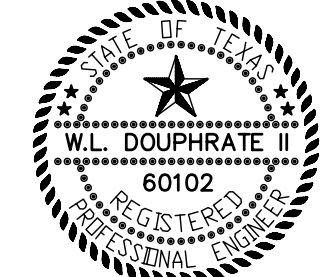

REVISION	
W.L.D. CHECKED	
KEB. DRAWN	
DATE	9/01
PROJECT	0050P12
10 OF	