

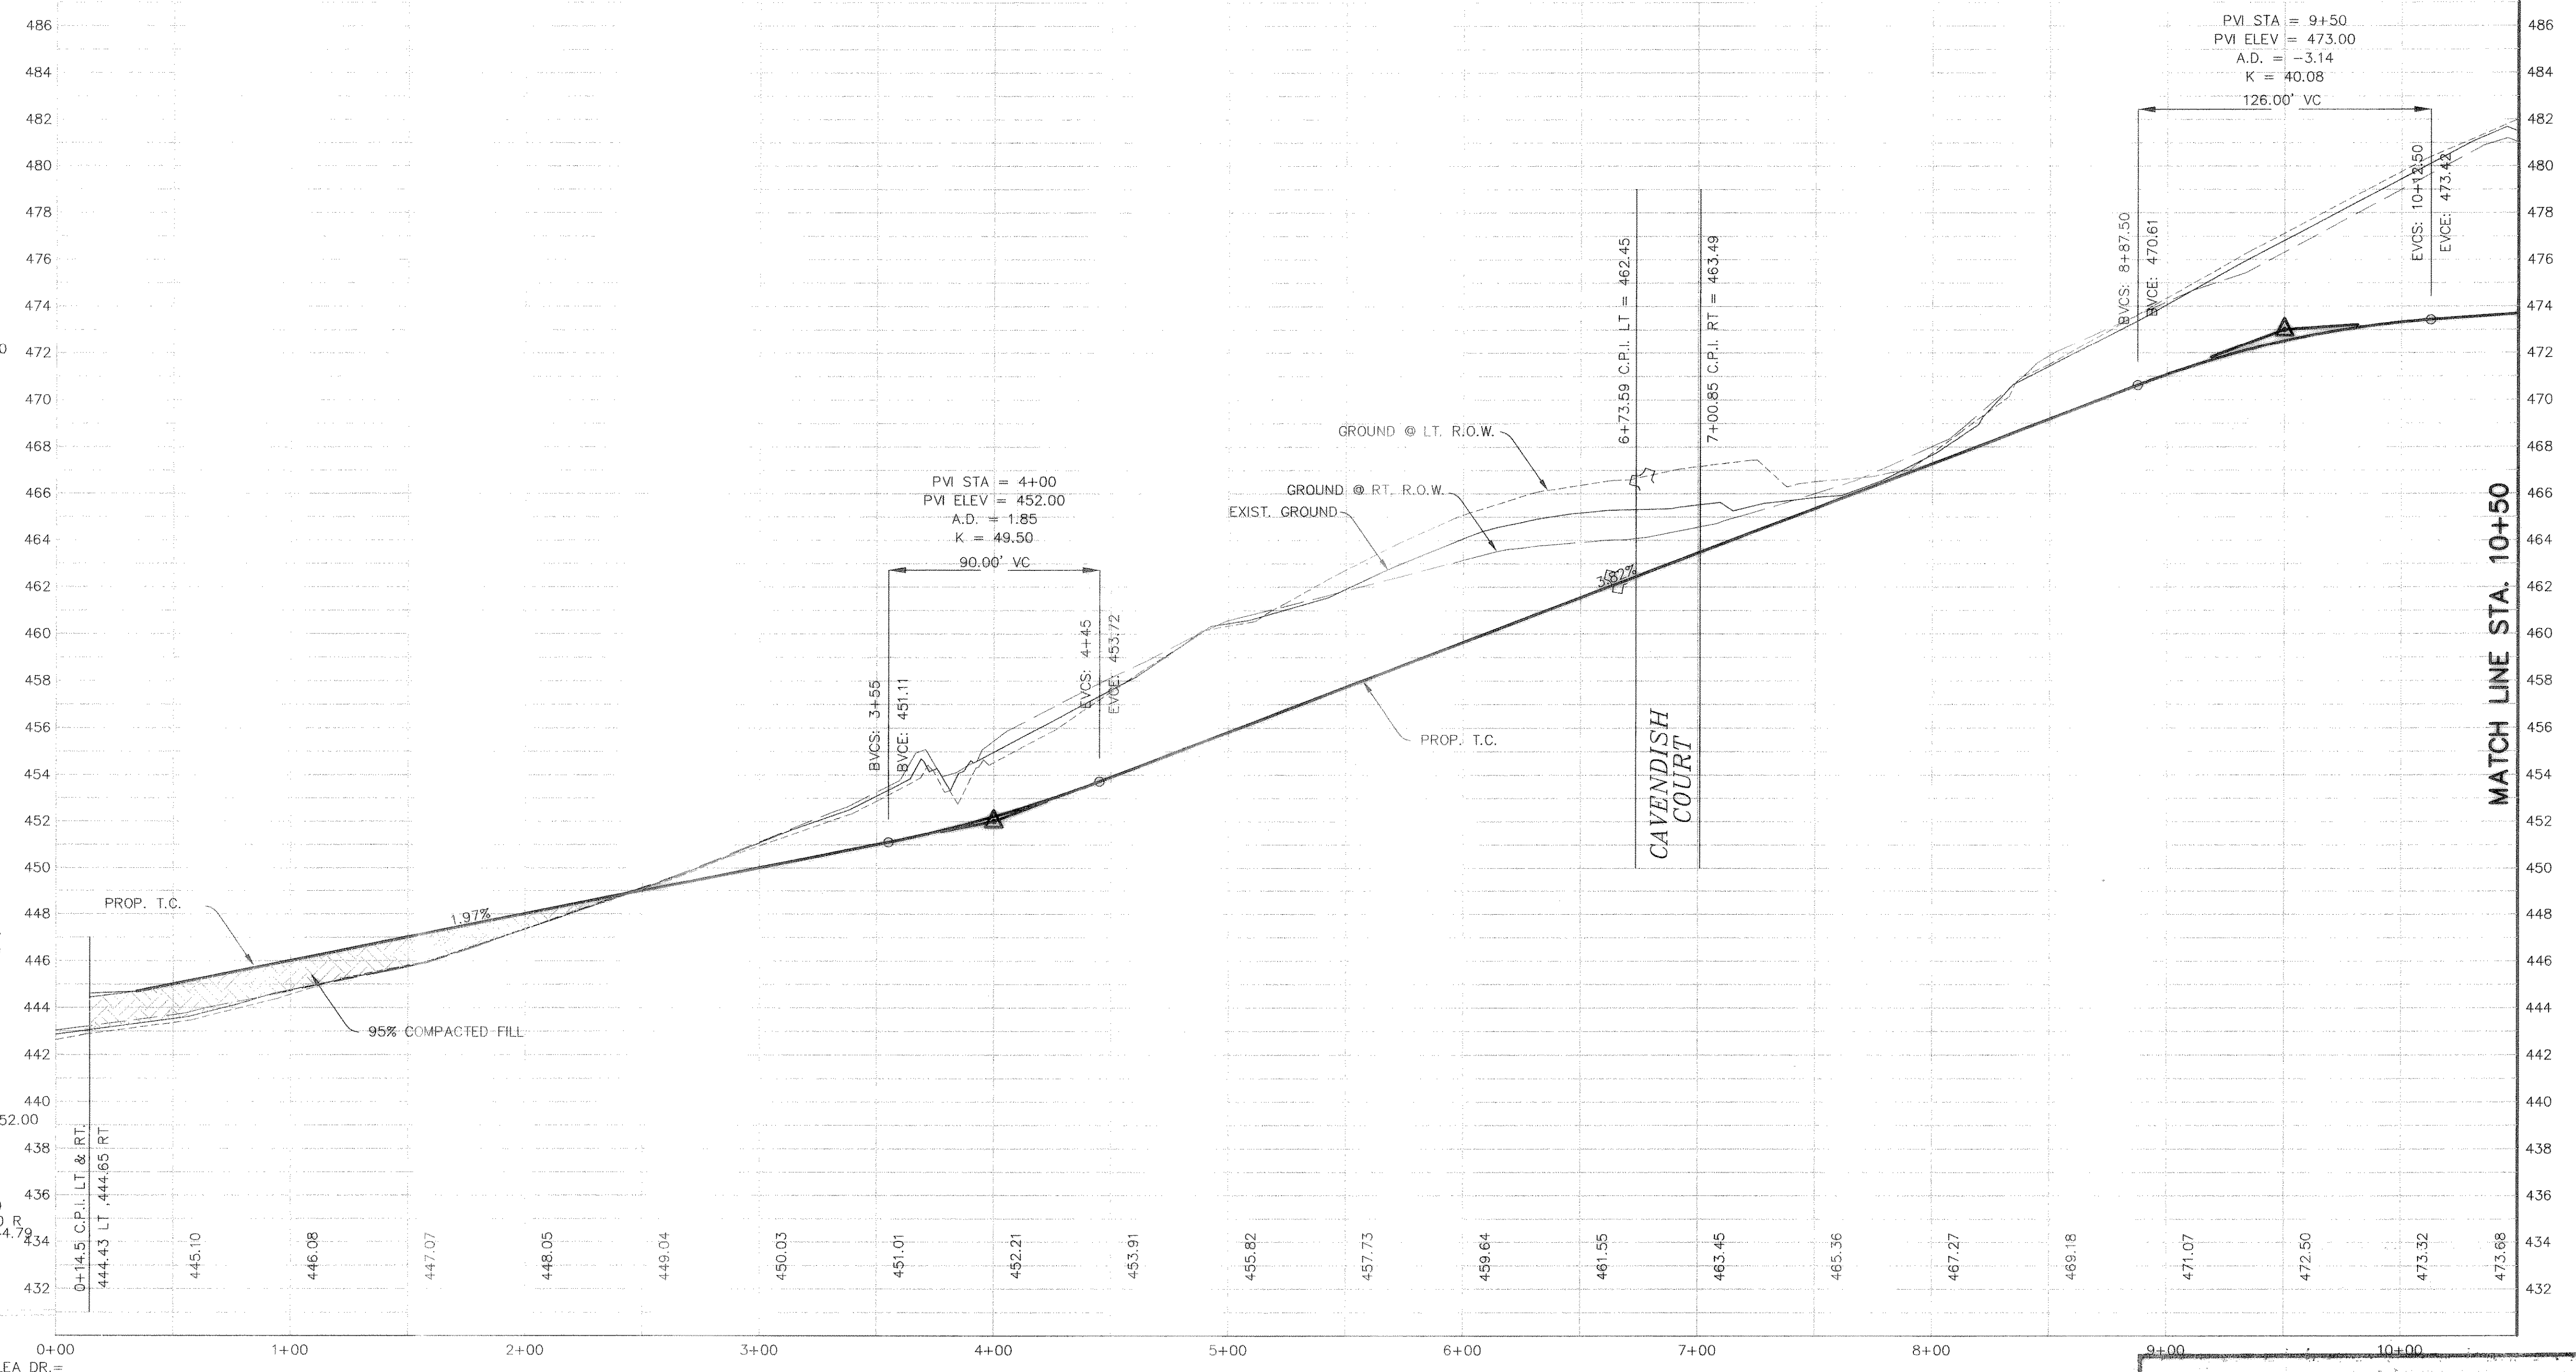


BENCHMARK:
 CITY OF DALLAS MONUMENT NO. EE81D
 ON NORTH SIDE OF DALTON ROAD 685'±
 EAST OF NORTHWEST CORNER OF THIS
 TRACT.
 ELEV=463.08

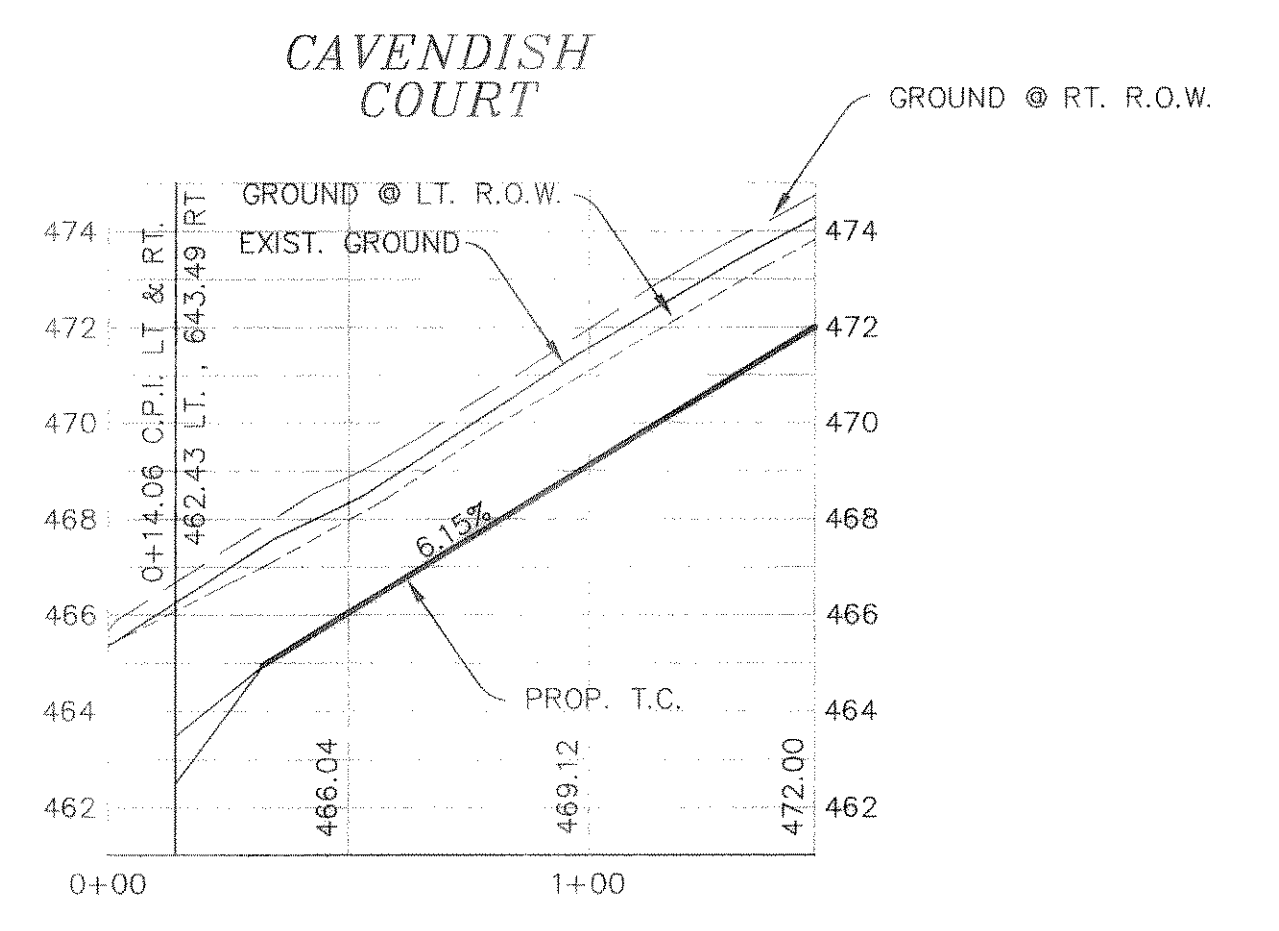

REVISED TO CONFORM TO CONSTRUCTION RECORDS.
 DATE: 11/25/01

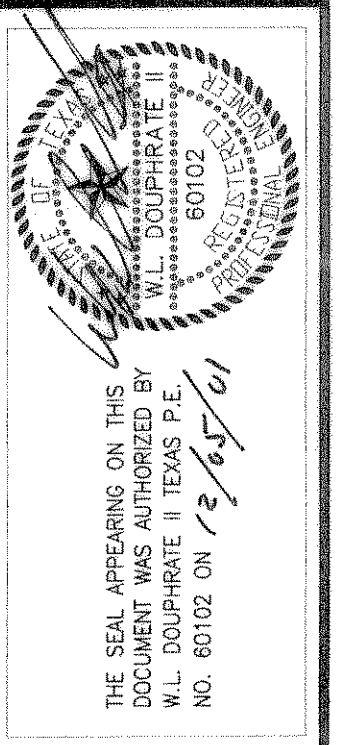

DOUPHRADE & ASSOCIATES, INC.
 ENGINEERING - PROJECT MANAGEMENT - SURVEYING
 2295 RIDGE RD., # 200 ROCKWALL, TEXAS 75087
 PHONE: (972)771-9004 FAX: (972)771-9005

PAVING PLAN & PROFILE
 AVONLEA DR. STA: 0+00 TO 10+50 & CAVENDISH CT.
 PROMENADE HARBOR
 CITY OF ROCKWALL, ROCKWALL COUNTY, TEXAS

REVISION	DATE
WLD. CHECKED	9/01
KEB. DRAWN	0050pv4
PROJECT	12