
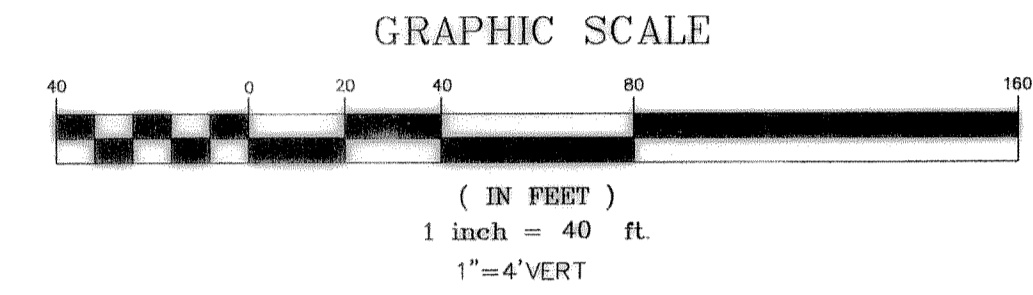


THE SEAL APPEARING ON THIS DOCUMENT WAS AUTHORIZED BY W.L. DOUPHRATE II TEXAS P.E. NO. 00102 ON 3/14/02

DOUPHRATE & ASSOCIATES, INC.
ENGINEERING - PROJECT MANAGEMENT - SURVEYING
2235 RIDGE RD., # 200 ROCKWALL, TEXAS 75087
PHONE: (972)771-9004 FAX: (972)771-9005


SANITARY SEWER PROFILE
LINES D, E & F
PROMENADE HARBOR
CITY OF ROCKWALL, ROCKWALL COUNTY, TEXAS

LINE D

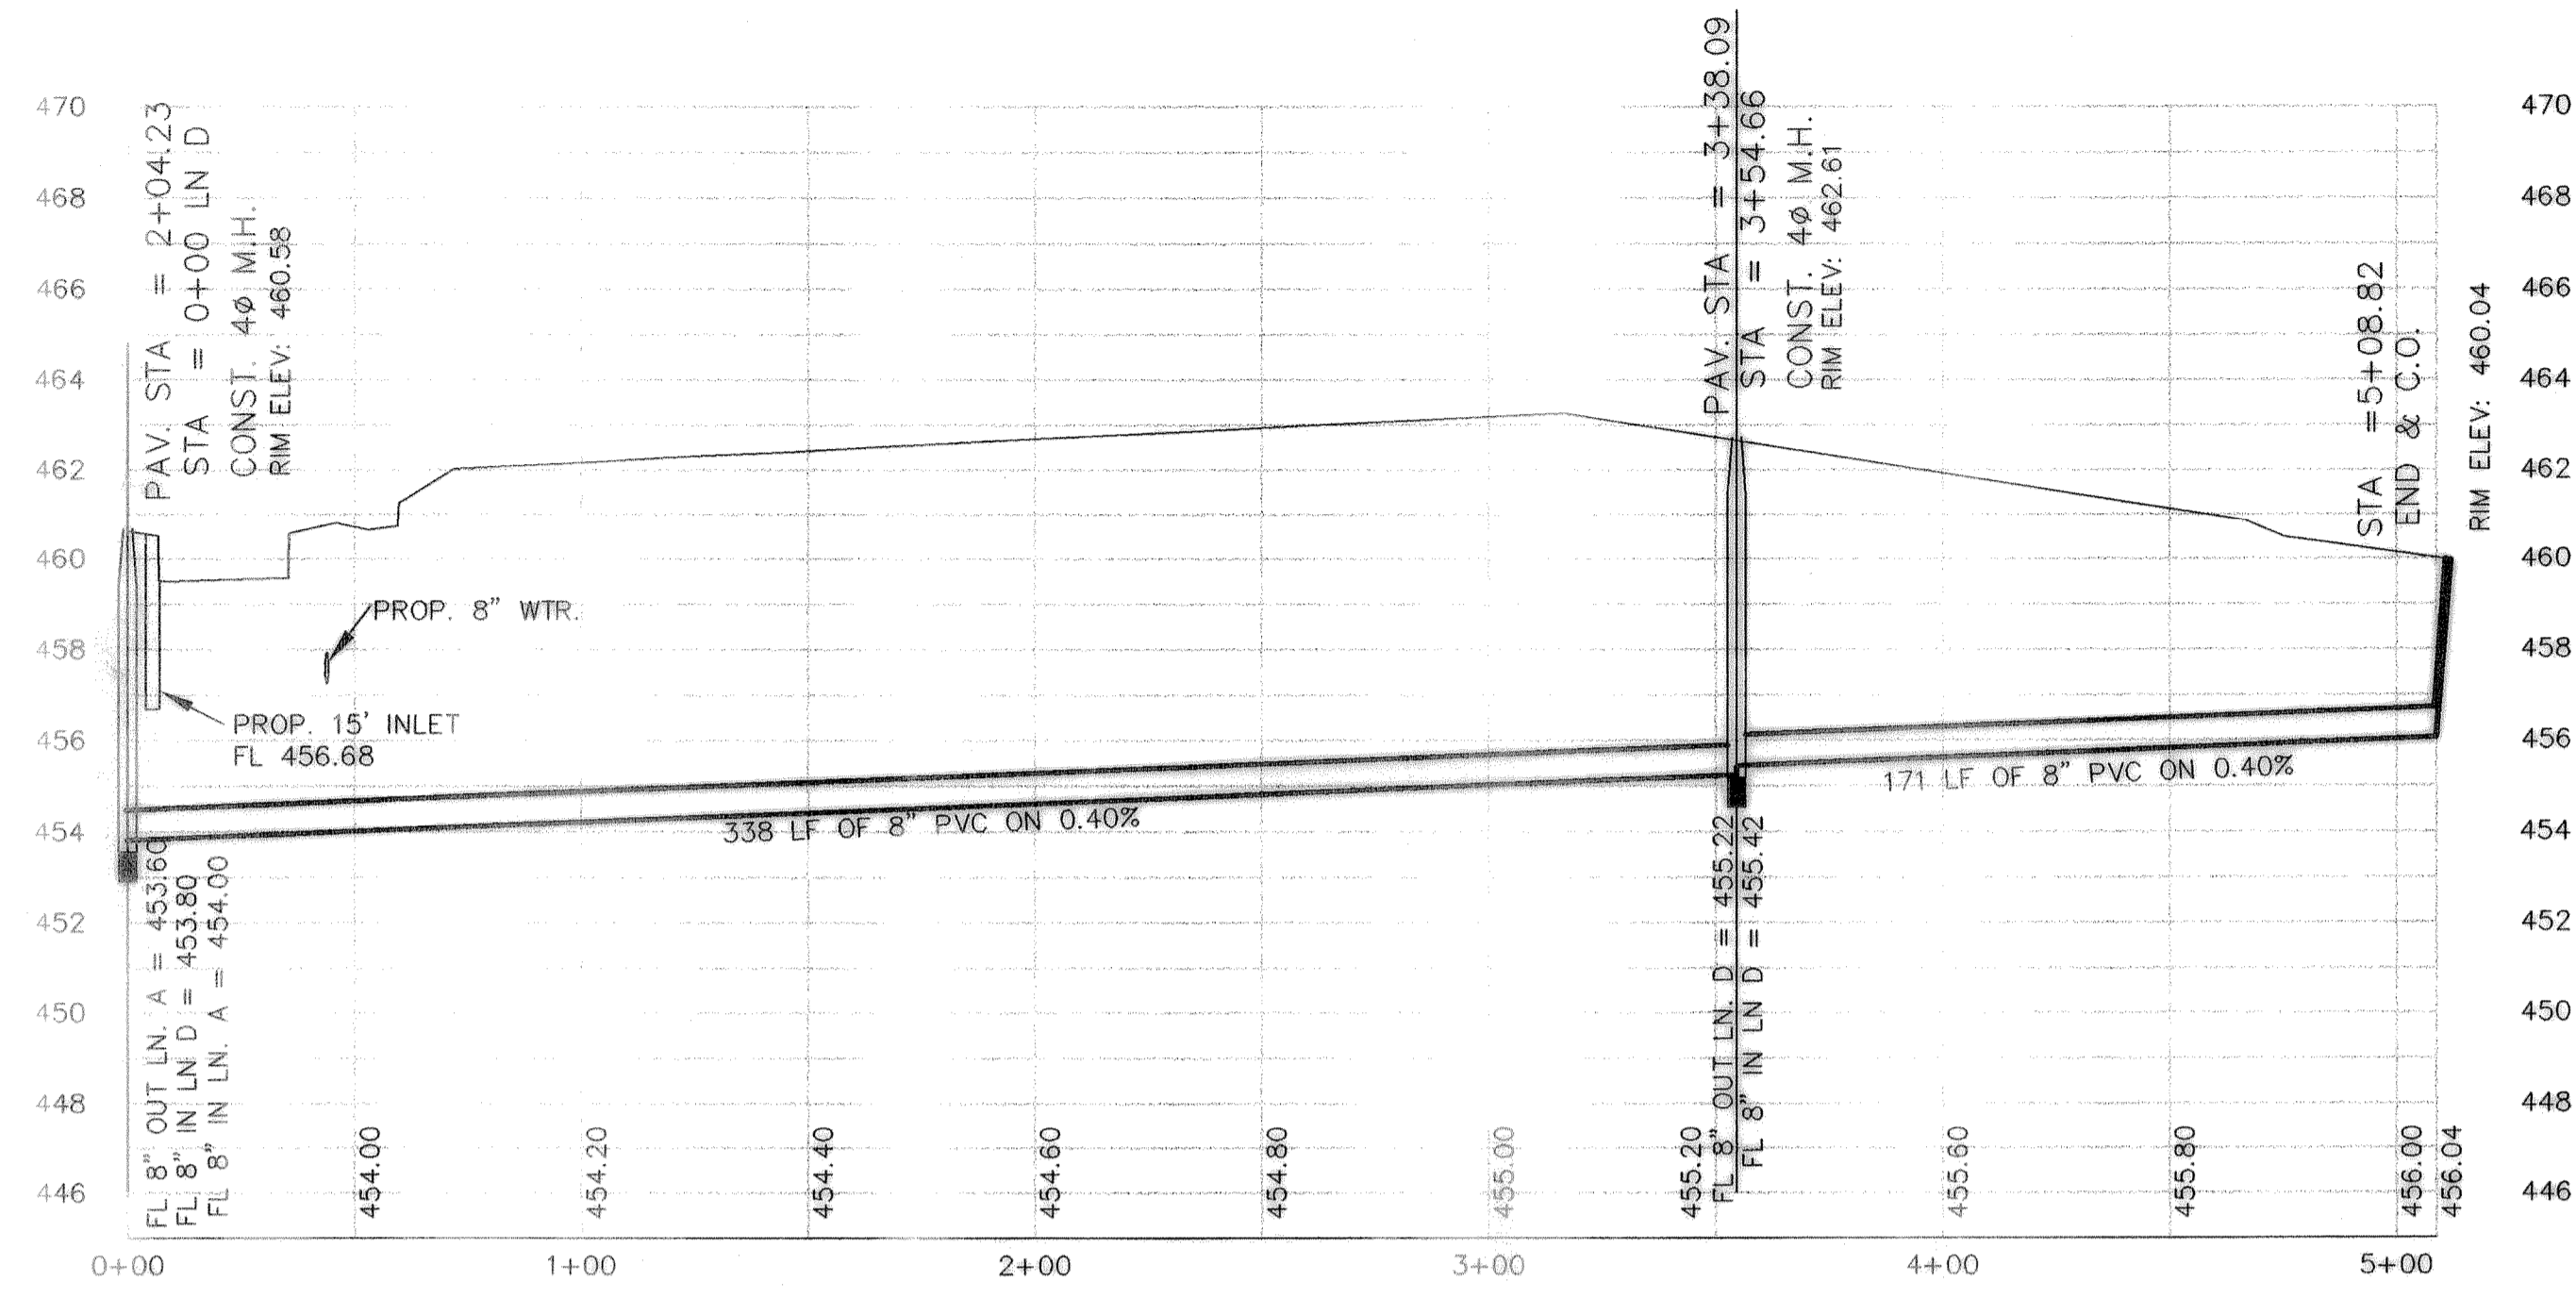


REVISED GRADE 3/13/02

LINE E

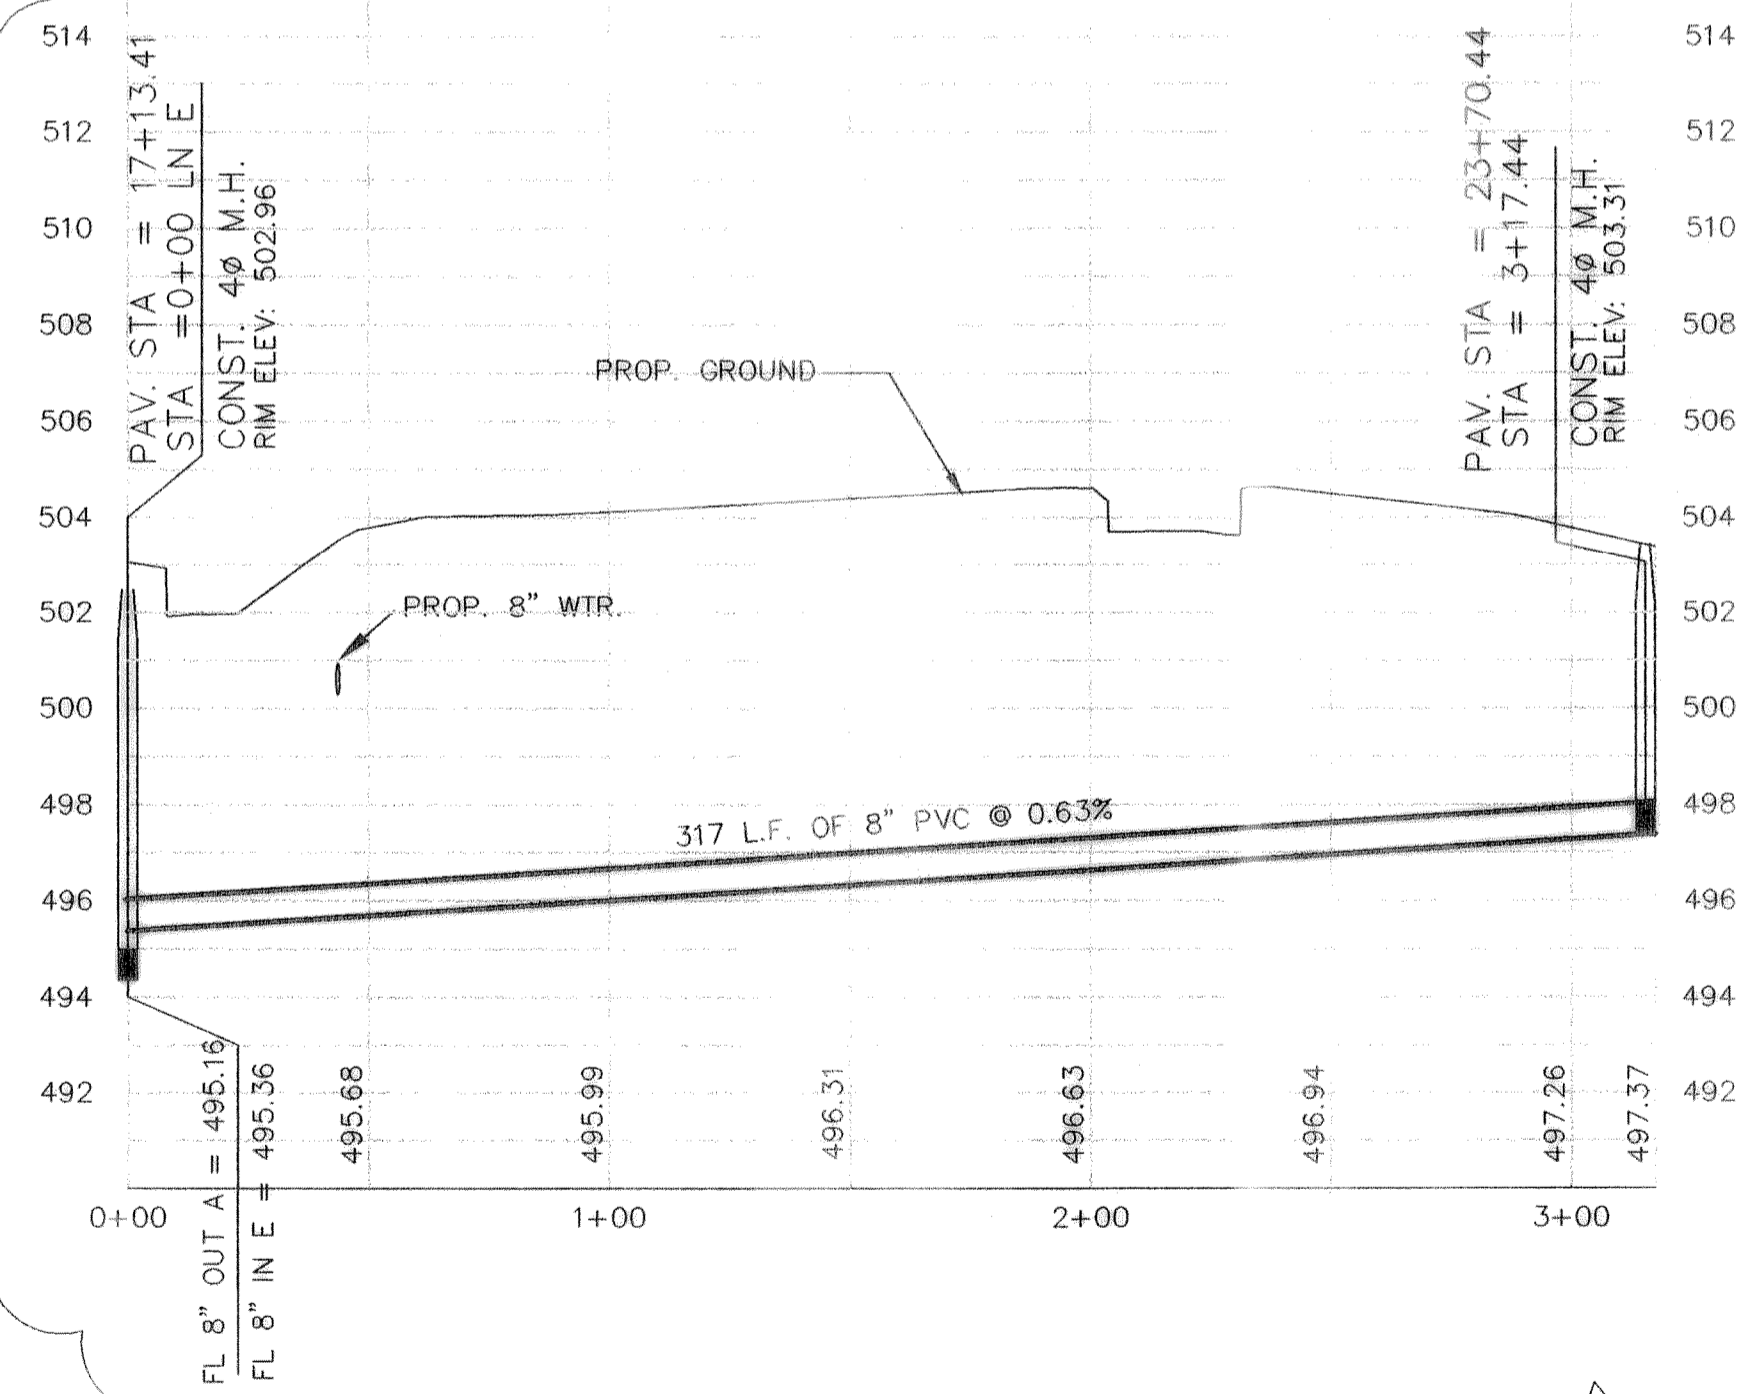

LINE F

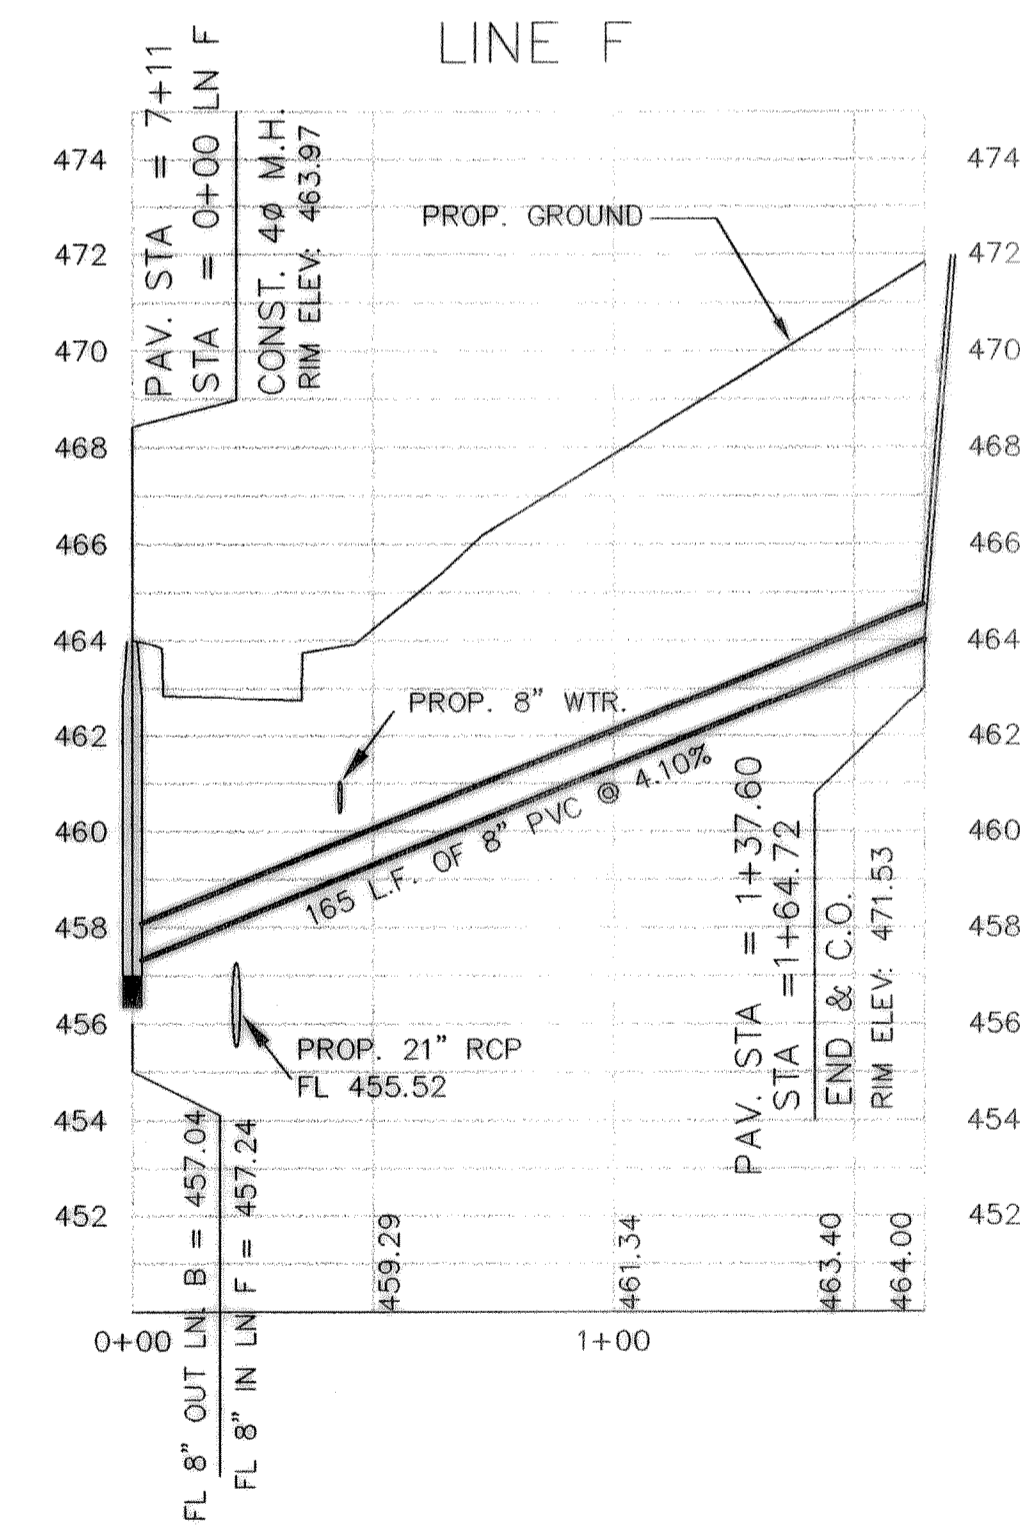

REVISED TO CONFORM TO CONSTRUCTION RECORDS.

[Signature] DATE: 4/25/02

BENCHMARK:
CITY OF DALLAS MONUMENT NO. EE81D
ON NORTH SIDE OF DALTON ROAD 685'±
EAST OF NORTHWEST CORNER OF THIS
TRACT. ELEV=463.08

REVISION

W.L.D.
CHECKED

K.E.B.
DRAWN

9/01
DATE

0050SS4
PROJECT

29
OF