
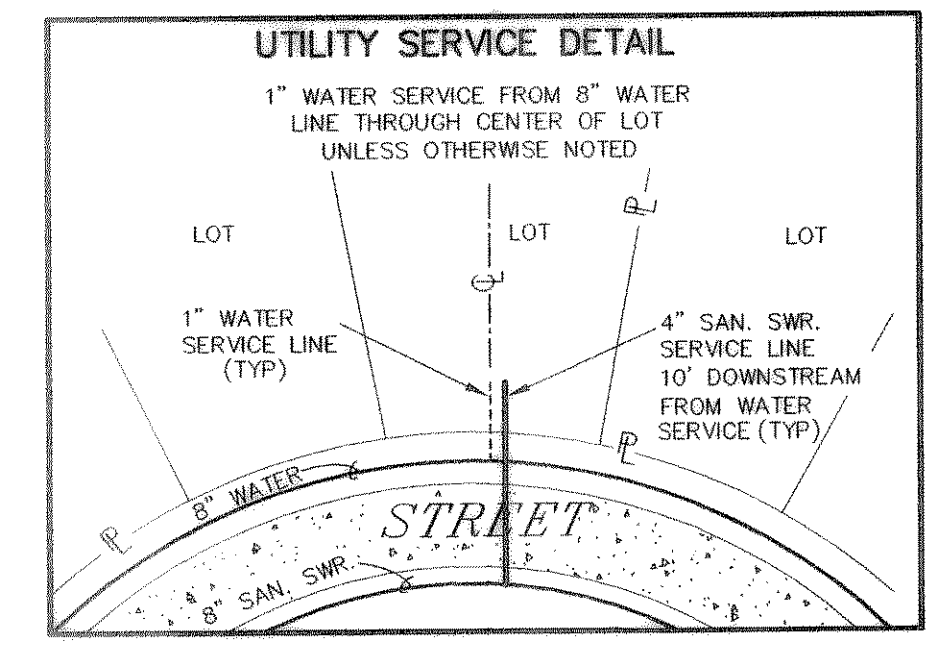
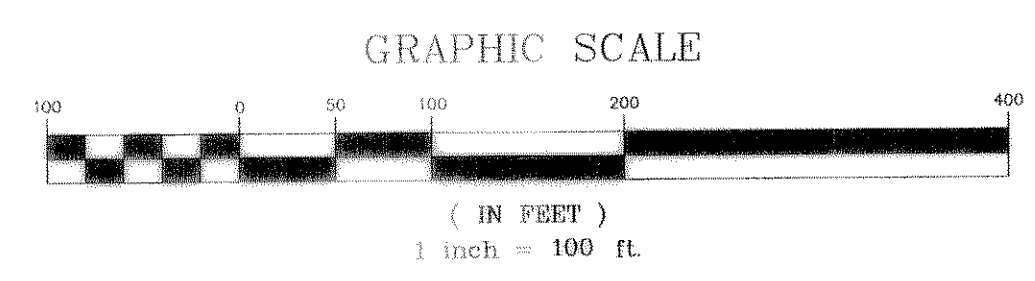


DOUPHRA
& ASSOCIATES, INC.
ENGINEERING - PROJECT MANAGEMENT - SURVEYING
2235 RIDGE RD., # 200 ROCKWALL, TEXAS 75087
PHONE: (972) 771-9004 FAX: (972) 771-9005

WATER PLAN
PROMENADE HARBOR
CITY OF ROCKWALL
ROCKWALL COUNTY, TEXAS

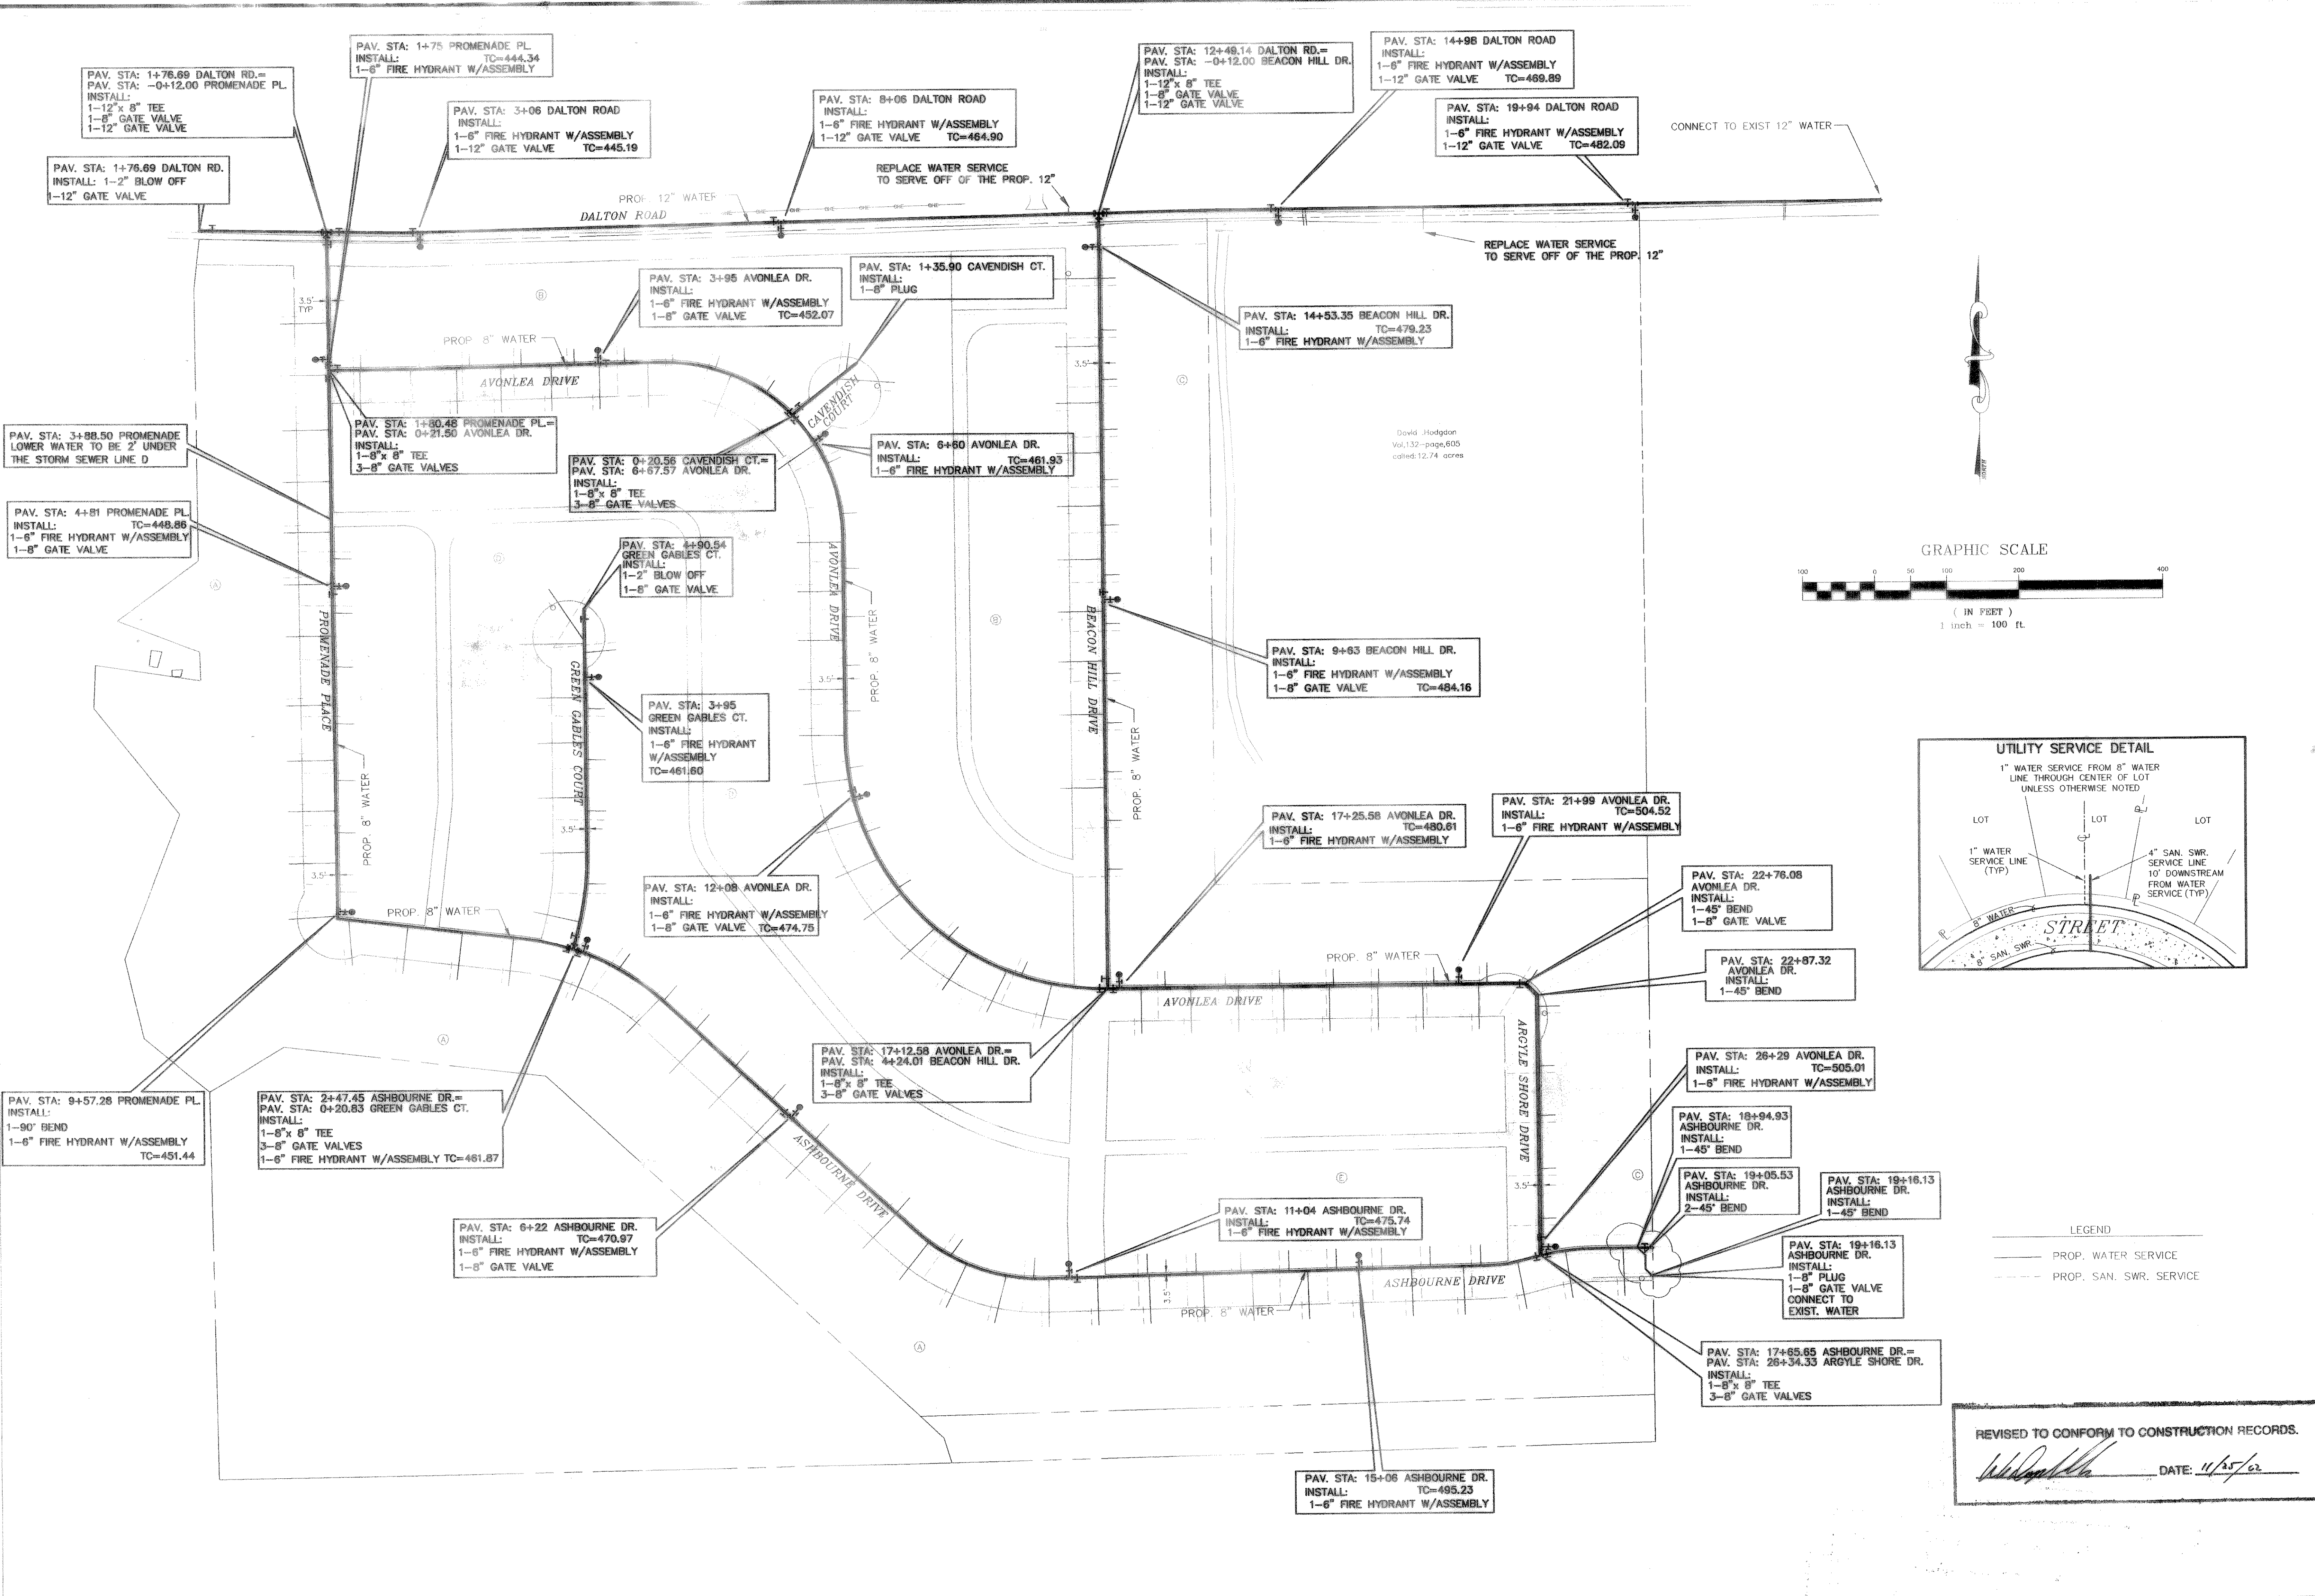

LEGEND
— PROP. WATER SERVICE
- - - PROP. SAN. SWR. SERVICE

REVISED TO CONFORM TO CONSTRUCTION RECORDS.
W.L. Douphrate DATE: 11/15/02

REVISION
W.L.D. CHECKED
K.E.B. DRAWN
07/01 DATE
0050WAT PROJECT
24 OF