


# DEVELOPMENT PLANS FOR QUAIL HOLLOW PHASE I CITY OF ROCKWALL, TEXAS

## INDEX

1	TITLE
2	PLAT (2 SHEETS)
3	CITY GENERAL NOTES
4	CITY GENERAL NOTES
5	HAYS LANE
6	FOREST CREEK DRIVE STA. 0+00 TO 12+00
7	FOREST CREEK DRIVE STA 12+00 TO END, RANDAS WAY
8	APPLE TREE DRIVE
9	SHADY OAKS DRIVE STA. 0+00 TO 12+00
10	SHADY OAKS DRIVE STA. 12+00 TO END, ALOTIAN DRIVE
11	MONTROSE DRIVE STA. 0+00 TO 12+00
12	MONTROSE DRIVE STA. 12+00 TO END
13	MIRAMONT DRIVE
14	JOHN KING BOULEVARD LEFT TURN LANE
15	GRADING PLAN
16	GRADING PLAN
17	GRADING PLAN
18	GRADING PLAN
18B	GRADING PLAN
19	WATER AND SANITARY SEWER PLAN
20	SANITARY SEWER PROFILES
21	SANITARY SEWER PROFILES
22	SANITARY SEWER PROFILES
23	SANITARY SEWER PROFILES
24	PRE-PROJECT CONDITIONS DRAINAGE AREA MAP
25	PRE-PROJECT CONDITIONS DRAINAGE AREA MAP
26	POST-PROJECT CONDITIONS DRAINAGE AREA MAP
27	POST-PROJECT CONDITIONS DRAINAGE AREA MAP
28	DRAINAGE CALCULATIONS
29	STORM SEWER PLAN AND PROFILE LINES 'D-1' AND 'D-3'
30	STORM SEWER PLAN AND PROFILE LINE 'D-2'
31	STORM SEWER PLAN AND PROFILE LINE 'D-4'
32	STORM SEWER PLAN AND PROFILE LINES 'D-5' AND 'D-6'
33	STORM SEWER PLAN AND PROFILE LINES 'D-7' AND 'D-8'
34	STORM SEWER PROFILES
35	NORTHWEST RETENTION/DETENTION POND PLAN
36	SOUTH DETENTION POND PLAN
37	EROSION CONTROL PLAN
38	EROSION CONTROL PLAN
39	EROSION CONTROL PLAN
40	SIGN AND LIGHT PLAN

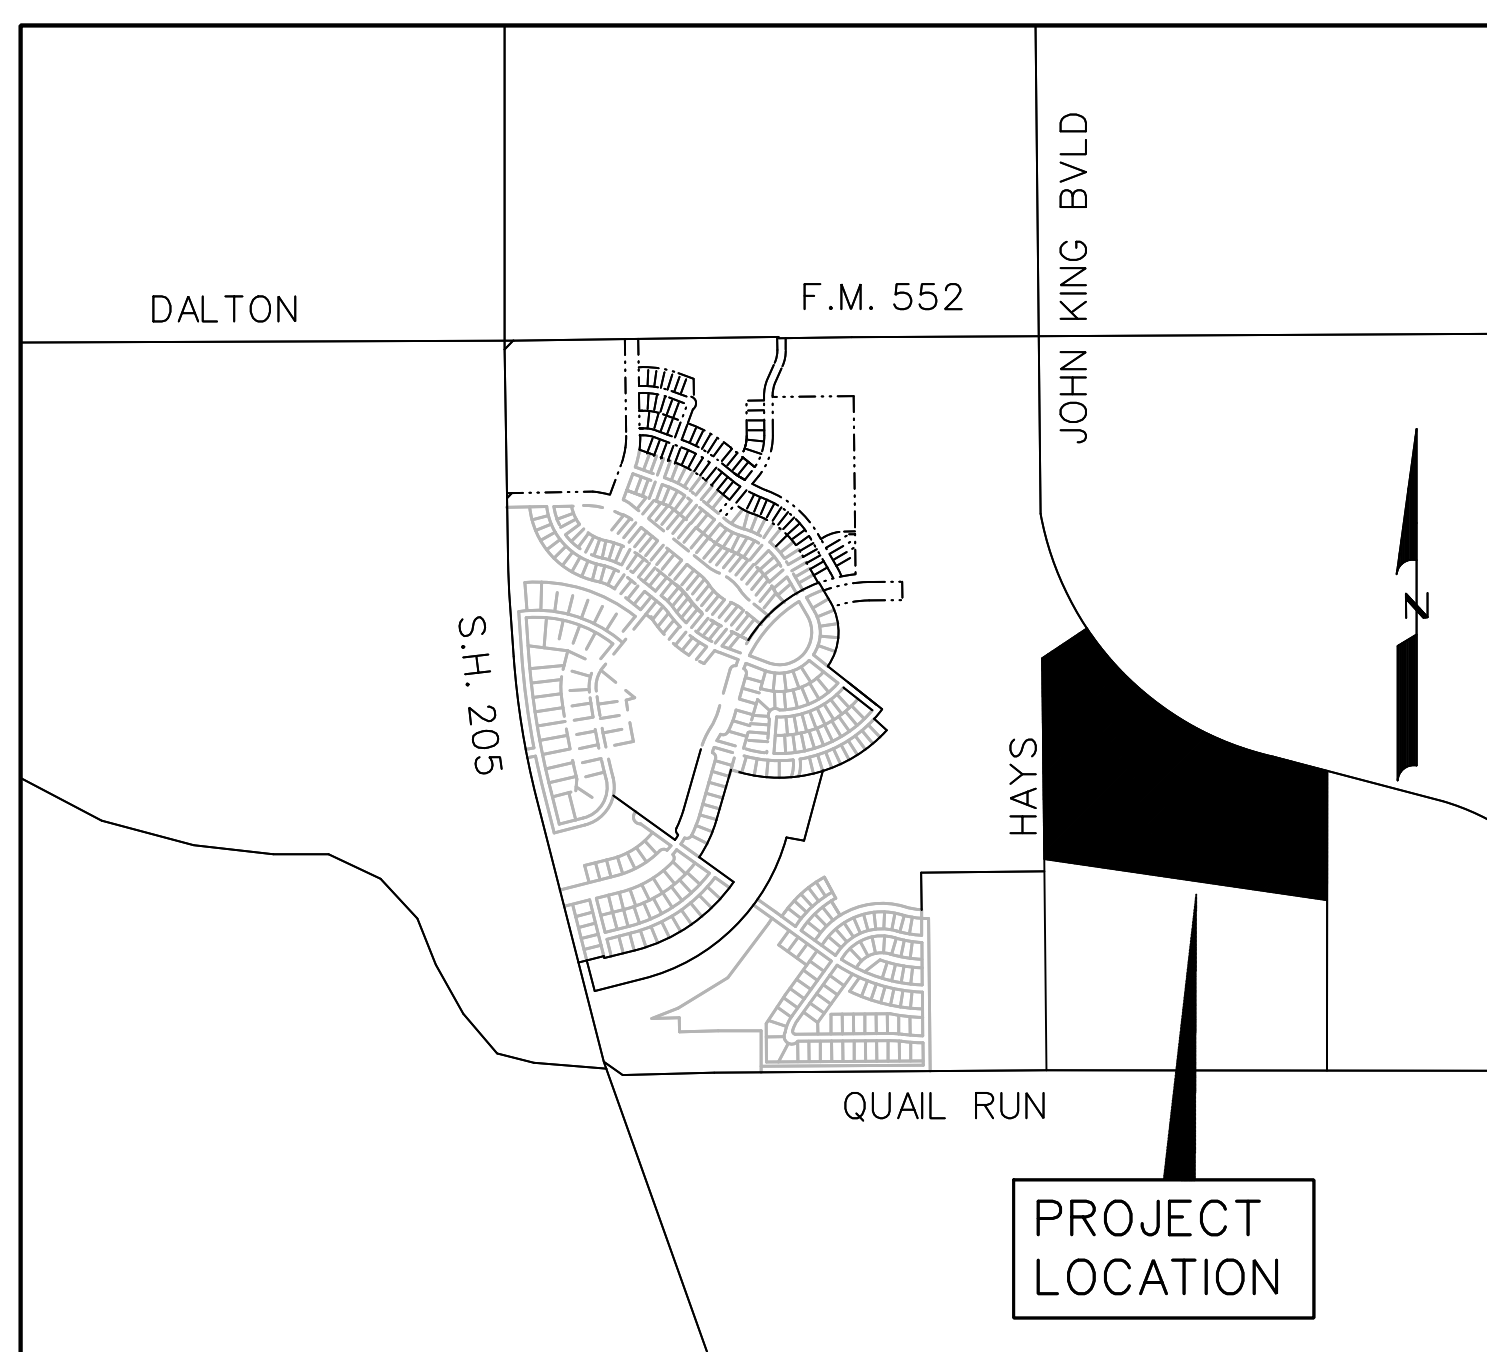

LOCATION MAP

PREPARED FOR  
**QUAIL HOLLOW SF, LTD.**  
8214 WESTCHESTER DRIVE., SUITE 710, DALLAS, TEXAS 75225

**CORWIN ENGINEERING, INC. — CONSULTING ENGINEERS**

200 W. BELMONT, SUITE E


TBPELS FIRM \*F-5951

ALLEN, TEXAS 75013

NOTE:

CITY OF ROCKWALL STANDARDS  
AND NCTCOG 5th ADDITION STANDARDS  
SHALL BE USED FOR REFERENCE.

RECORD DRAWINGS  
JANUARY 2024  
INFORMATION PROVIDED  
BY CONTRACTORS  
(NOT FIELD VERIFIED)

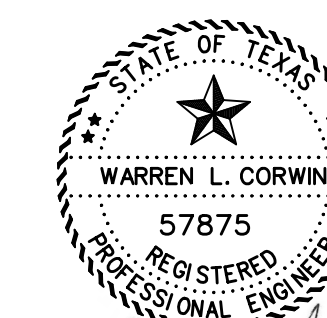

*Warren L. Corwin*  
02/22/2023

NO.	REVISIONS	DATE