




PAVING NOTES:

- Street pavement cement content to be no less than 6 sacks per cubic yard for machine placed and not less than 6.5 sacks per cubic for hand placed.
- Sidewalk cement content of not less than 5.5 per cubic yard.
- No sand allowed under pavement or sidewalks.
- Minimum lime content shall be 6% of dry weight of material (at least 27 lbs./SY) compacted to 95% standard density.

NOTE:
 ALL DIMENSIONS ARE TO BACK OF CURB UNLESS OTHERWISE NOTED.
 - - - - - SIDEWALK BY HOMEBUILDER
 _____ SIDEWALK BY DEVELOPER
 ALL ADA RAMPS TO BE BUILT BY DEVELOPER.

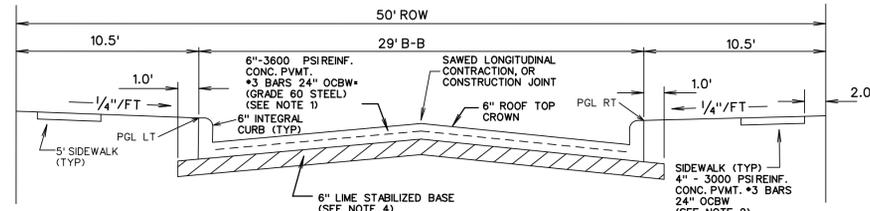

TYPICAL PAVEMENT SECTION (29' B-B)
N.T.S.

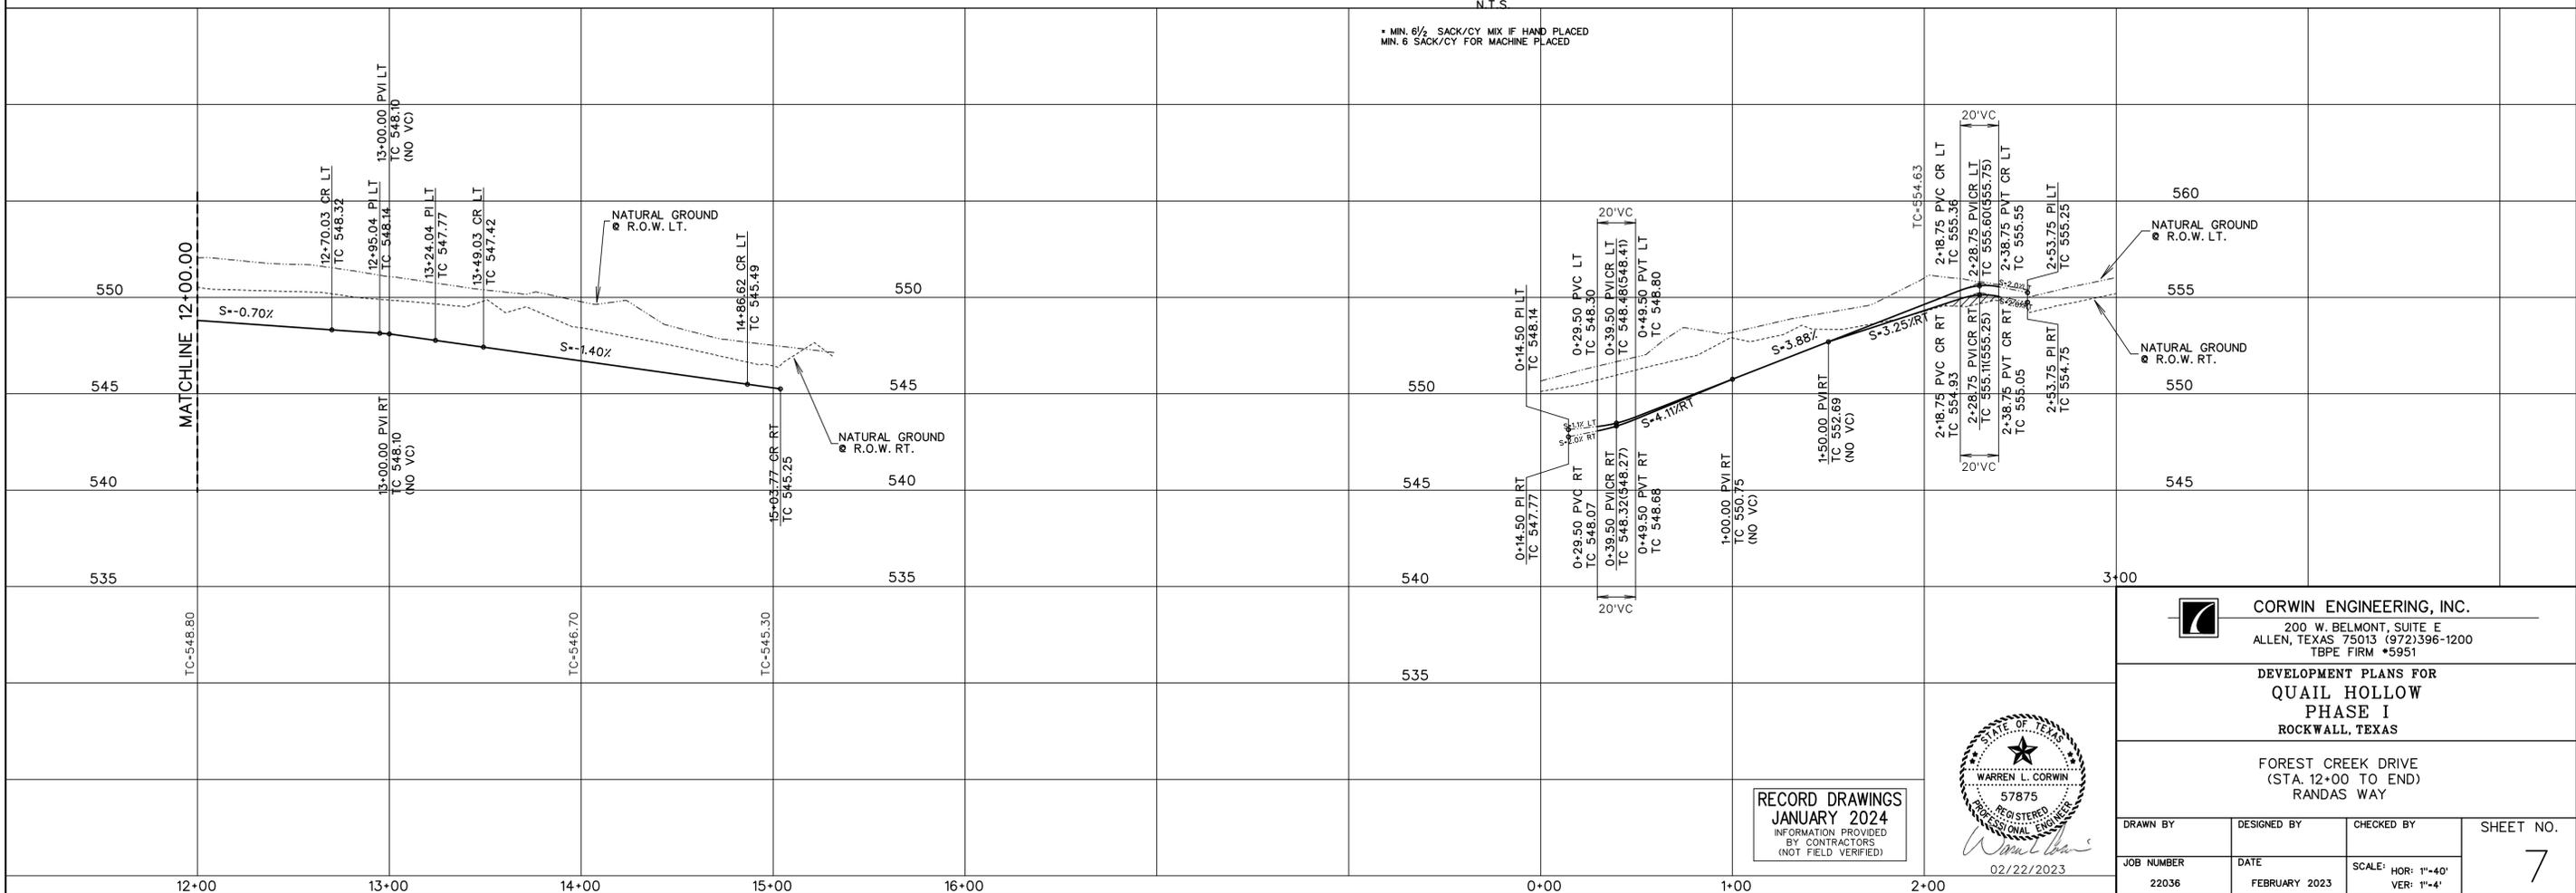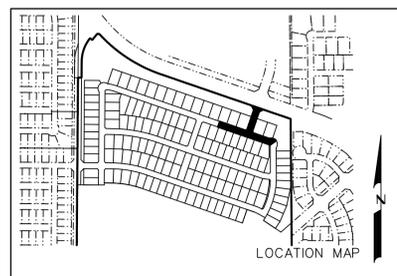

RECORD DRAWINGS
JANUARY 2024
 INFORMATION PROVIDED BY CONTRACTORS (NOT FIELD VERIFIED)



CORWIN ENGINEERING, INC.
 200 W. BELMONT, SUITE E
 ALLEN, TEXAS 75013 (972)396-1200
 TBPE FIRM #5951

DEVELOPMENT PLANS FOR
QUAIL HOLLOW
PHASE I
ROCKWALL, TEXAS

FOREST CREEK DRIVE
(STA. 12+00 TO END)
RANDAS WAY

DRAWN BY	DESIGNED BY	CHECKED BY	SHEET NO.
22036	FEBRUARY 2023	SCALE: HOR: 1"=40' VER: 1"=4'	7