
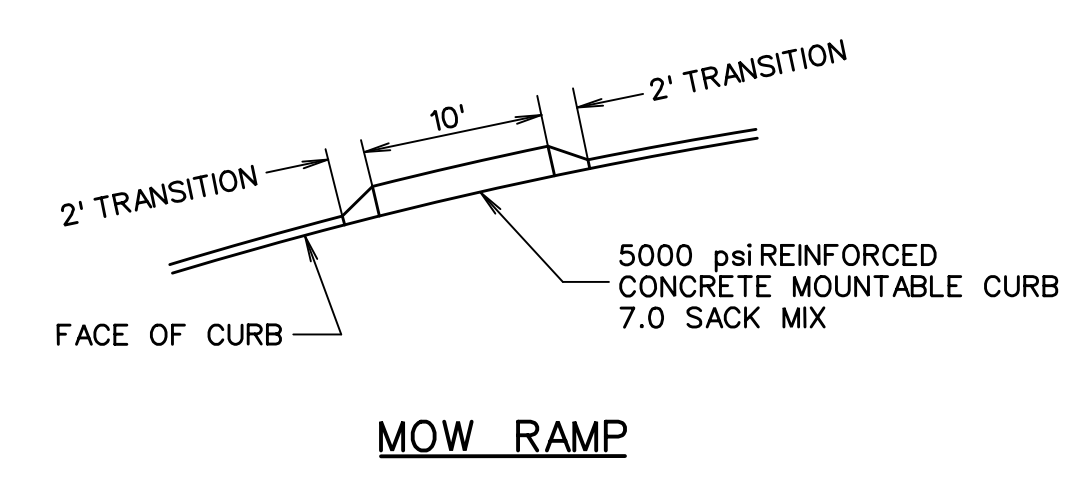
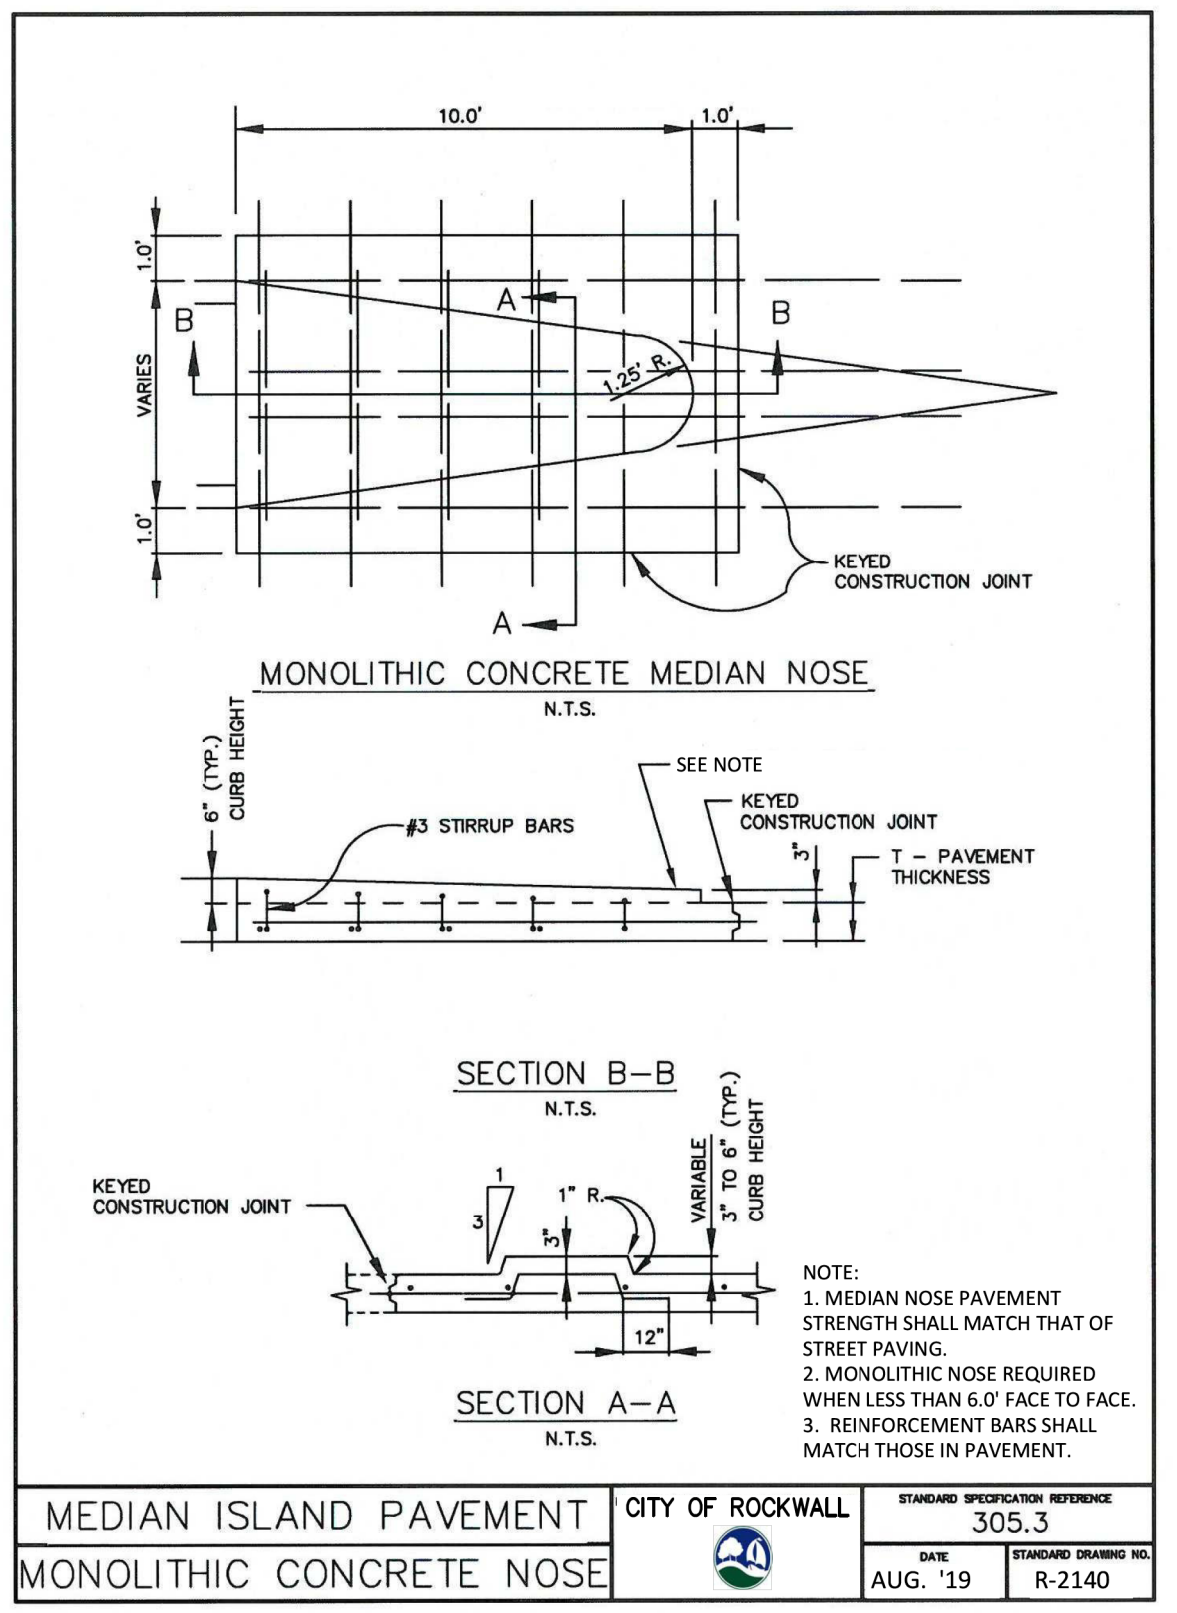
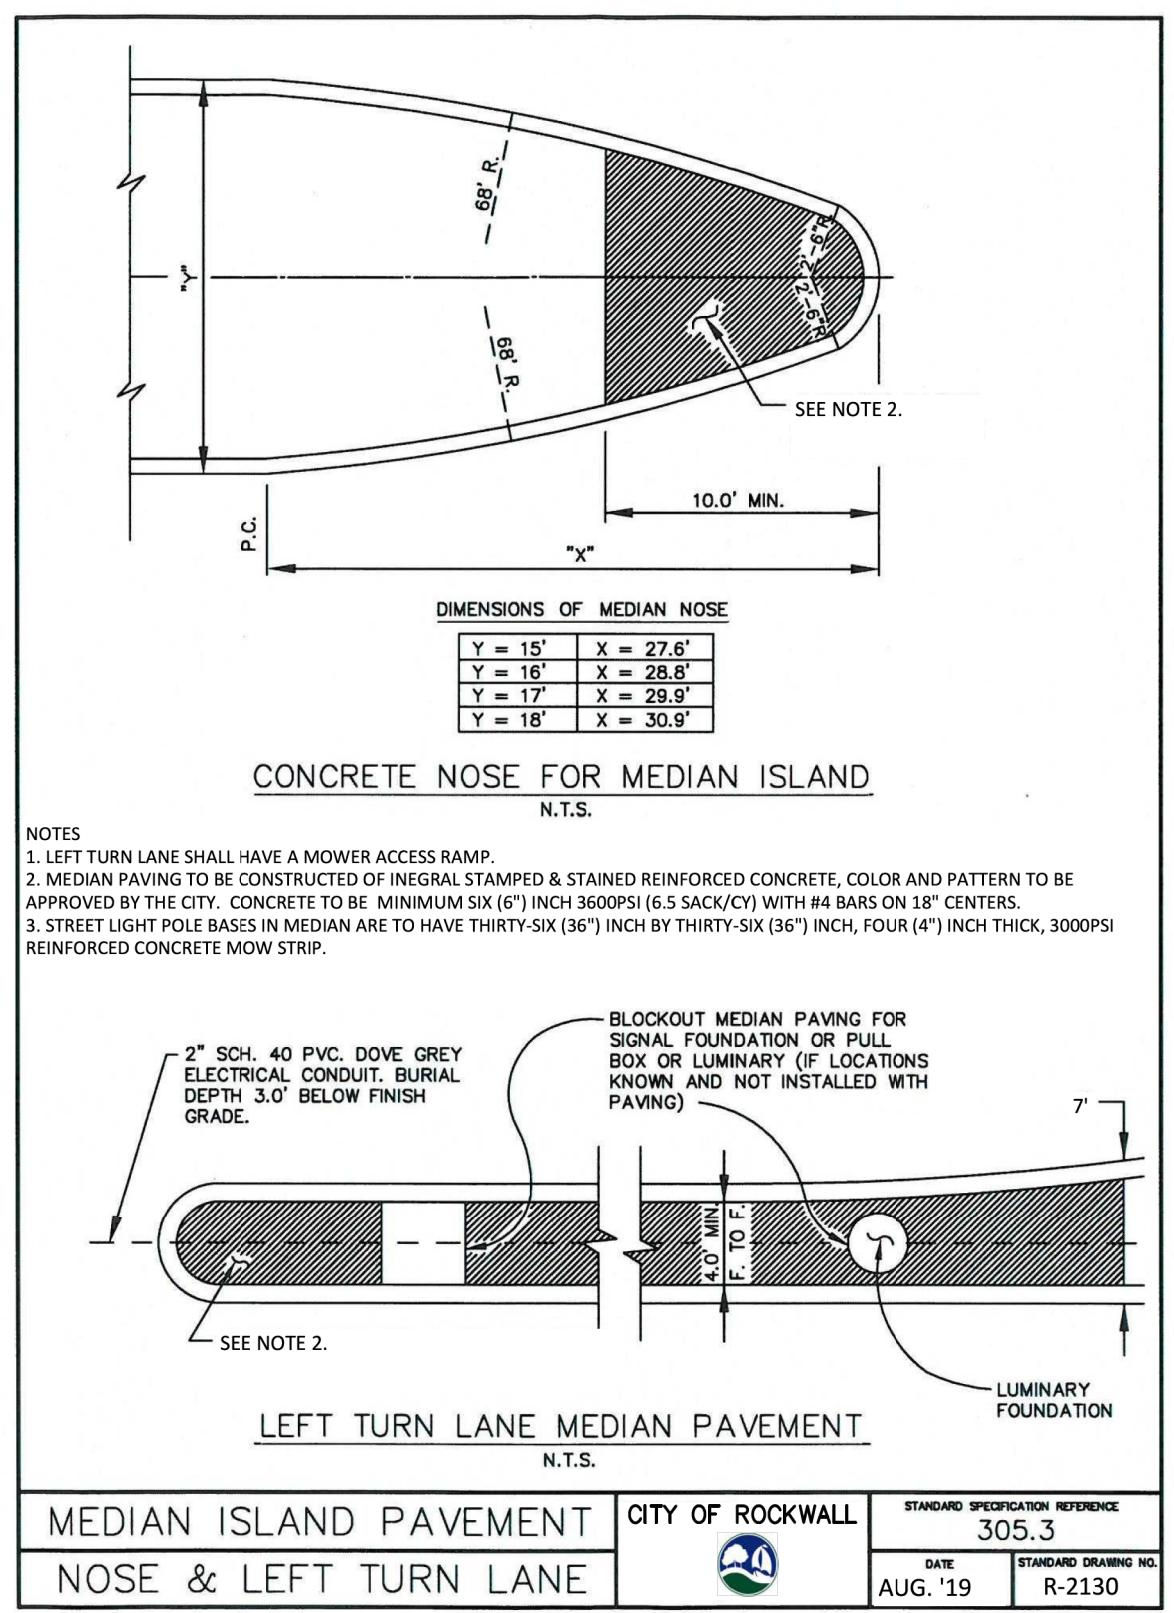



SCALE: 1" = 20'

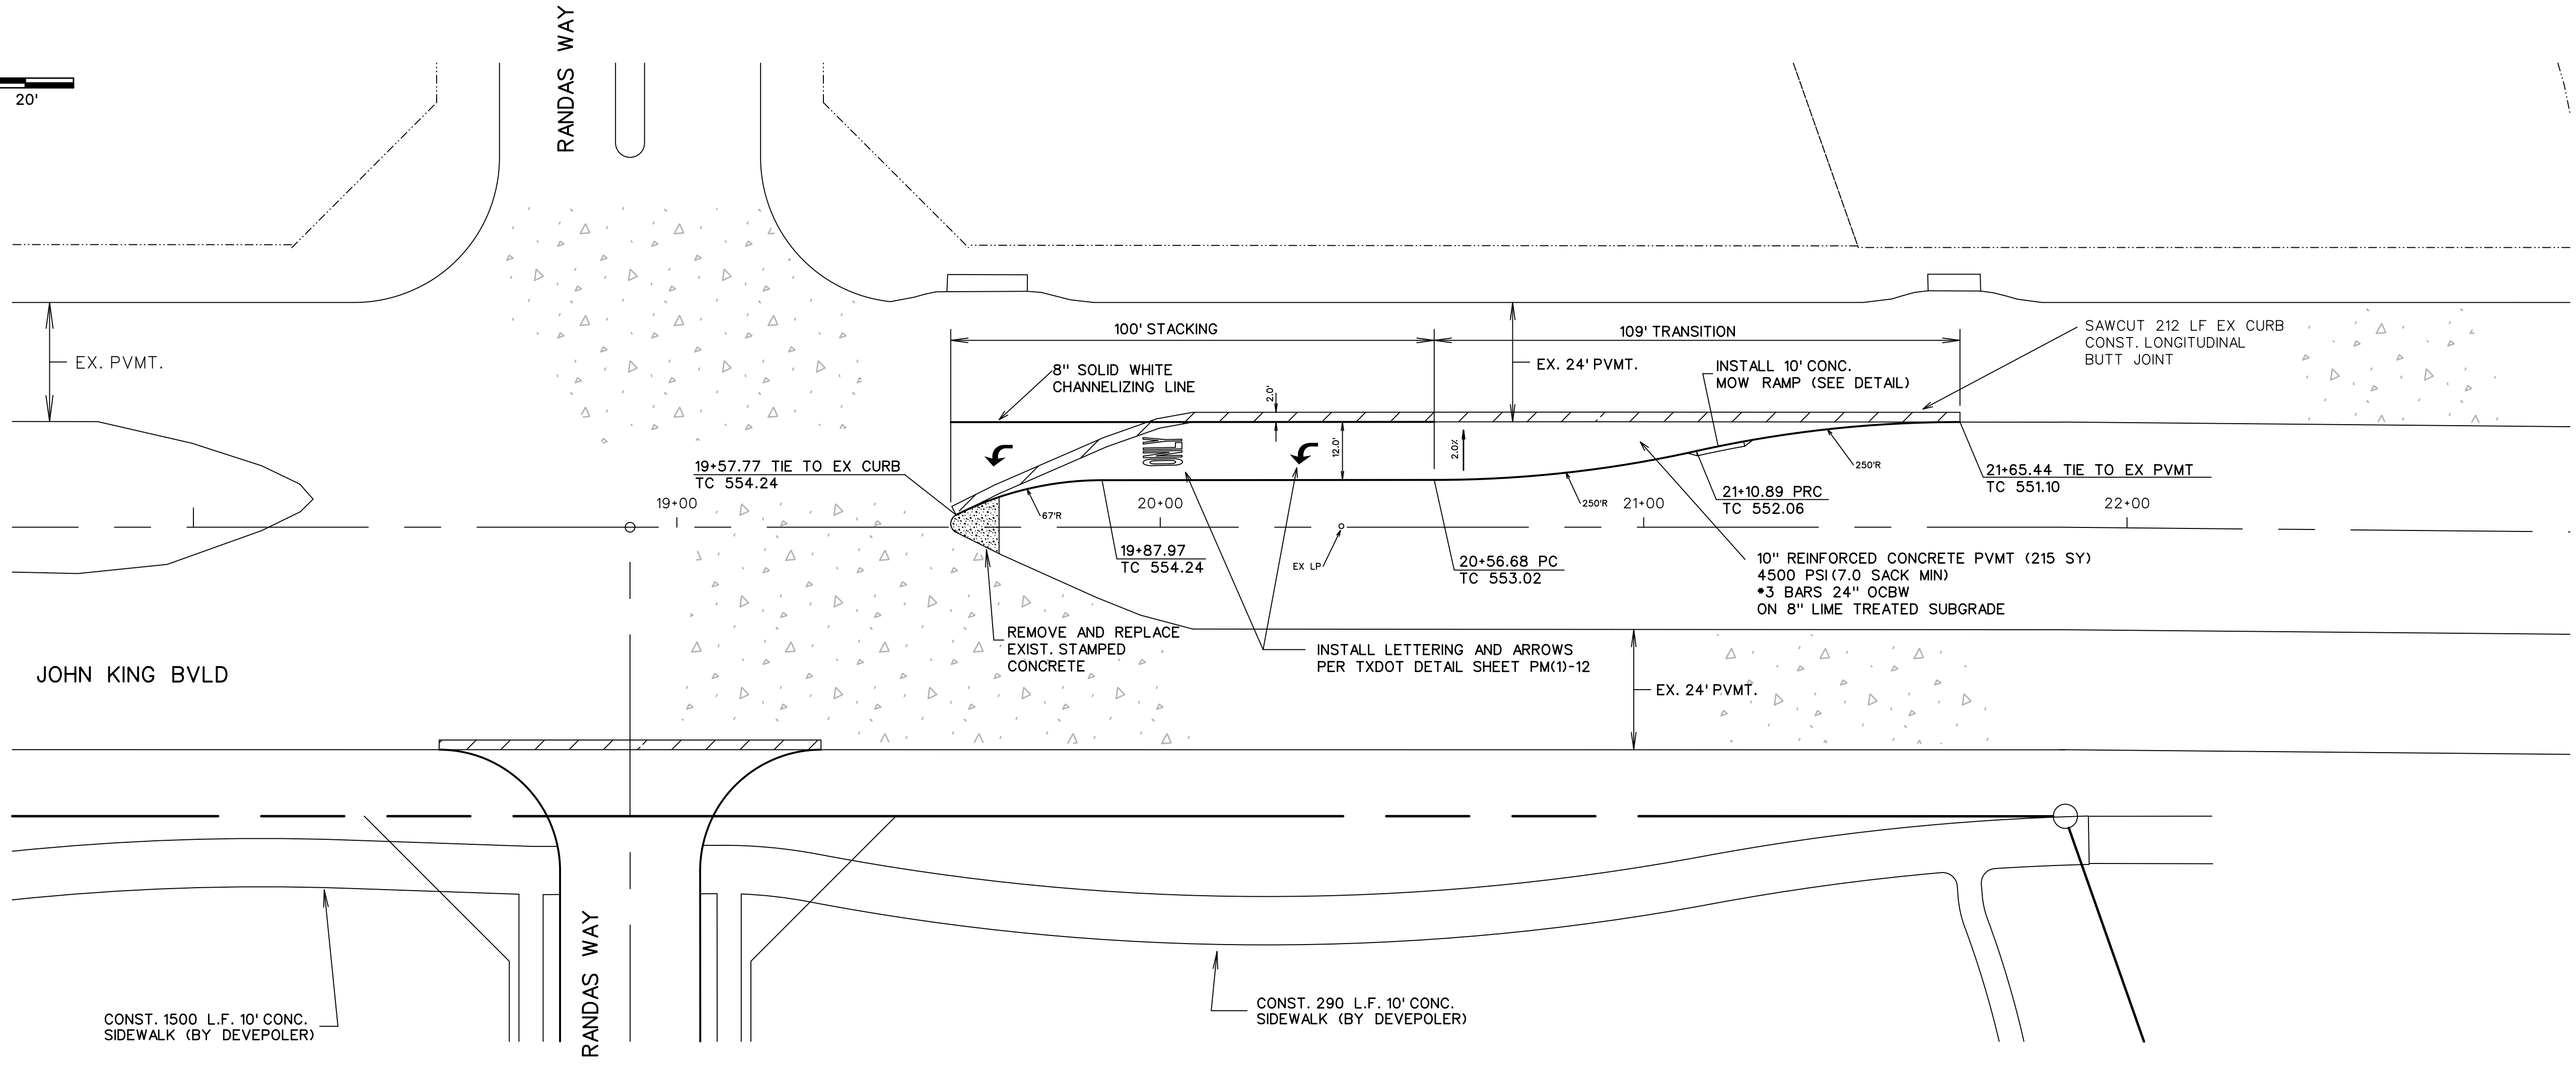

MEDIAN ISLAND PAVEMENT NOSE & LEFT TURN LANE CITY OF ROCKWALL STANDARD SPECIFICATION REFERENCE 305.3 DATE: AUG. '19 STANDARD DRAWING NO. R-2130

MEDIAN ISLAND PAVEMENT MONOLITHIC CONCRETE NOSE CITY OF ROCKWALL STANDARD SPECIFICATION REFERENCE 305.3 DATE: AUG. '19 STANDARD DRAWING NO. R-2140

RECORD DRAWINGS JANUARY 2024 INFORMATION PROVIDED BY CONTRACTORS (NOT FIELD VERIFIED)

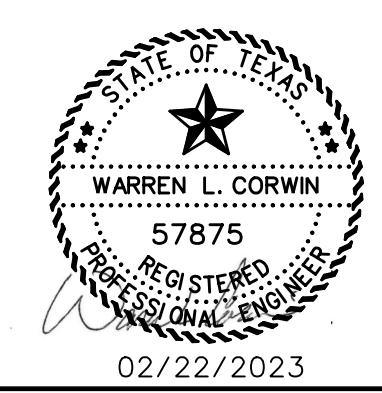

CORWIN ENGINEERING, INC.
 200 W. BELMONT, SUITE E
 ALLEN, TEXAS 75013 (972)396-1200
 TBPE FIRM #5951

**DEVELOPMENT PLANS FOR
 QUAIL HOLLOW
 PHASE I
 ROCKWALL, TEXAS**

**JOHN KING BOULEVARD
 LEFT TURN LANE**

DRAWN BY	DESIGNED BY	CHECKED BY	SHEET NO.
22036	FEBRUARY 2023	1"=20'	14