
 <b>CORWIN ENGINEERING, INC.</b> 200 W. BELMONT, SUITE E ALLEN, TEXAS 75013 (972)396-1200 TBPE FIRM #5951		<b>DEVELOPMENT PLANS FOR          QUAIL HOLLOW          PHASE I          ROCKWALL, TEXAS</b>	
SANITARY SEWER PROFILES			
DRAWN BY	DESIGNED BY	CHECKED BY	SHEET NO.
JOB NUMBER	DATE	SCALE: HOR: 1"=40' VER: 1"=4'	20
22036	FEBRUARY 2023		

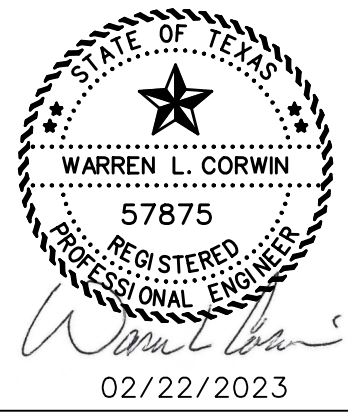

**RECORD DRAWINGS**  
 JANUARY 2024  
 INFORMATION PROVIDED  
 BY CONTRACTORS  
 (NOT FIELD VERIFIED)