


RECORD DRAWINGS
 JANUARY 2024
 INFORMATION PROVIDED
 BY CONTRACTORS
 (NOT FIELD VERIFIED)

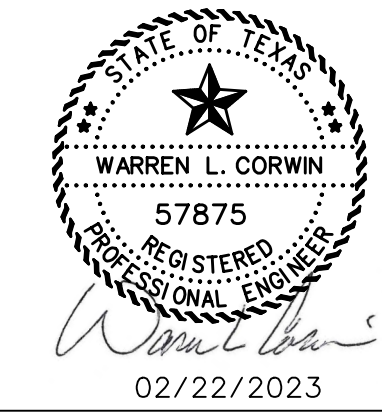

CORWIN ENGINEERING, INC.
 200 W. BELMONT, SUITE E
 ALLEN, TEXAS 75013 (972)396-1200
 TBPE FIRM #5951

DEVELOPMENT PLANS FOR
QUAIL HOLLOW
 PHASE I
 ROCKWALL, TEXAS

SANITARY SEWER PROFILE

DRAWN BY 22036	DESIGNED BY FEBRUARY 2023	CHECKED BY SCALE: HOR: 1"=40' VER: 1"=4'	SHEET NO. 22
-------------------	------------------------------	--	------------------------