
 **CORWIN ENGINEERING, INC.**
 200 W. BELMONT, SUITE E
 ALLEN, TEXAS 75013 (972)396-1200
 TBPE FIRM #5951

DEVELOPMENT PLANS FOR
QUAIL HOLLOW
 PHASE I
 ROCKWALL, TEXAS

SANITARY SEWER PROFILES

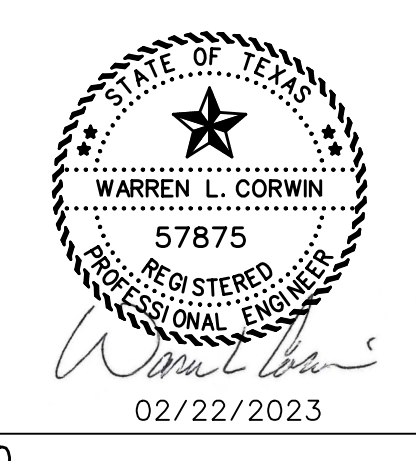

RECORD DRAWINGS
 JANUARY 2024
 INFORMATION PROVIDED
 BY CONTRACTORS
 (NOT FIELD VERIFIED)

| | | | |
|------------|---------------|----------------------------------|-----------|
| DRAWN BY | DESIGNED BY | CHECKED BY | SHEET NO. |
| JOB NUMBER | DATE | SCALE: HOR: 1"=40' VER: 1"=4' | 23 |
| 22036 | FEBRUARY 2023 | | |