



CONSTRUCTION SEQUENCE


1. GRADING CONTRACTOR TO INSTALL TEMPORARY STABILIZED ENTRANCE.
2. INSTALL SILT FENCE AS SHOWN, (TS-600 POLY FELT) PER C.O.G. SPECIFICATIONS.
3. PERFORM GRADING AND UTILITY CONSTRUCTION.
4. AFTER THE INLET BOTTOMS ARE CONSTRUCTED, THE INLETS SHALL BE FILLED WITH STONE AND COVERED WITH A FILTER FABRIC (TS-600 POLY FELT OR EQUIVALENT) BY UTILITY CONTRACTOR.
5. PRIOR TO CITY RELEASING PAVING, SOD OR SEEDED CURLEX SHALL BE INSTALLED ON SIDES AND BOTTOM OF ALL DETENTION PONDS.
6. AFTER PAVING AND COMPLETION OF INLETS, INLET FILTERS SHALL BE INSTALLED IN ALL INLETS AND MAINTAINED UNTIL RE-VEGETATION HAS BEEN COMPLETED BY PAVING CONTRACTOR.
7. SILT FENCE SHALL REMAIN IN PLACE UNTIL RE-VEGETATION HAS BEEN COMPLETED.
8. PAVING CONTRACTOR SHALL REMOVE TEMPORARY STABILIZED ENTRANCE.
9. PRIOR TO CITY ACCEPTANCE THE PAVING CONTRACTOR SHALL BE RESPONSIBLE FOR REMOVING ANY MUD OR SILT WHICH COLLECTS ON THE EXISTING AND NEW PAVEMENT.
10. PRIOR TO CITY ACCEPTANCE 75-80% OF ALL DISTURBED AREA SHALL HAVE A MIN. 1" TALL GRASS ESTABLISHED.
11. 75-80% OF ALL DISTURBED AREA TO HAVE 1" HIGH GRASS ESTABLISHED PRIOR TO ENGINEERING ACCEPTANCE.
12. ALL BAR DITCHES TO BE ANCHORED, SEEDED & CURLEXED PRIOR TO ACCEPTANCE OF GRASS ISN'T ESTABLISHED.

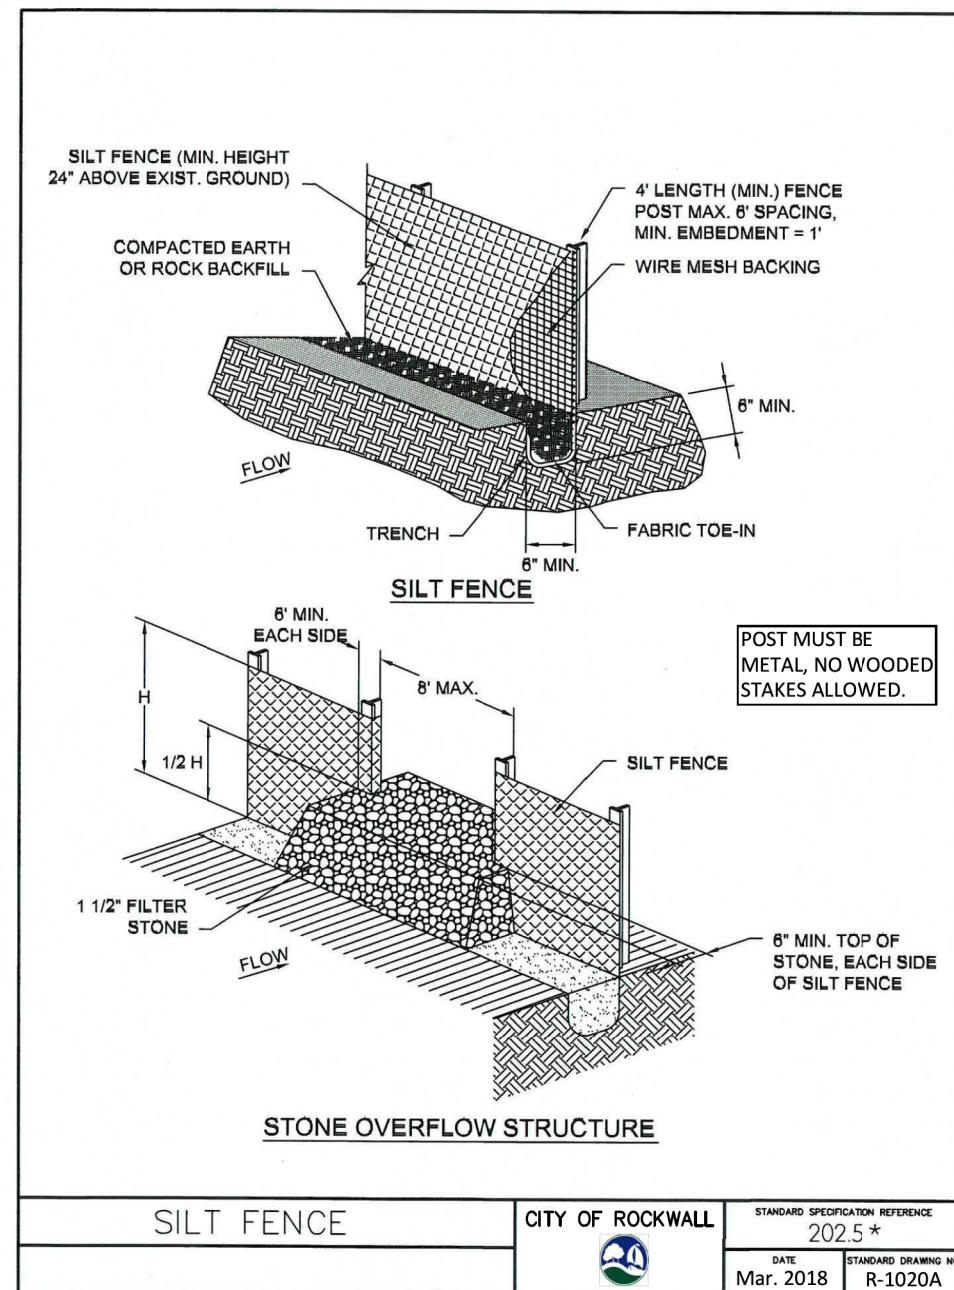


SILT FENCE CITY OF ROCKWALL STANDARD SPECIFICATION REFERENCE 202.5 \* DATE: Mar. 2018 STANDARD DRAWING NO. R-1020A

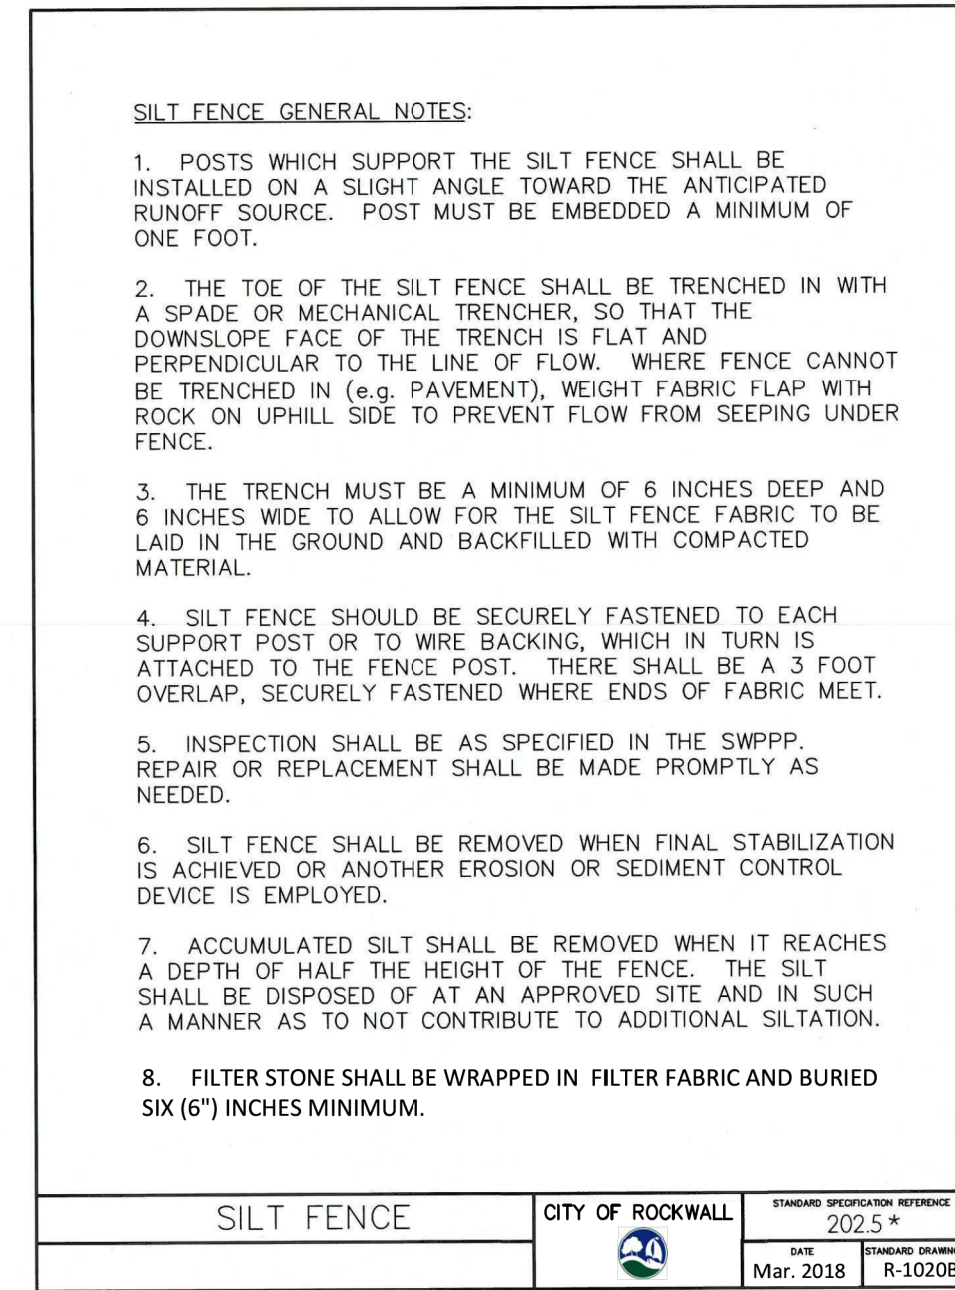


SILT FENCE CITY OF ROCKWALL STANDARD SPECIFICATION REFERENCE 202.5 \* DATE: Mar. 2018 STANDARD DRAWING NO. R-1020B

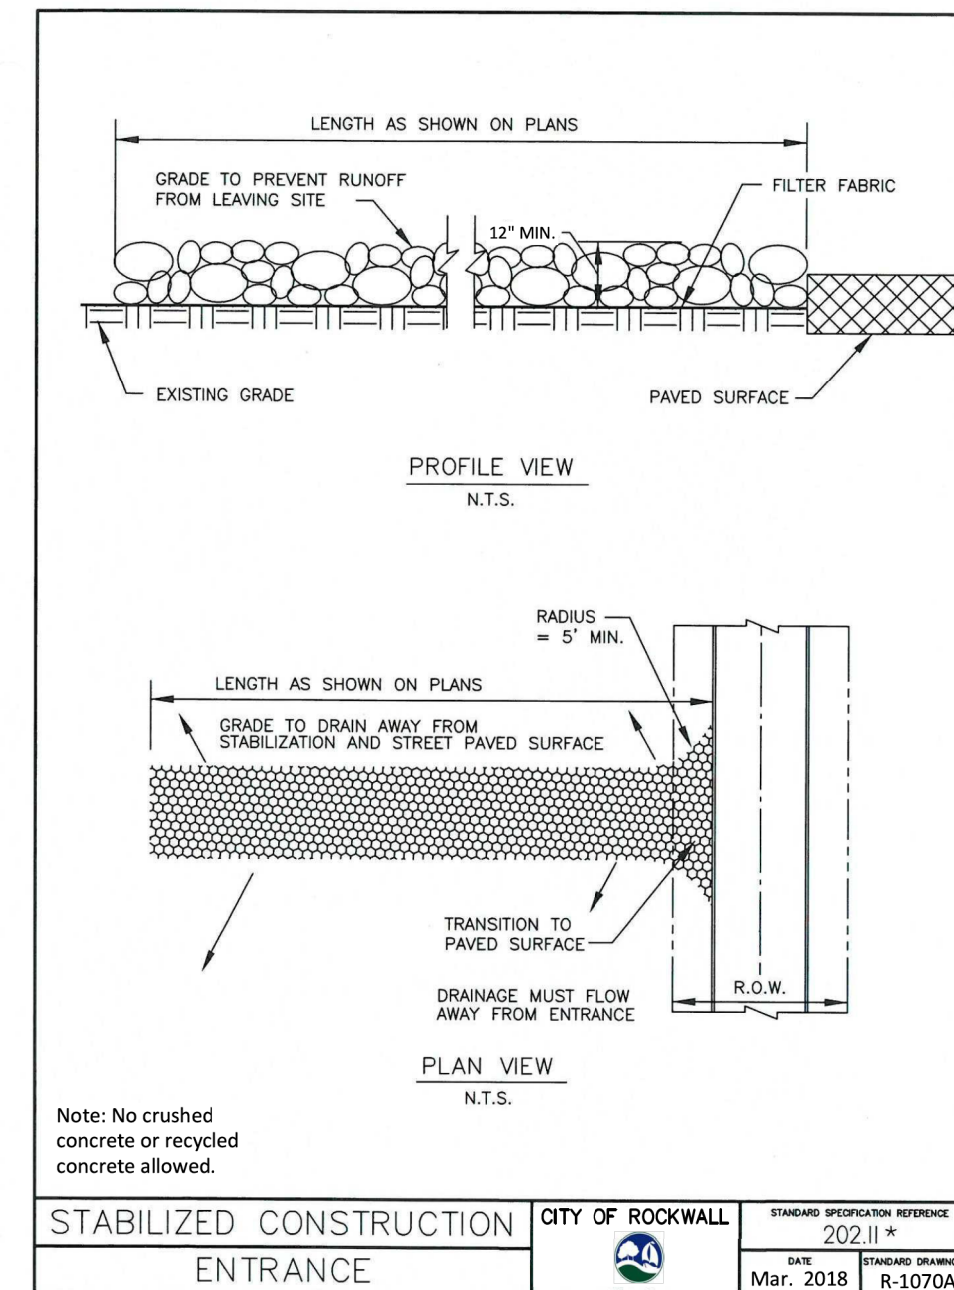


STABILIZED CONSTRUCTION ENTRANCE CITY OF ROCKWALL STANDARD SPECIFICATION REFERENCE 202.11 \* DATE: Mar. 2018 STANDARD DRAWING NO. R-1070A

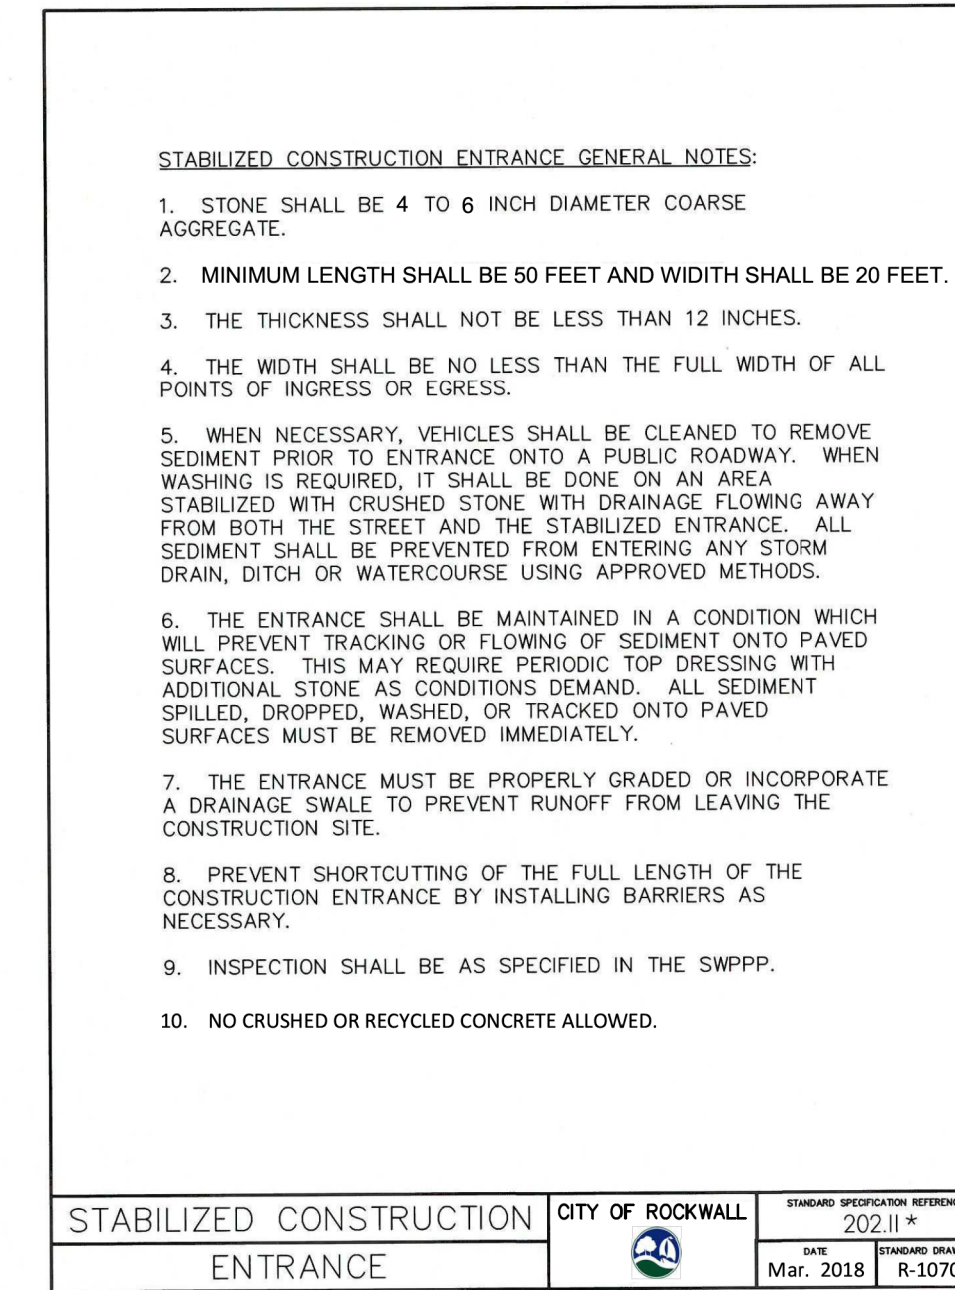

STABILIZED CONSTRUCTION ENTRANCE CITY OF ROCKWALL STANDARD SPECIFICATION REFERENCE 202.11 \* DATE: Mar. 2018 STANDARD DRAWING NO. R-1070B

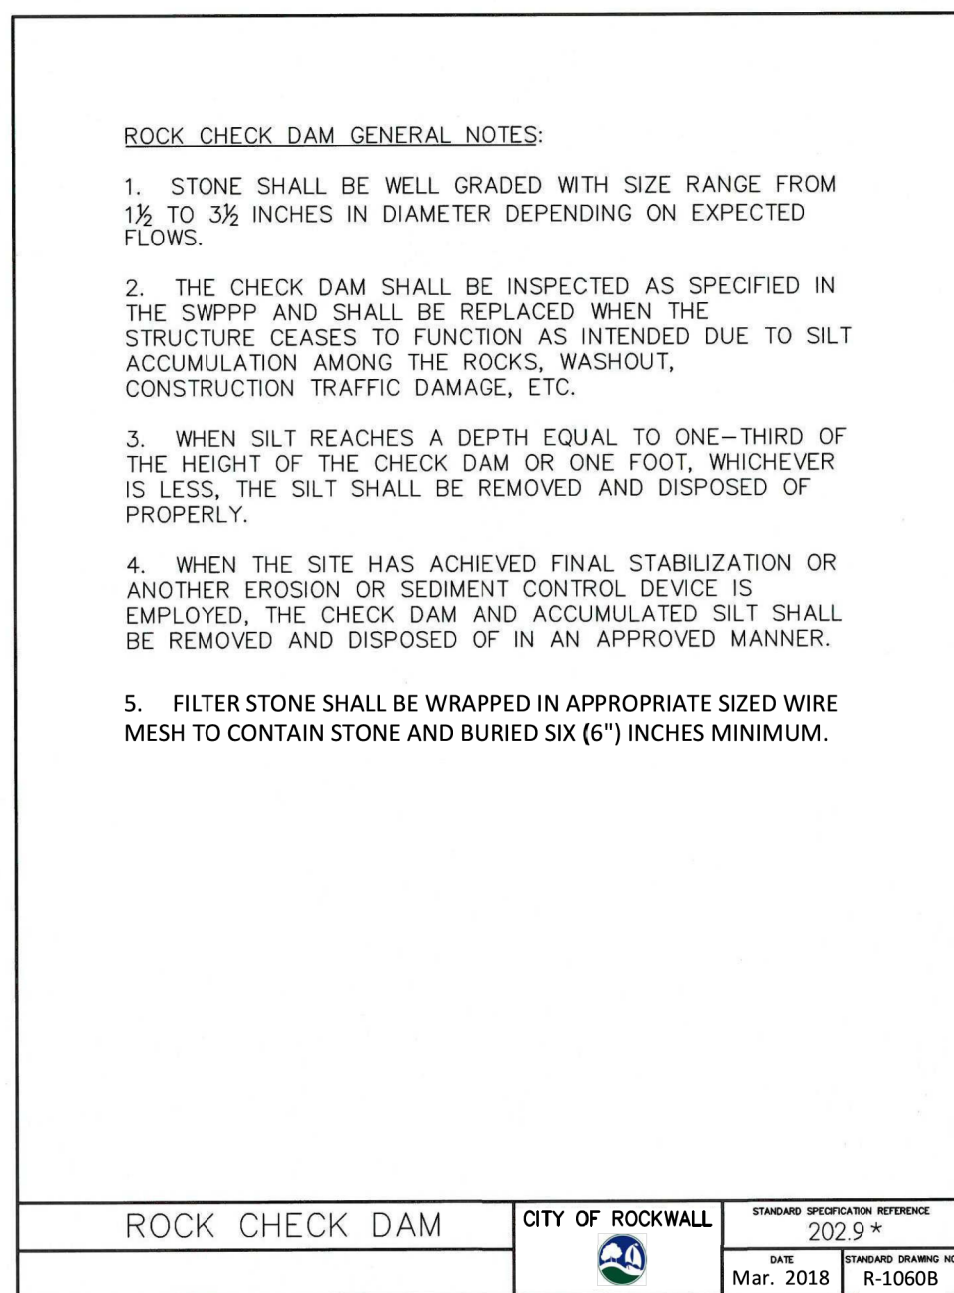


ROCK CHECK DAM CITY OF ROCKWALL STANDARD SPECIFICATION REFERENCE 202.9 \* DATE: Mar. 2018 STANDARD DRAWING NO. R-1060B

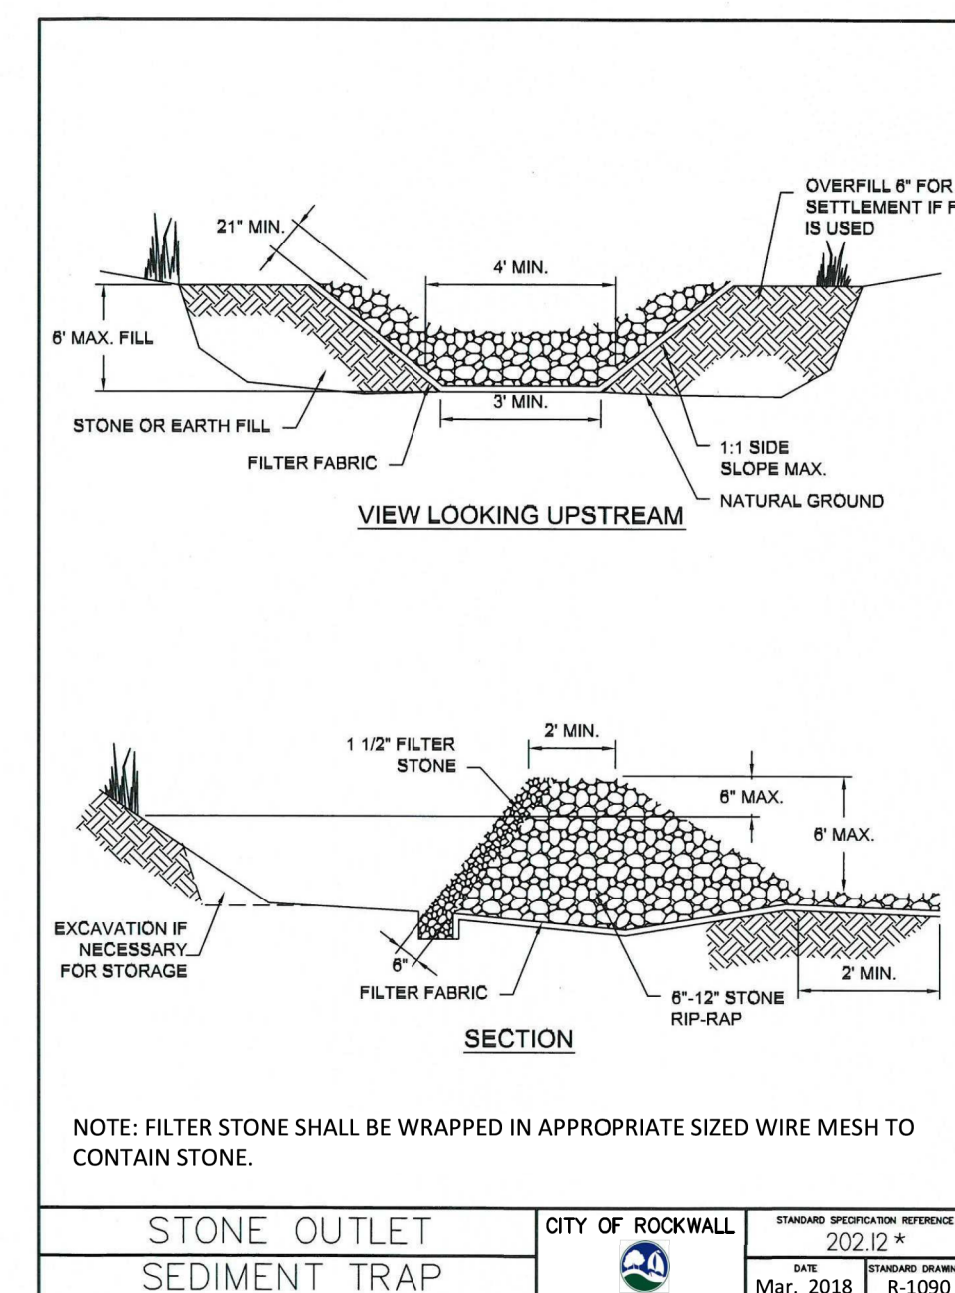

STONE OUTLET SEDIMENT TRAP CITY OF ROCKWALL STANDARD SPECIFICATION REFERENCE 202.12 \* DATE: Mar. 2018 STANDARD DRAWING NO. R-1090

RECORD DRAWINGS  
JANUARY 2024  
INFORMATION PROVIDED  
BY CONTRACTORS  
(NOT FIELD VERIFIED)

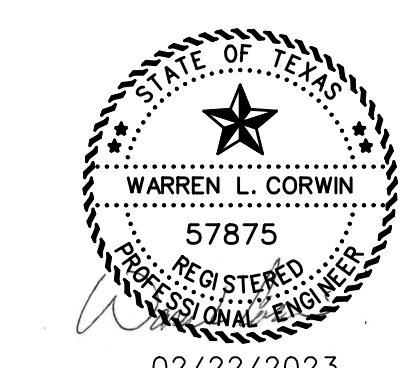

**CORWIN ENGINEERING, INC.**  
200 W. BELMONT, SUITE E  
ALLEN, TEXAS 75013 (972)396-1200  
TBPE FIRM #5951

**DEVELOPMENT PLANS FOR  
QUAIL HOLLOW  
PHASE I  
ROCKWALL, TEXAS**

EROSION CONTROL PLAN

DRAWN BY	DESIGNED BY	CHECKED BY	SHEET NO.
JOB NUMBER	DATE	SCALE:	39
22036	FEBRUARY 2023	1"=100'	

02/22/2023