


DEVELOPMENT PLANS FOR QUAIL RUN LIFT STATION FORCE MAIN UPGRADE

CITY OF ROCKWALL, TEXAS

QUAIL RUN LIFT STATION
FORCE MAIN UPGRADE
13088

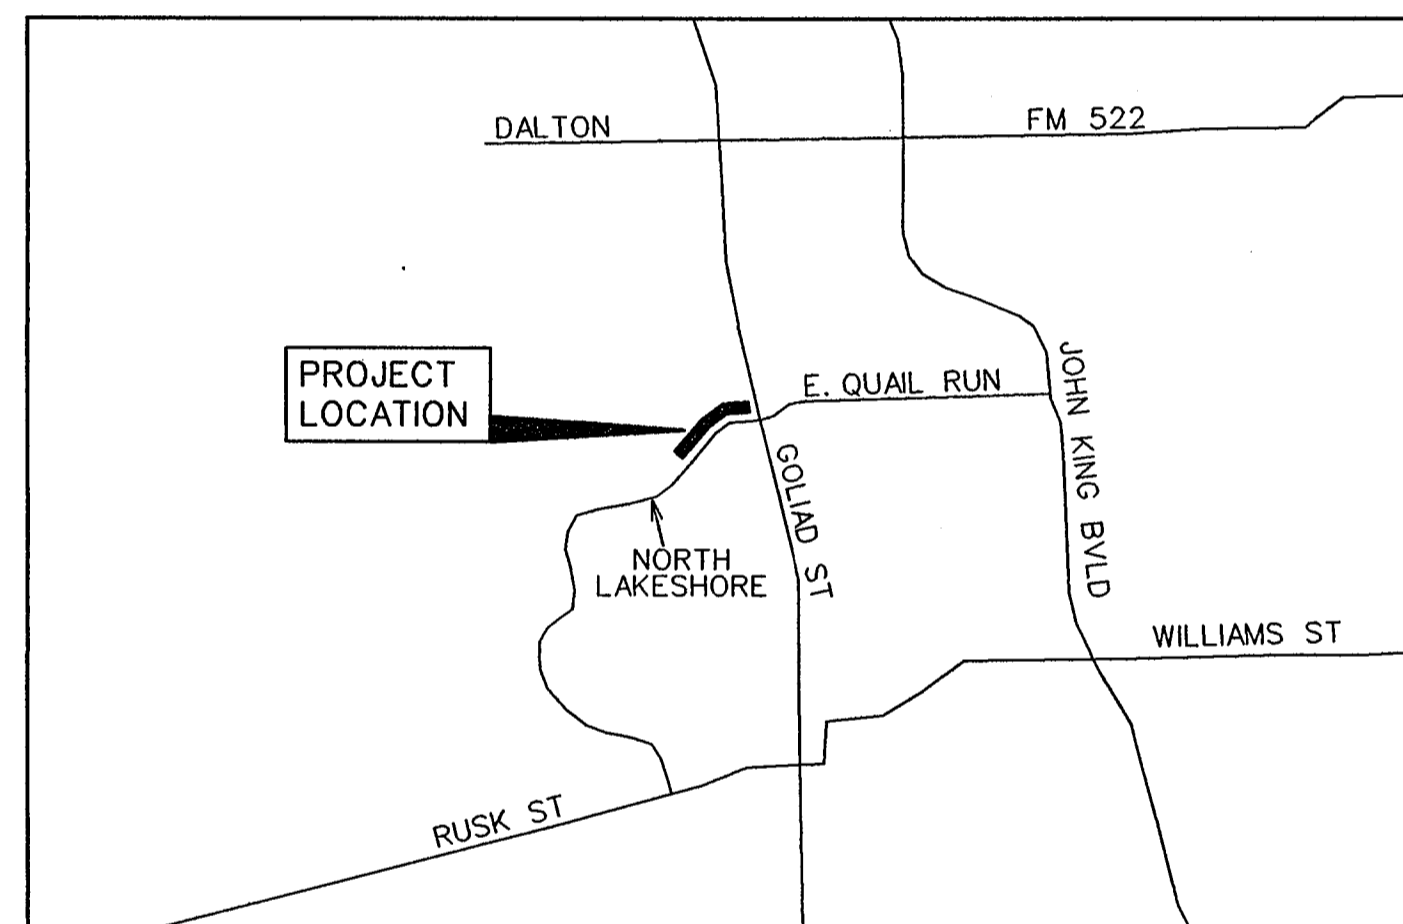

VICINITY MAP
NOT TO SCALE

INDEX

- 1 FORCE MAIN PLAN & PROFILE STATION 1+00 - 10+00
- 2 FORCE MAIN PLAN & PROFILE STATION 10+00 - END
- 3 EROSION CONTROL PLAN
- TS1 TREE SURVEY AND MITIGATION PLAN

PREPARED FOR
BH PHASE 1 SF, LTD.
8214 WESTCHESTER DRIVE, SUITE 710 DALLAS, TEXAS 75225

CORWIN ENGINEERING, INC. — CONSULTING ENGINEERS


200 W. BELMONT, SUITE E

TBPE FIRM #5951

ALLEN, TEXAS 75013

NOTE:

CITY OF ROCKWALL STANDARDS
AND NCTCOG 3rd ADDITION STANDARDS
SHALL BE USED FOR REFERENCE.

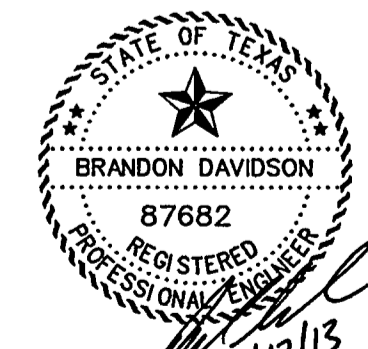

AS-BUILT DECEMBER 2013
BASED ON SURVEYING AT THE
SITE AND INFORMATION
PROVIDED BY THE CONTRACTOR

The seal appearing on
this document was
authorized by
Brandon Davidson
P.E. 87682, on
December 17, 2013

NO.	REVISIONS	BY	DATE

SEPTEMBER 2013