

BENCH MARK
SQUARE CUT IN CONCRETE AT BASE OF
CONCRETE WALL AT S.W. CORNER OF
SOUTH APPROACH TO BRIDGE OVER
SQUIBBLE CREEK ON HWY. 205
ELEV.: 472.41

BENCH MARK
60D NAIL IN 36" PECAN TREE (TREE NO. 2314)
PAV. STA. 1+83, 138" RT., AUDOBON LANE
ELEV.: 480.88

BENCH MARK
60D NAIL IN 36" PECAN TREE (TREE NO. 2302)
PAV. STA. 8+30, 71" RT., MEMORIAL DRIVE
ELEV.: 466.79

BENCH MARK
60D NAIL IN 18" PECAN TREE (TREE NO. 2114)
PAV. STA. 10+97 63.5" RT., AUDOBON LANE
ELEV.: 501.54


REVISION DESCRIPTION	DATE	SCALE	DESIGN	DRAWN
REV. PER 3rd CITY REVIEW	6/12/01	1" = 40'	H.L.E.	
REV. PER 2nd CITY REVIEW	5/7/01	1" = 6'		
REV. PER CITY REVIEW	2/24/01			

HAROLD L. EVANS
CONSULTING ENGINEER
P.O. BOX 28355
2331 GUS THOMASSON ROAD, SUITE 102
DALLAS, TEXAS 75228, (214) 328-8133

DATE: 11/6/00
SCALE: 1" = 40'
DESIGN: H.L.E.
DRAWN: H.L.E.

PROPOSED PAVING
QUAIL RUN ROAD
QUAIL RUN VALLEY NO. 1
CITY OF ROCKWALL

Winkelmann & Associates, Inc. hereby states that this plan is the best of our knowledge as "As Built".
Master's use from the originally approved construction documents have been made as per information provided to the contractor Winkelmann & Associates, Inc. does not warrant the quality of construction as no field inspection was performed.
Winkelmann & Associates, Inc. DATE: 4/10/02

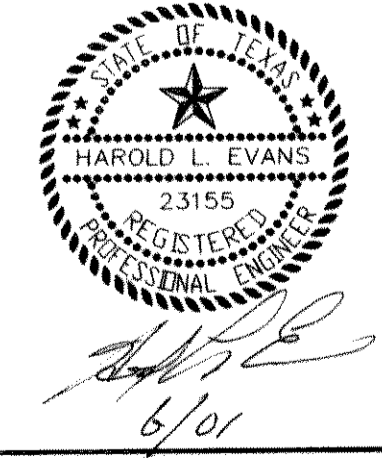

SHEET NO.
10
21
JOB NO.
0020