


- ▲ 12/20/01 ADDED WALLS (RB)
- ▲ REMOVED 20 TREES & WILL BE REPLACED PER CITY ORDINANCE
- ▲ WALLS PER "AS-BUILT"

- ▲ 10/17/01 DELETED WALLS (RB)
- ▲ 10/17/01 REVISED WALL ELEVATIONS (RB)
- ▲ 10/17/01 ADDED WALLS (RB)

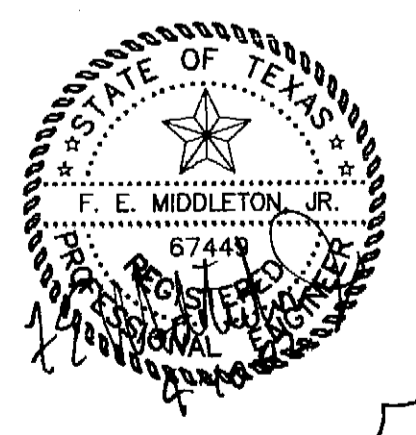

BENCH MARK
 SQUARE CUT IN CONCRETE AT BASE OF
 CONCRETE WALL AT S.W. CORNER OF
 SOUTH APPROACH TO BRIDGE OVER
 SQUABBLE CREEK ON HWY. 206
 ELEV.: 478.41


BENCH MARK
 60D NAIL IN 36" PECAN TREE (TREE NO. 2802)
 PAV. STA. 8+30, 71' RT., MEMORIAL DRIVE
 ELEV.: 486.79

BENCH MARK
 60D NAIL IN 34" PECAN TREE (TREE NO. 2314)
 PAV. STA. 1+88, 138' RT., AUDOBON LANE
 ELEV.: 480.88

BENCH MARK
 60D NAIL IN 18" PECAN TREE (TREE NO. 2114)
 PAV. STA. 10+87 88.5' RT., AUDOBON LANE
 ELEV.: 501.54

Winkelman & Associates, Inc. hereby states that this plan, to the best of our knowledge is "As Built".
 Modifications from the originally approved construction documents have been made as per information provided by the contractor. Winkelman & Associates, Inc. does not certify as to the correctness or quality of construction as no field inspection was performed.

J. S. Middleton
 WINKELMAN & ASSOCIATES, INC. DATE 4-10-02

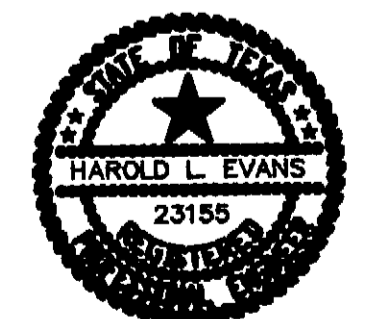

ADDED WALLS/DELETED TREES & WALLS	12/20/01
REV. PER 2nd CITY REVIEW	5/9/01
REV. PER CITY REVIEW	2/25/01

HAROLD L. EVANS
 CONSULTING ENGINEER
 P.O. BOX 28855
 2331 CUS THOMASSON ROAD, SUITE 102
 DALLAS, TEXAS 75228, (214) 328-8188

LOT GRADING PLAN	
QUAIL RUN VALLEY NO. 1	
CITY OF ROCKWALL	

REVISION	DESCRIPTION	DATE	SCALE	DESIGN	DRAWN
0000001		11/6/00	1" = 40'	H.L.E.	

SHEET NO.	19
	21
JOB NO.	0020