


▲ 10/17/01 DELETED WALLS (RB)
 ▲ WALLS PER "AS BUILT"

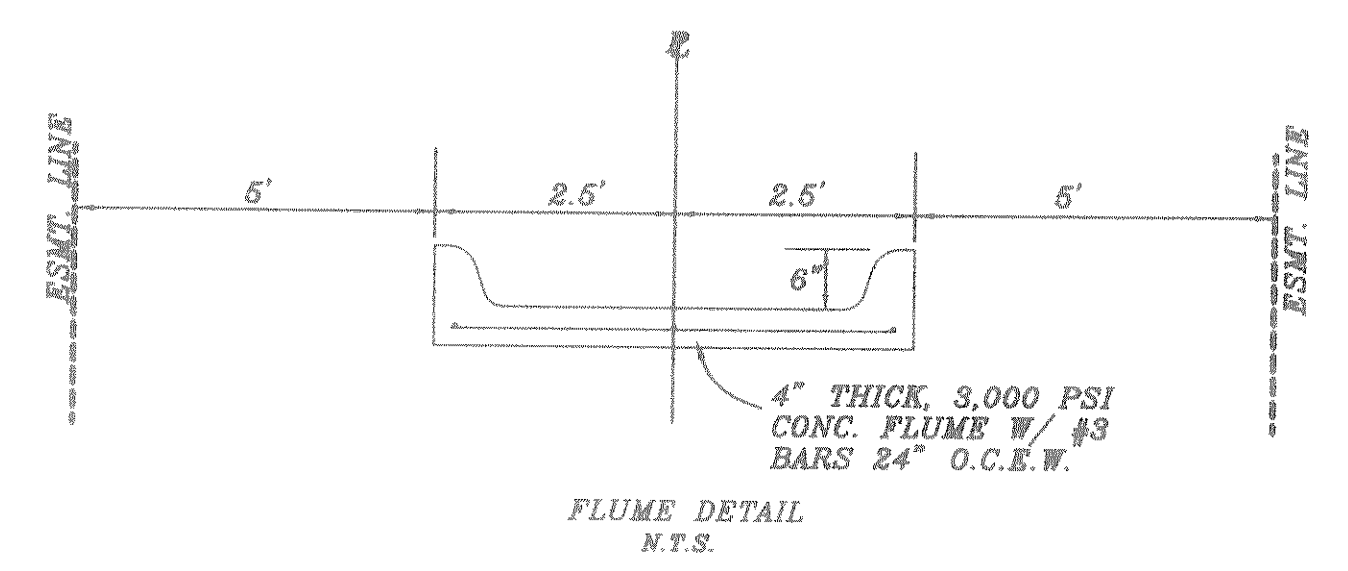

BENCH MARK
 SQUARE CUT IN CONCRETE AT BASE OF CONCRETE WALL AT S.E. CORNER OF SOUTH APPROACH TO BRIDGE OVER SQUARE CREEK ON HWY. 205
 ELEV.: 472.41

BENCH MARK
 60D NAIL IN 34" PECAN TREE (TREE NO. 2314)
 PAV. STA. 1+83.138' RT., AUDOBON LANE
 ELEV.: 480.88


BENCH MARK
 60D NAIL IN 36" PECAN TREE (TREE NO. 2302)
 PAV. STA. 8+30.71' RT., MEMORIAL DRIVE
 ELEV.: 486.79

BENCH MARK
 60D NAIL IN 18" PECAN TREE (TREE NO. 2114)
 PAV. STA. 10+97.63.5' RT., AUDOBON LANE
 ELEV.: 501.54

ASBUILT

Winkelman & Associates, Inc. hereby states that this plan, to the best of our knowledge is "As Built." Modifications have been made as per information provided by the contractor. Winkelman & Associates, Inc. does not certify as to the correctness or quality of construction as no field inspection was performed.

H. L. Evans
 HAROLD L. EVANS
 WINKELMANN & ASSOCIATES, INC. DATE 4/8/02

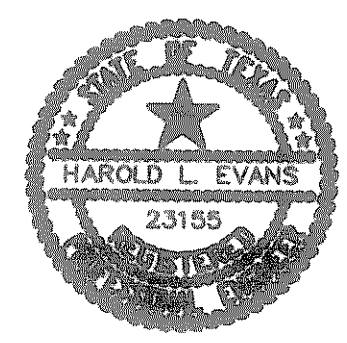

HAROLD L. EVANS CONSULTING ENGINEER P.O. BOX 28865 2331 GUS THOMASSON ROAD, SUITE 102 DALLAS, TEXAS 75226, (214) 388-8133		LOT GRADING PLAN QUAIL RUN VALLEY NO. 1 CITY OF ROCKWALL		SHEET NO. 20 21 JOB NO. 0020
REVISION DESCRIPTION 00000000	DATE 11/6/00	SCALE 1" = 40'	DESIGN H.L.E.	DRAWN