

BENCH MARK
 SQUARE CUT IN CONCRETE AT BASE OF
 CONCRETE WALL AT S.W. CORNER OF
 SOUTH APPROACH TO BRIDGE OVER
 SQUABBLE CREEK ON HWY 205
 ELEV: 472.41

BENCH MARK
 60D NAIL IN 3" PECAN TREE (TREE NO. 2314)
 PAV. STA 1+83, 138" RT., AUDOBON LANE
 ELEV: 480.88


BENCH MARK
 60D NAIL IN 36" PECAN TREE (TREE NO. 2302)
 PAV. STA 8+30, 71" RT., MEMORIAL DRIVE
 ELEV: 466.79

BENCH MARK
 60D NAIL IN 18" PECAN TREE (TREE NO. 2114)
 PAV. STA 10+97 63.5" RT., AUDOBON LANE
 ELEV: 501.54

ASBUILT

Winkelmann & Associates, Inc. hereby states that this plan, to the best of our knowledge is "As Built." Modifications from the originally approved construction documents have been made as per information provided by the contractor. Winkelmann & Associates, Inc. does not certify as to the correctness or quality of construction as no field inspection was performed.

9/27/02
 DATE PH 2A

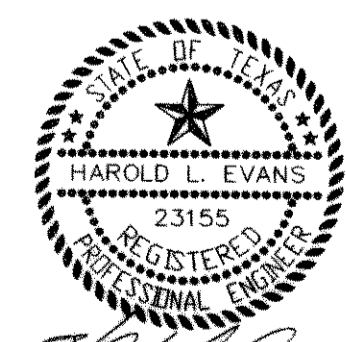

CURVE	RADIUS	LENGTH	TANGENT	CHORD	BEARING	DELTA
C1	212.41'	282.47'	166.54'	262.11'	N34°38'36" E	76°11'44"
C2	30.00'	19.05'	10.31'	18.33'	S16°46'51" W	54°33'41"
C3	20.00'	19.05'	10.31'	18.33'	N37°46'49" W	54°33'41"
C4	39.50'	99.66'	123.63'	75.25'	N28°13'09" W	144°33'41"
C5	39.50'	99.66'	123.63'	75.25'	S07°13'11" W	144°33'41"

PHASE 2A

REV. PER 2nd REVIEW	5/10/01	HAROLD L. EVANS CONSULTING ENGINEER P.O. BOX 28355 2331 CUS THOMASSON ROAD, SUITE 102 DALLAS, TEXAS 75228, (214) 328-8133	PROPOSED PAVING PILGRIM CT. AND ALLEY D-2 QUAIL RUN VALLEY NO. 2 CITY OF ROCKWALL		SHEET NO. 8
REVISION DESCRIPTION	2/1/01				JOB NO. 0020
DATE	2/1/01	SCALE	DESIGN	DRAWN	
		1" = 40'	H.L.E.		
		1" = 6"			