

PROPOSED PAVING
QUAIL RUN ROAD
QUAIL RUN VALLEY NO 2
CITY OF ROCKWALL

REVISION DESCRIPTION	DATE	SCALE	DESIGN	DRAWN
REV. PER 3RD REVIEW	5/10/01			
REV. PER 2ND REVIEW	5/10/01			

DATE: 5/10/01
 F = 40'
 H.L.E.
 H.A.S. 2315



HAROLD L. EVANS
 CONSULTING ENGINEER
 P. O. BOX 28365
 DALLAS, TEXAS 75228, (214) 328-8133

Withmann & Associates, Inc. hereby states that this plan, to the best of our knowledge is "As Built" and modifications from the originally approved construction documents have been made as per information provided by the contractor. Withmann & Associates, Inc. goes not certify as to the correctness or quality of construction as no field inspection was performed.

WITNESSED AND APPROVED:
 HAROLD L. EVANS
 REGISTERED PROFESSIONAL ENGINEER
 STATE OF TEXAS
 23155

DATE: 5-22-02
 DATE: 5-28-02

BENCH MARK
 SQUARE CUT IN CONCRETE AT BASE OF
 CONCRETE PILL AT S.W. CORNER OF
 SOUTH APPROACH TO BRIDGE OVER
 SQUABBLE CREEK ON HWY. 205
 ELEV. 472.41
 BENCH MARK
 600 NAIL IN 36" PECAN TREE (TREE NO. 2302)
 PAV. STA 10+97.63
 ELEV. 468.79
 BENCH MARK
 600 NAIL IN 18" PECAN TREE (TREE NO. 2114)
 PAV. STA 10+97.63
 ELEV. 501.54

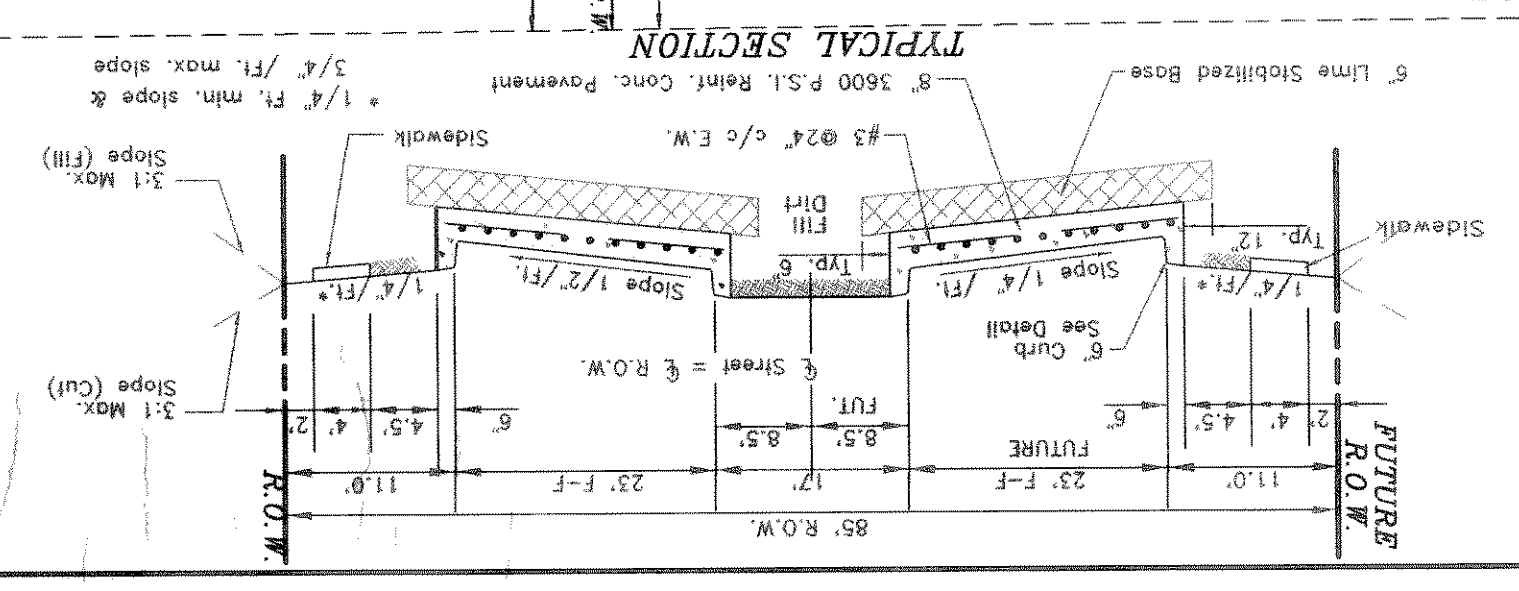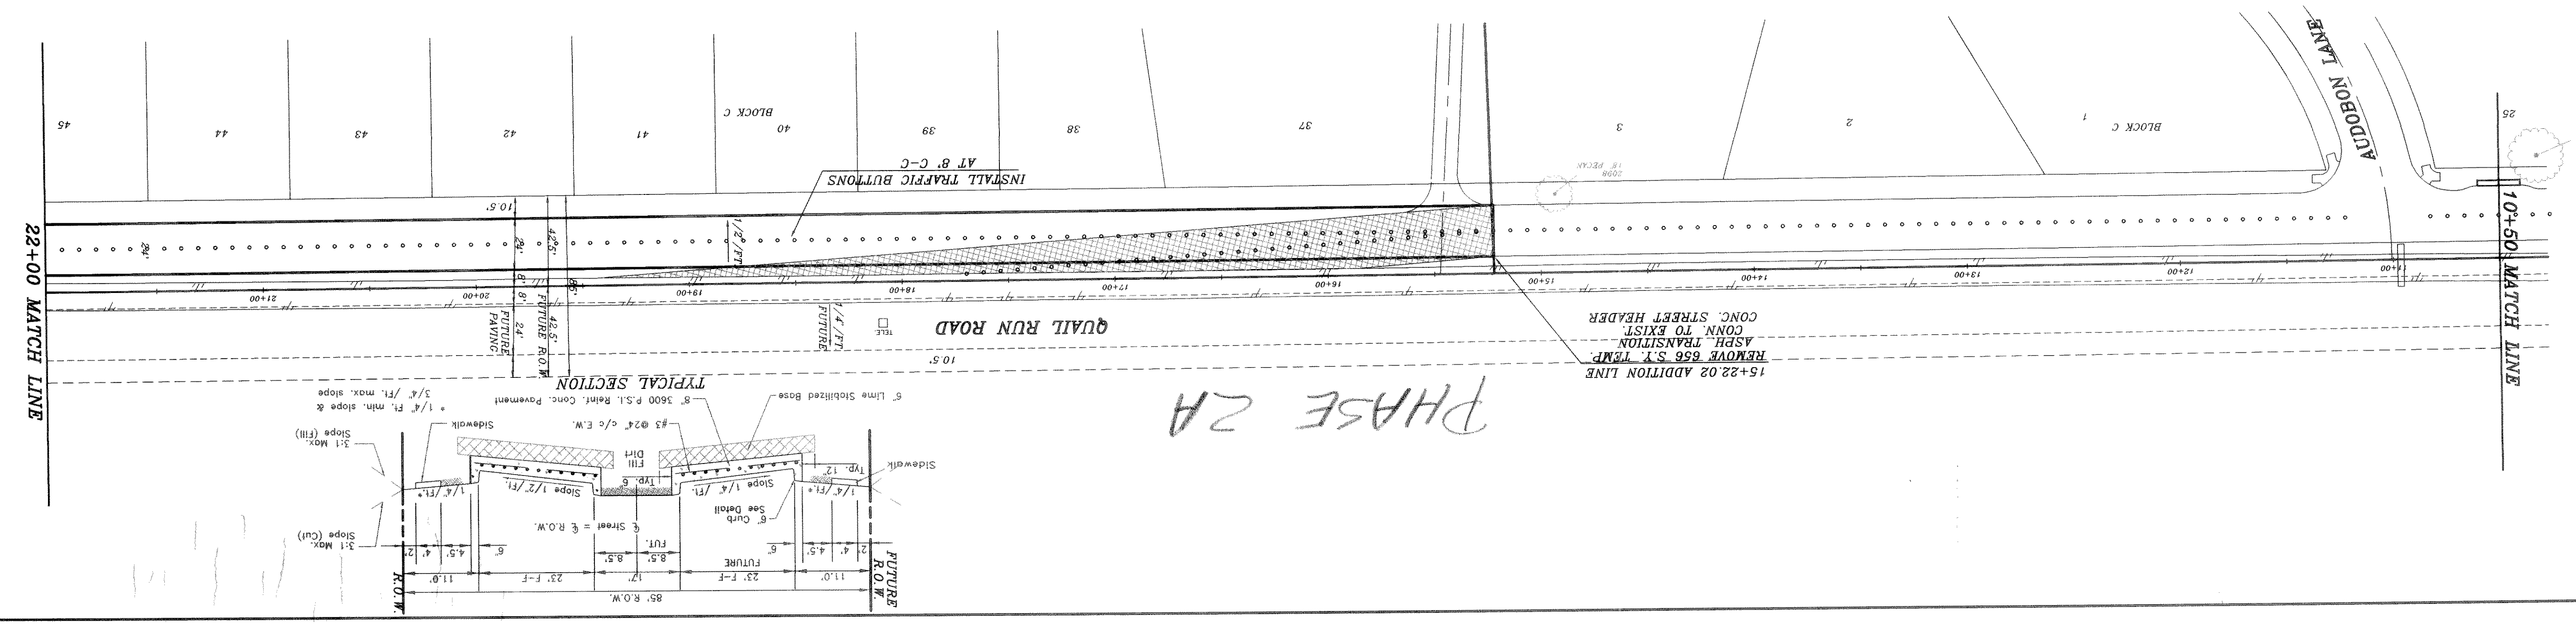

PHASE 2A