


BENCH MARK
SQUARE CUT IN CONCRETE AT BASE OF
SOUTH APPROACH TO BRIDGE OVER
SQUIBBLE CREEK ON HWY. 205
ELEV.: 422.41
BENCH MARK
600 NAIL IN 36' PECAN TREE (TREE NO. 2114)
PAY. STA. 8+30.71 RT. MEMORIAL DRIVE
ELEV.: 468.78
BENCH MARK
600 NAIL IN 36' PECAN TREE (TREE NO. 2114)
PAY. STA. 10+97.63 S. RT. AUDUBON LAKE
ELEV.: 501.54



Winkelmann & Associates, Inc. hereby states that this plan, to the best of our knowledge as "As Built", conforms to the original approved construction documents. Winkelmann & Associates, Inc. does not certify as to the correctness or quality of construction as no field inspection was performed.
DATE: 4-27-02

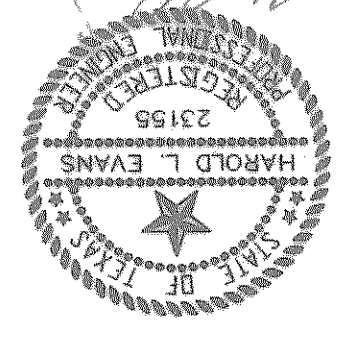