
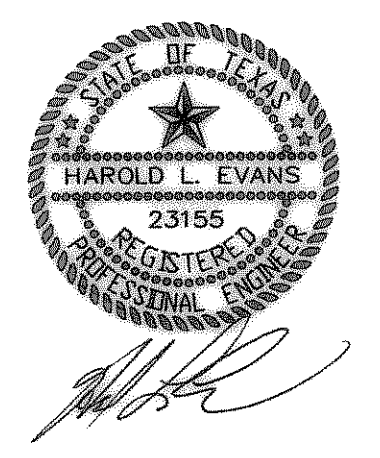
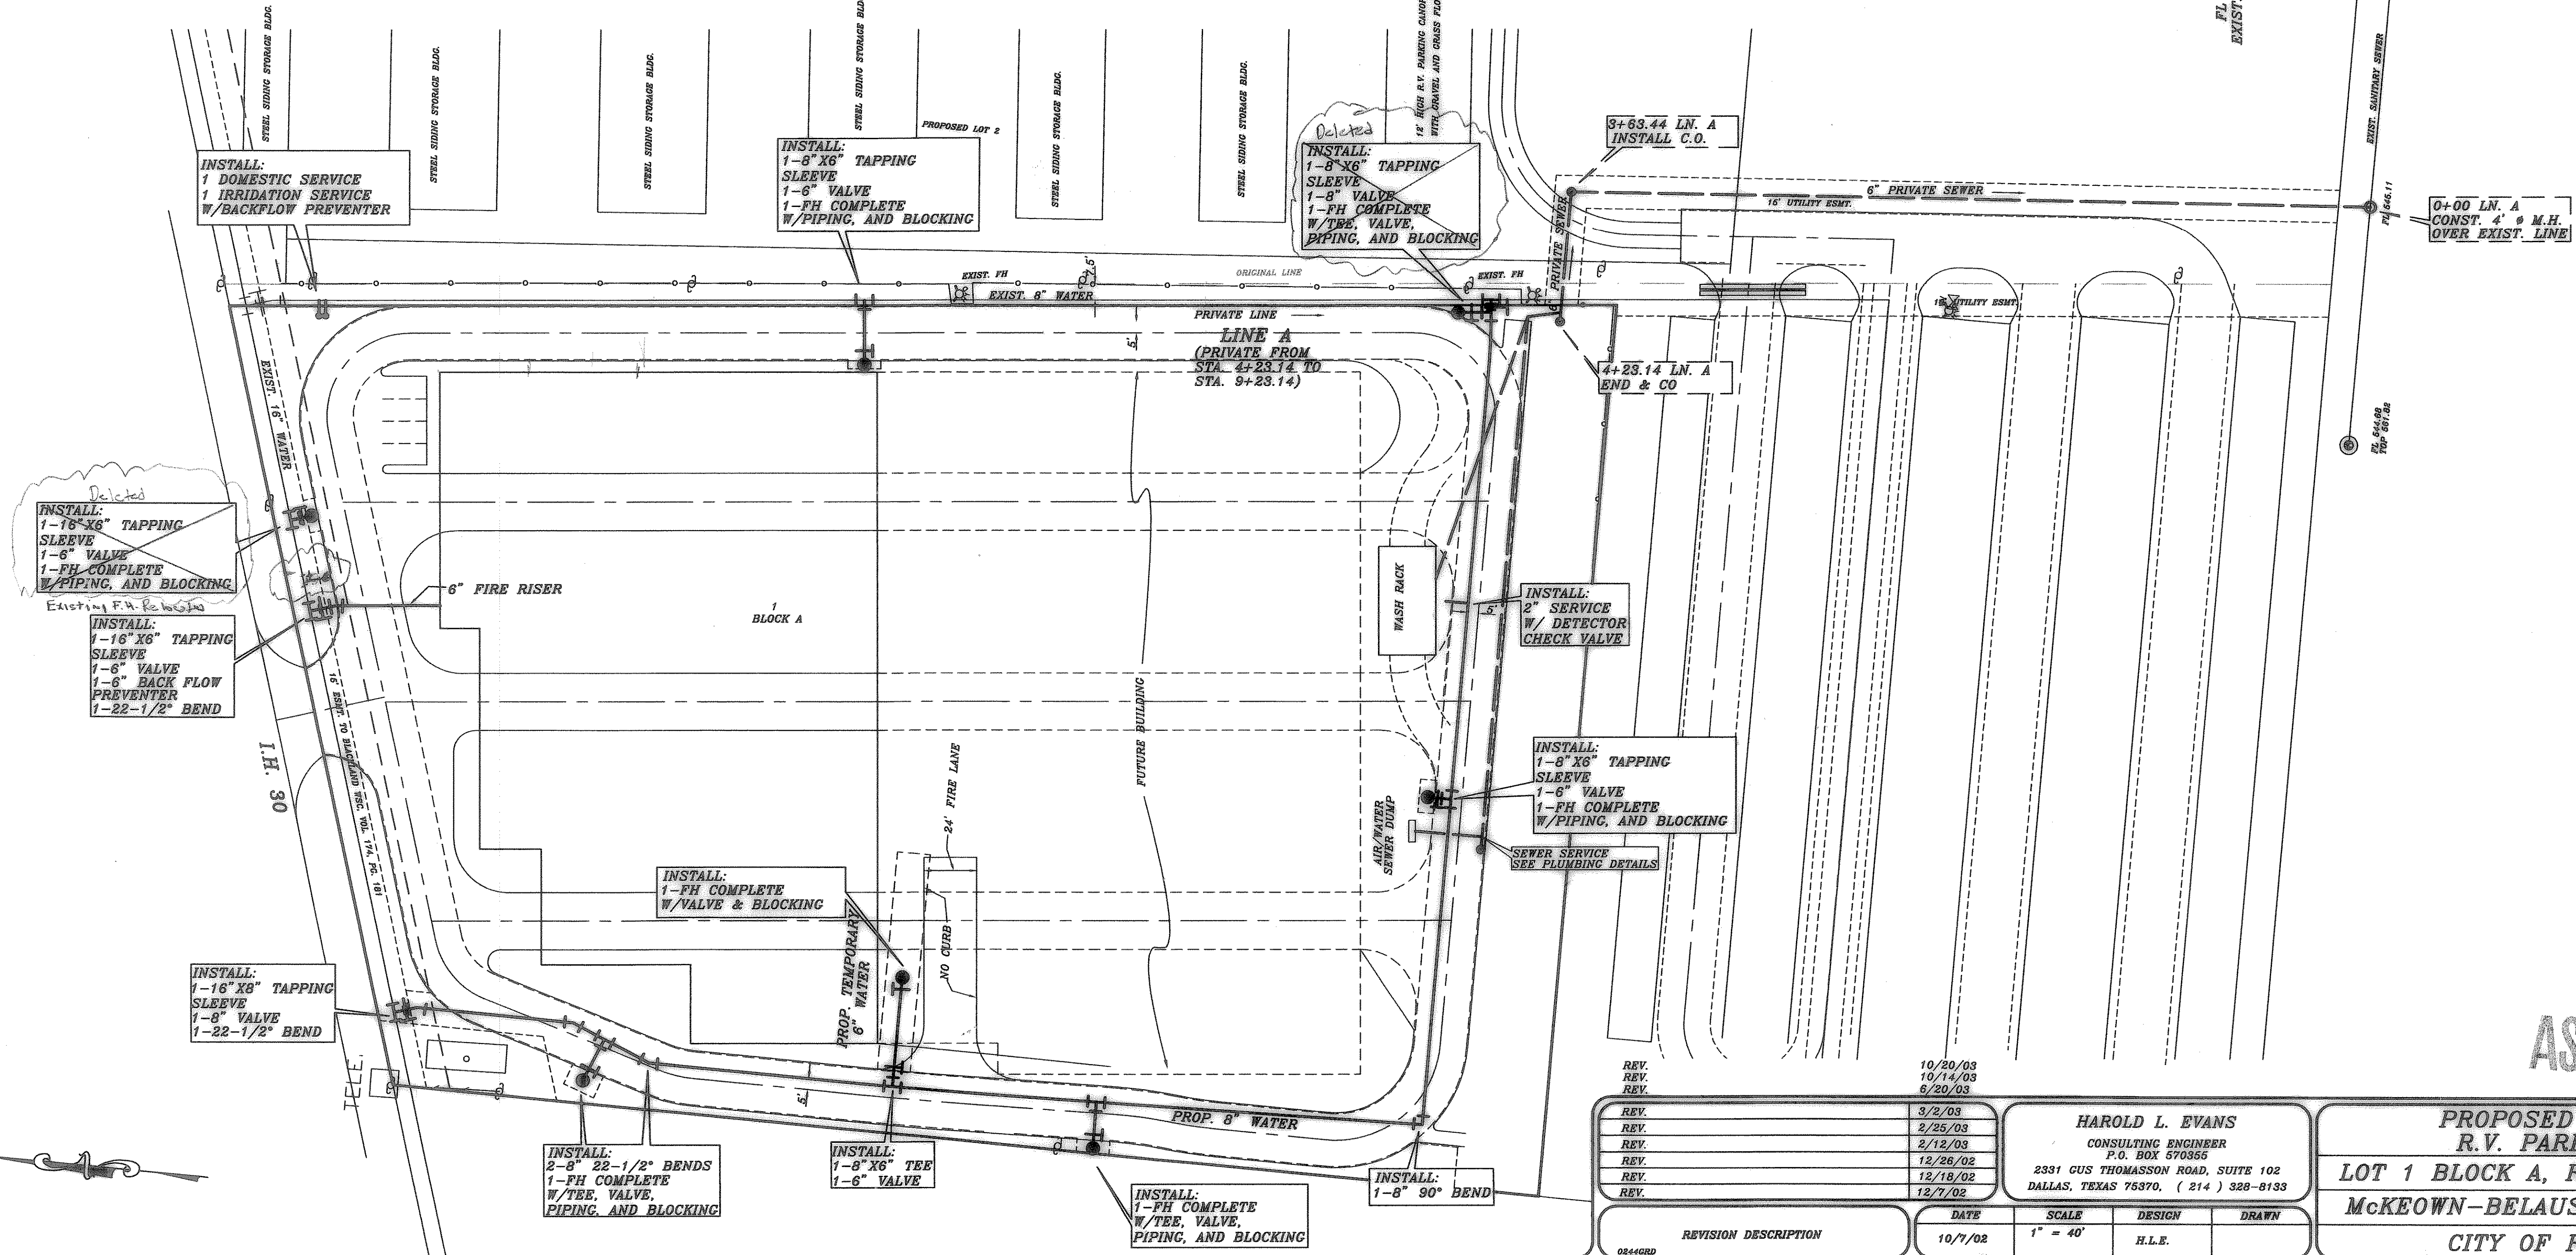


LINE A

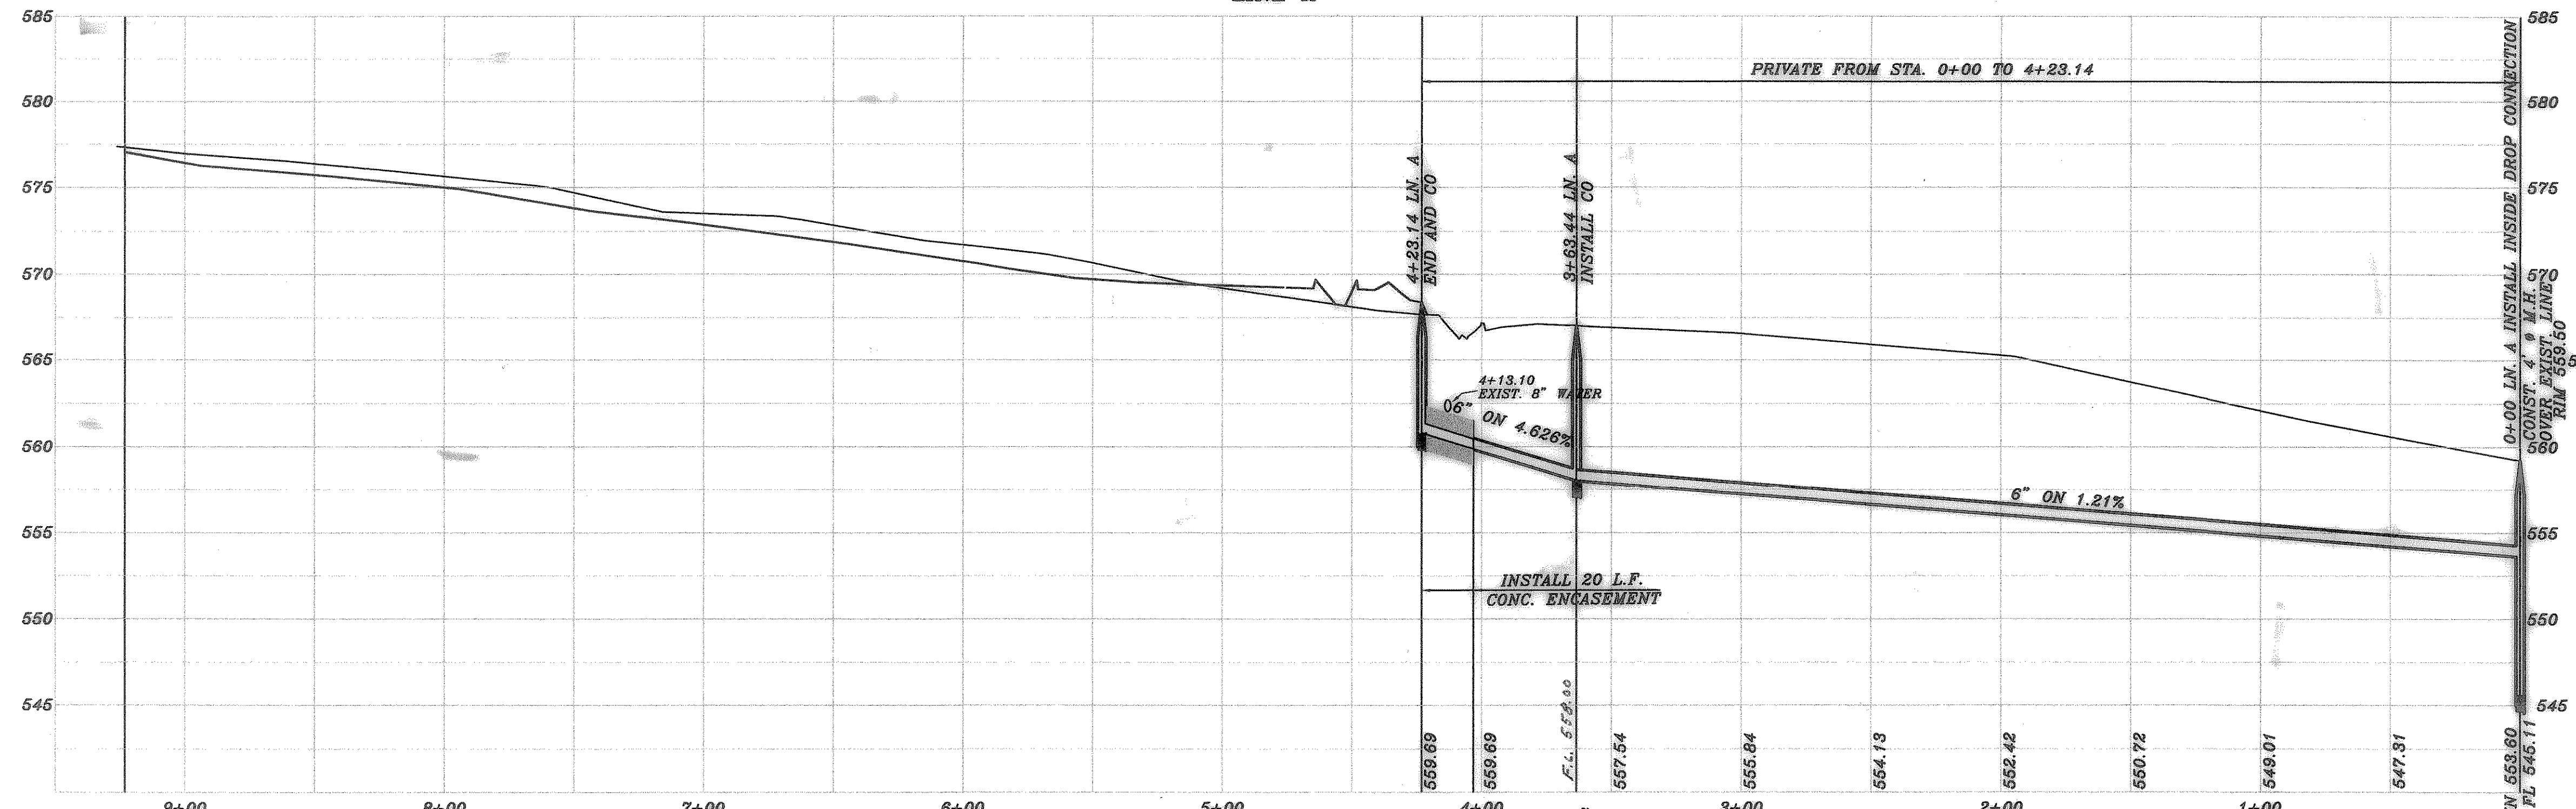

AS BUILT

REV.	DATE	SCALE	DESIGN	DRAWN
REV.	10/20/03			
REV.	10/14/03			
REV.	6/20/03			
REV.	3/2/03			
REV.	2/25/03			
REV.	2/12/03			
REV.	12/26/02			
REV.	12/18/02			
REV.	12/7/02			

REVISION DESCRIPTION	DATE	SCALE	DESIGN	DRAWN
	10/7/02	1" = 40'	H.L.E.	

PROPOSED UTILITIES
R.V. PARKIT PLACE
LOT 1 BLOCK A, REPLAT/FINALPLAT
McKEOWN-BELAUSTEGUI ADDITION
CITY OF ROCKWALL

SHEET NO.	5
JOB NO.	020444