


No.	Date	Revisions	App.
1/21/99	12/22/98	SM 'C' LINED	KSS
		FLOW QUANTITIES REVISED/NO PIPE SIZE CHANGE	KSS

ROCKWALL RETAIL CENTER
CITY OF ROCKWALL, TEXAS

STORM DRAINAGE PROFILES

Kimley-Horn and Associates, Inc.
12700 Park Central Drive, Suite 1800
Dallas, Texas 75251
Tel. No. (972) 770-1300
Fax No. (972) 259-3820

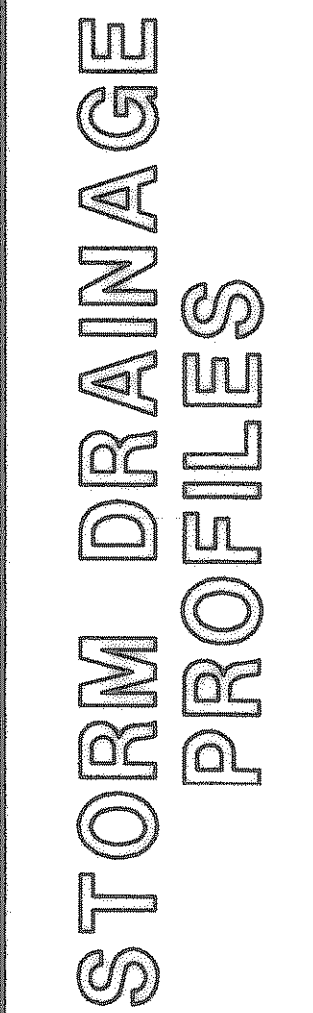

Scale: 1" = 40' H, 1" = 4' V
 Designed by: NES
 Drawn by: KCC
 Checked by: KSC
 Date: JANUARY, 1999
 Project No. 063382.00

"RECORD DRAWINGS"
 NOTE: THE INTENT OF THE OWNER AND ENGINEER WAS TO CONSTRUCT THE IMPROVEMENTS ACCORDING TO THESE PLANS AS APPROVED BY THE CITY OF ROCKWALL. THE LINES AND GRADES WERE SET ON THE GROUND FOR CONSTRUCTION ACCORDING TO SAID PLANS. WE ARE NOT AWARE OF ANY CHANGES OR REVISIONS TO THESE PLANS DURING CONSTRUCTION EXCEPT AS NOTED ON THE PLANS.