



- NOTES:
- NO. 5 SMOOTH DOMEL BAR MAY BE USED IN 5 INCH AND 6 INCH PAVEMENT THICKNESS.
 - LONGITUDINAL BUTT CONSTRUCTION MAY BE UTILIZED IN PLACE OF LONGITUDINAL HINGED (KEYWAY) JOINT AT CONTRACTOR'S OPTION.
 - DOMEL BARS SHALL BE DRILLED INTO PAVEMENT HORIZONTALLY BY USE OF A MECHANICAL RIG. DRILLING BY HAND IS NOT ACCEPTABLE. PUSHING DOMEL BARS INTO GREEN CONCRETE NOT ACCEPTABLE.

LONGITUDINAL BUTT JOINT
NOT TO SCALE

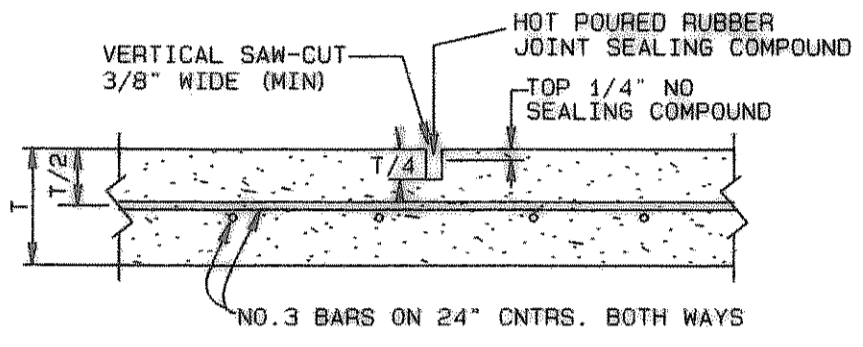


SAWED DUMMY JOINT DETAIL (ON-SITE)
NOT TO SCALE


NOTE: MAXIMUM DISTANCE BETWEEN JOINTS SHALL BE 15 FEET IN BOTH DIRECTIONS.

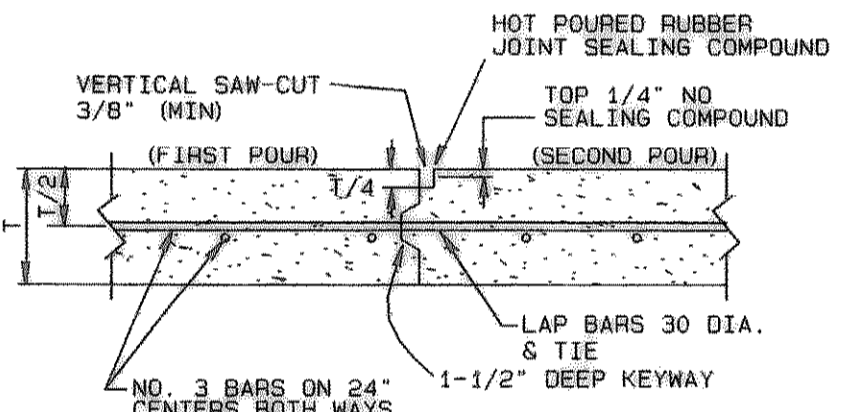


CONSTRUCTION JOINT DETAIL (ON-SITE)
NOT TO SCALE

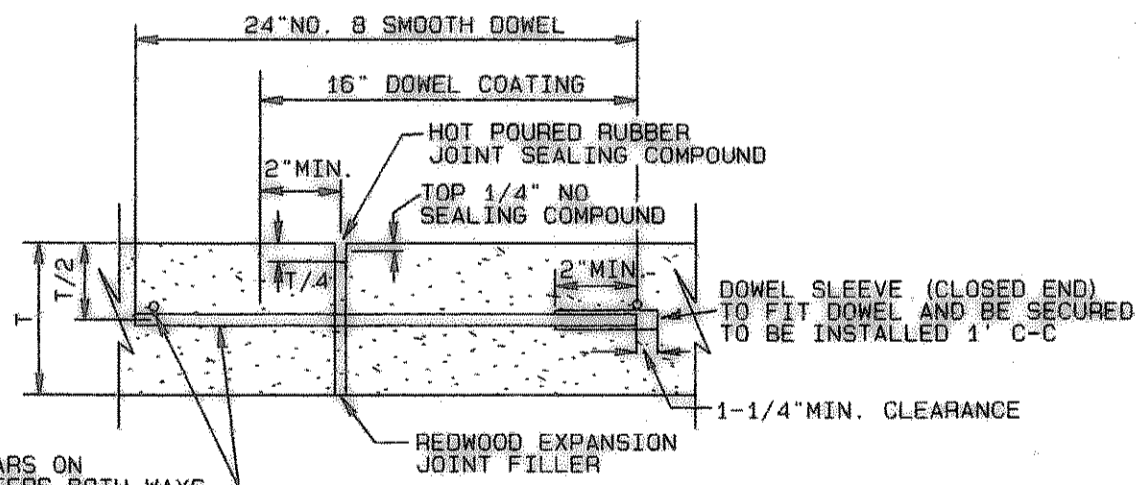



TRANSVERSE EXPANSION JOINT DETAIL (ON-SITE)
NOT TO SCALE

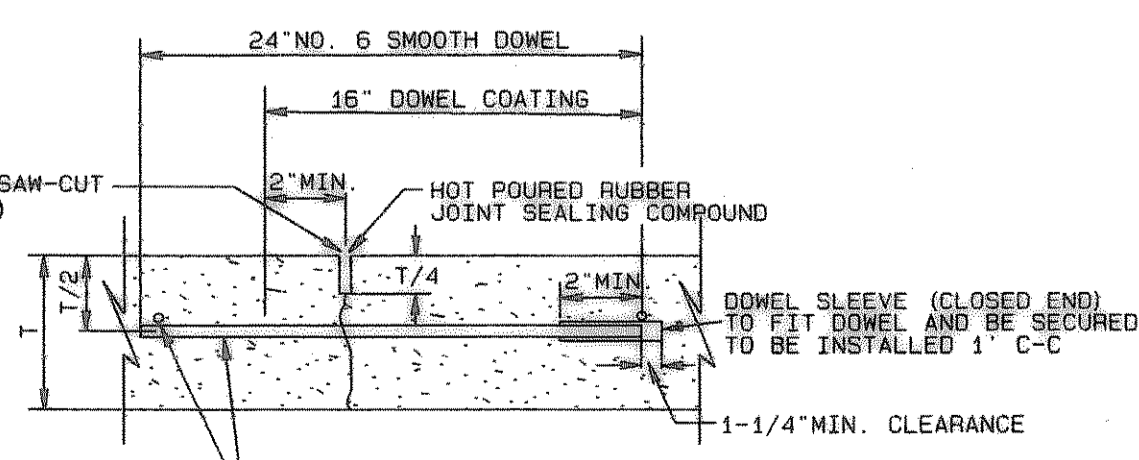


CONTRACTION JOINT DETAIL (ON-SITE)
NOT TO SCALE

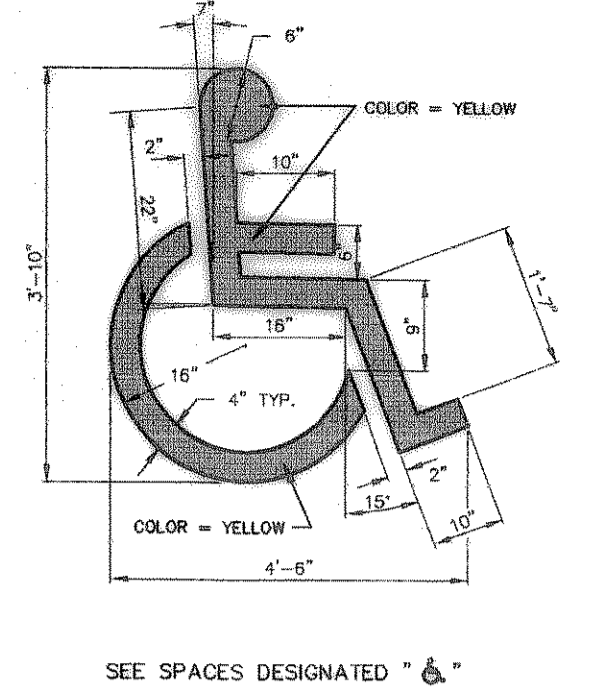


HANDICAPPED PARKING SYMBOL
N.T.S.

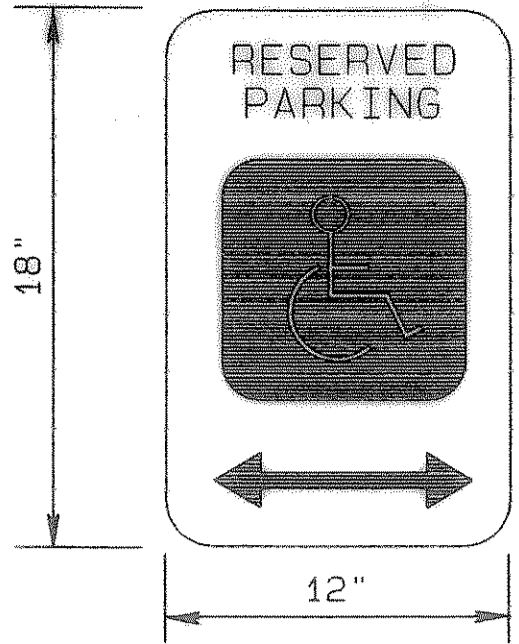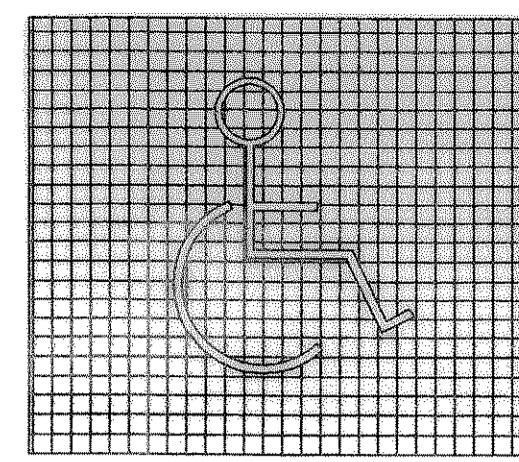


HANDICAP SIGN
N.T.S.

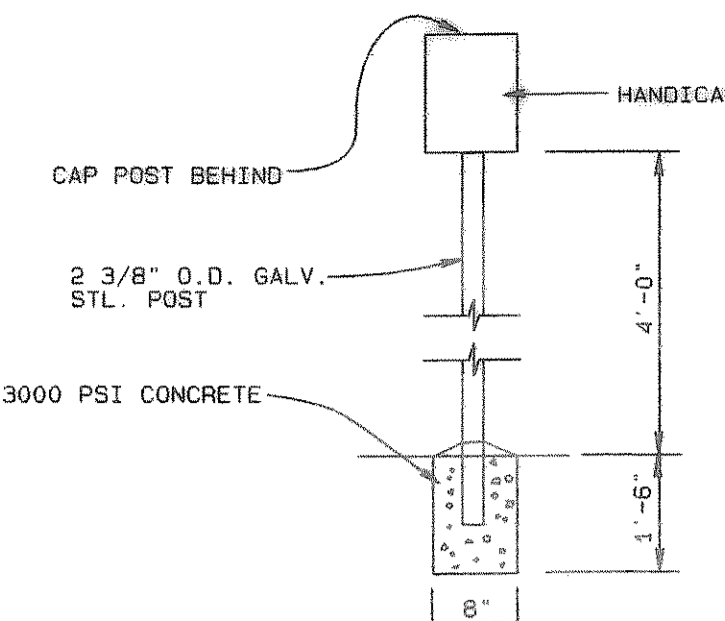


HANDICAP SIGN POST
N.T.S.

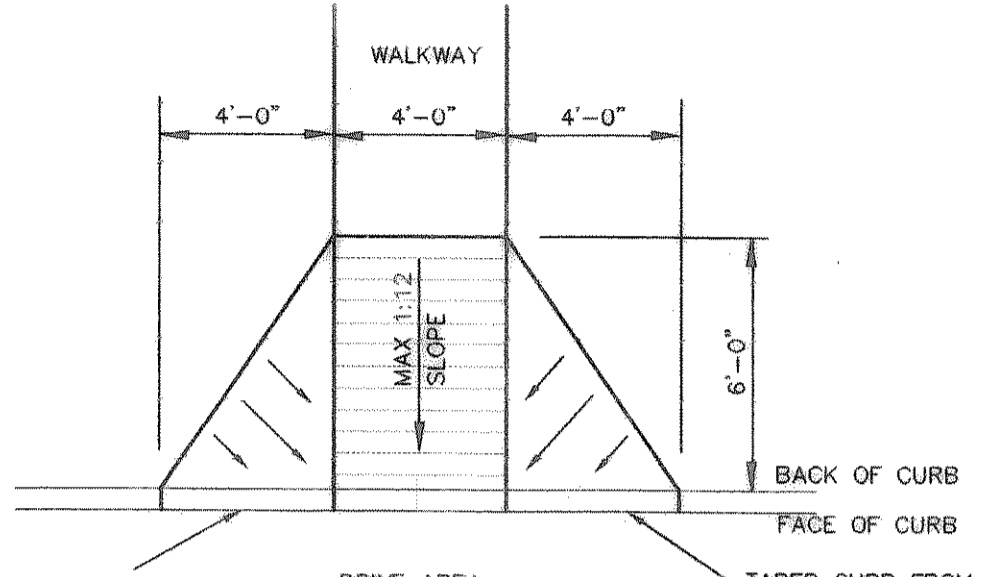


BARRIER FREE RAMP DETAIL
N.T.S.

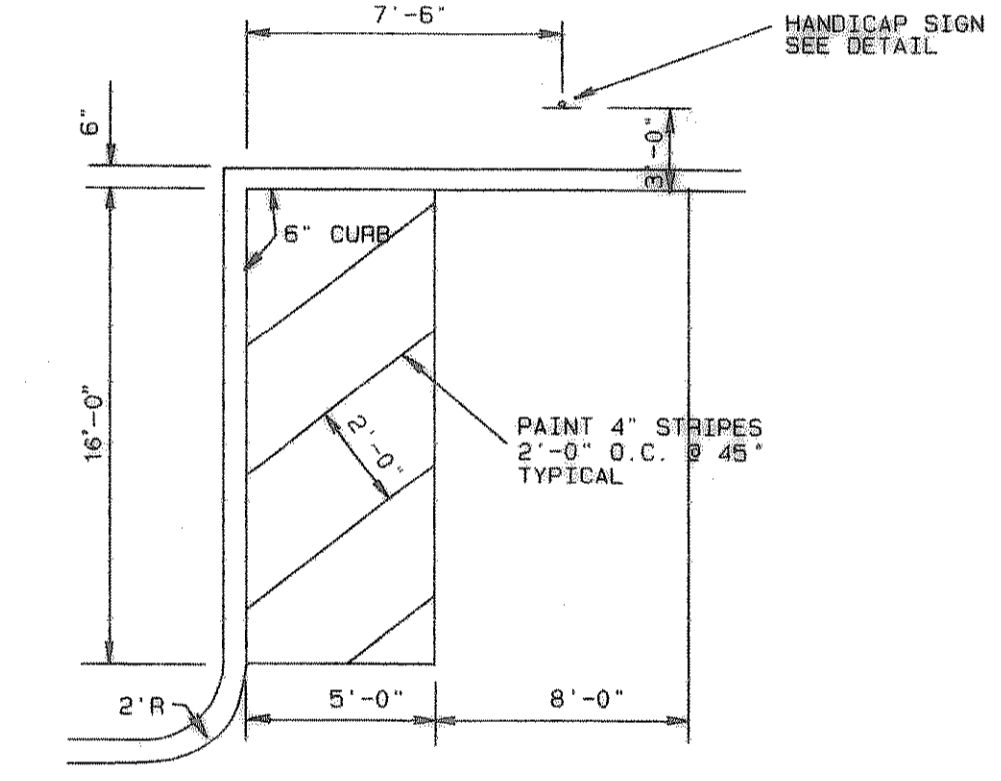


HANDICAP SPACE WITHOUT RAMP
N.T.S.

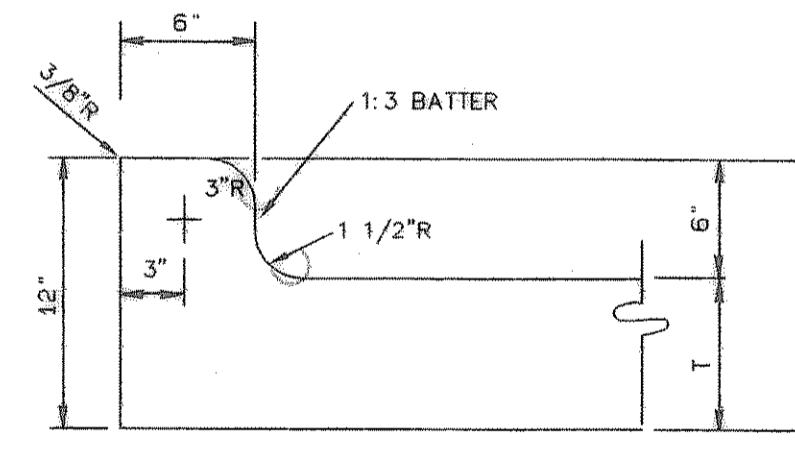


INTEGRAL CURB DETAIL
NOT TO SCALE

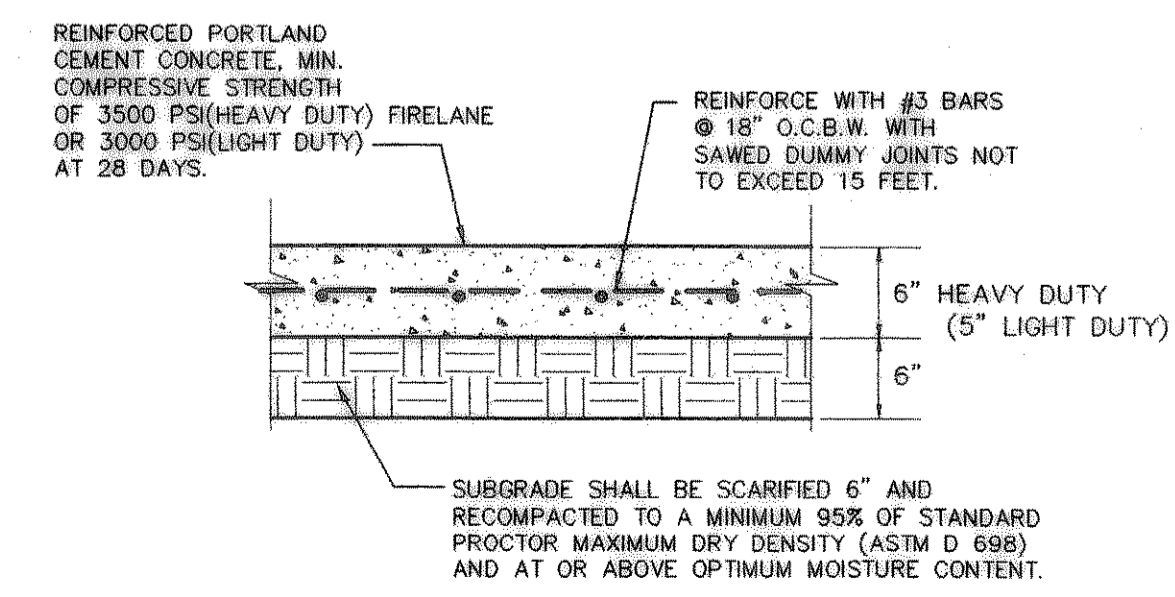


CONCRETE PAVEMENT CROSS-SECTION
NOT TO SCALE

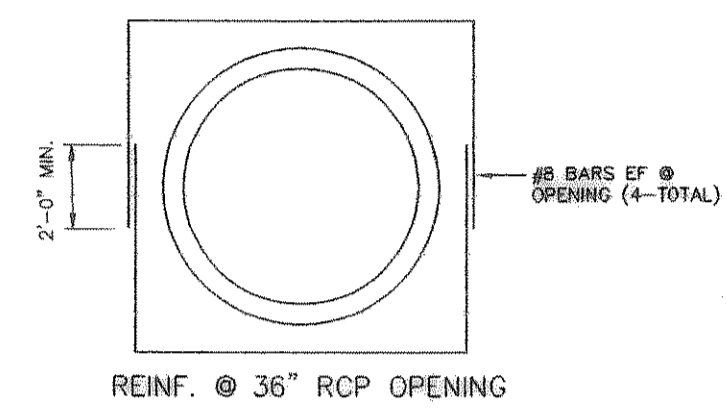


STOP LINE
DIRECTIONAL ARROW
N.T.S.

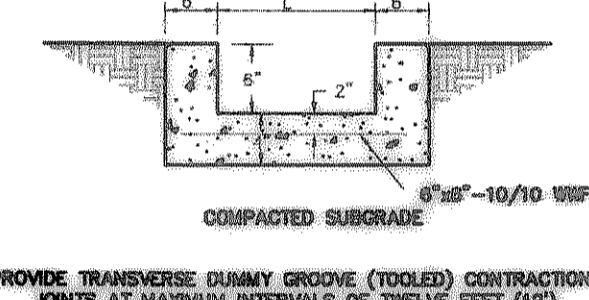


REINFORCED CONCRETE FLUME
N.T.S.

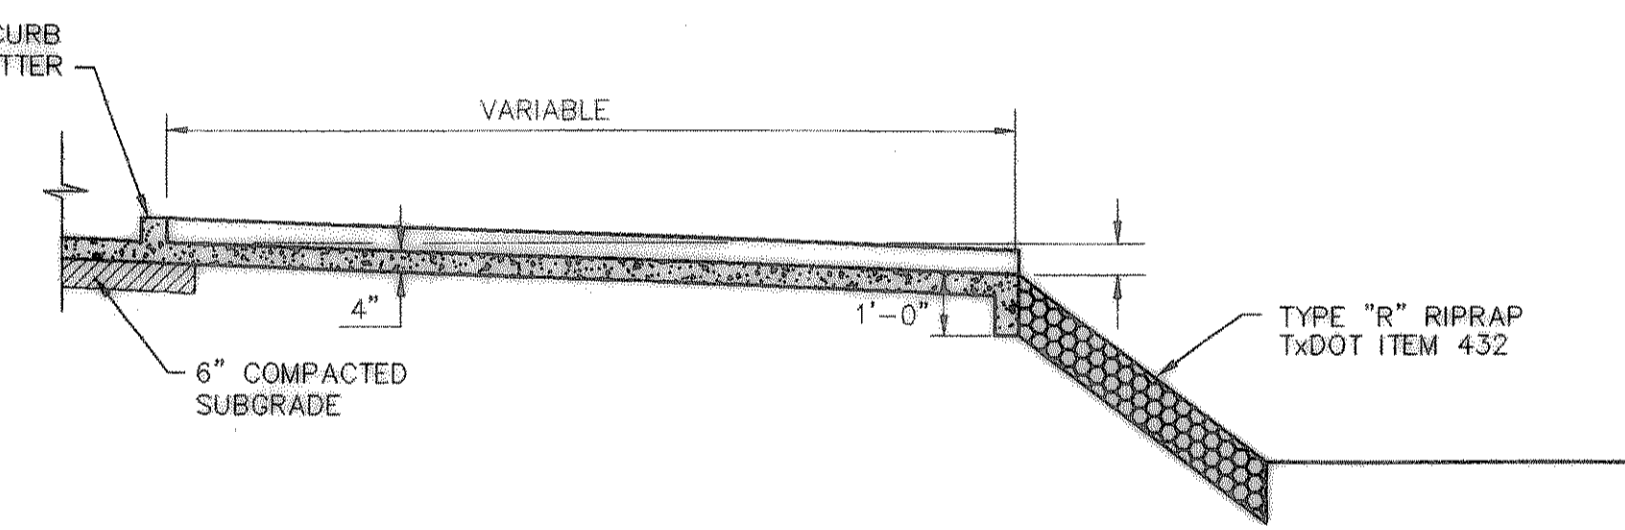


CONCRETE DRAINAGE FLUME
N.T.S.

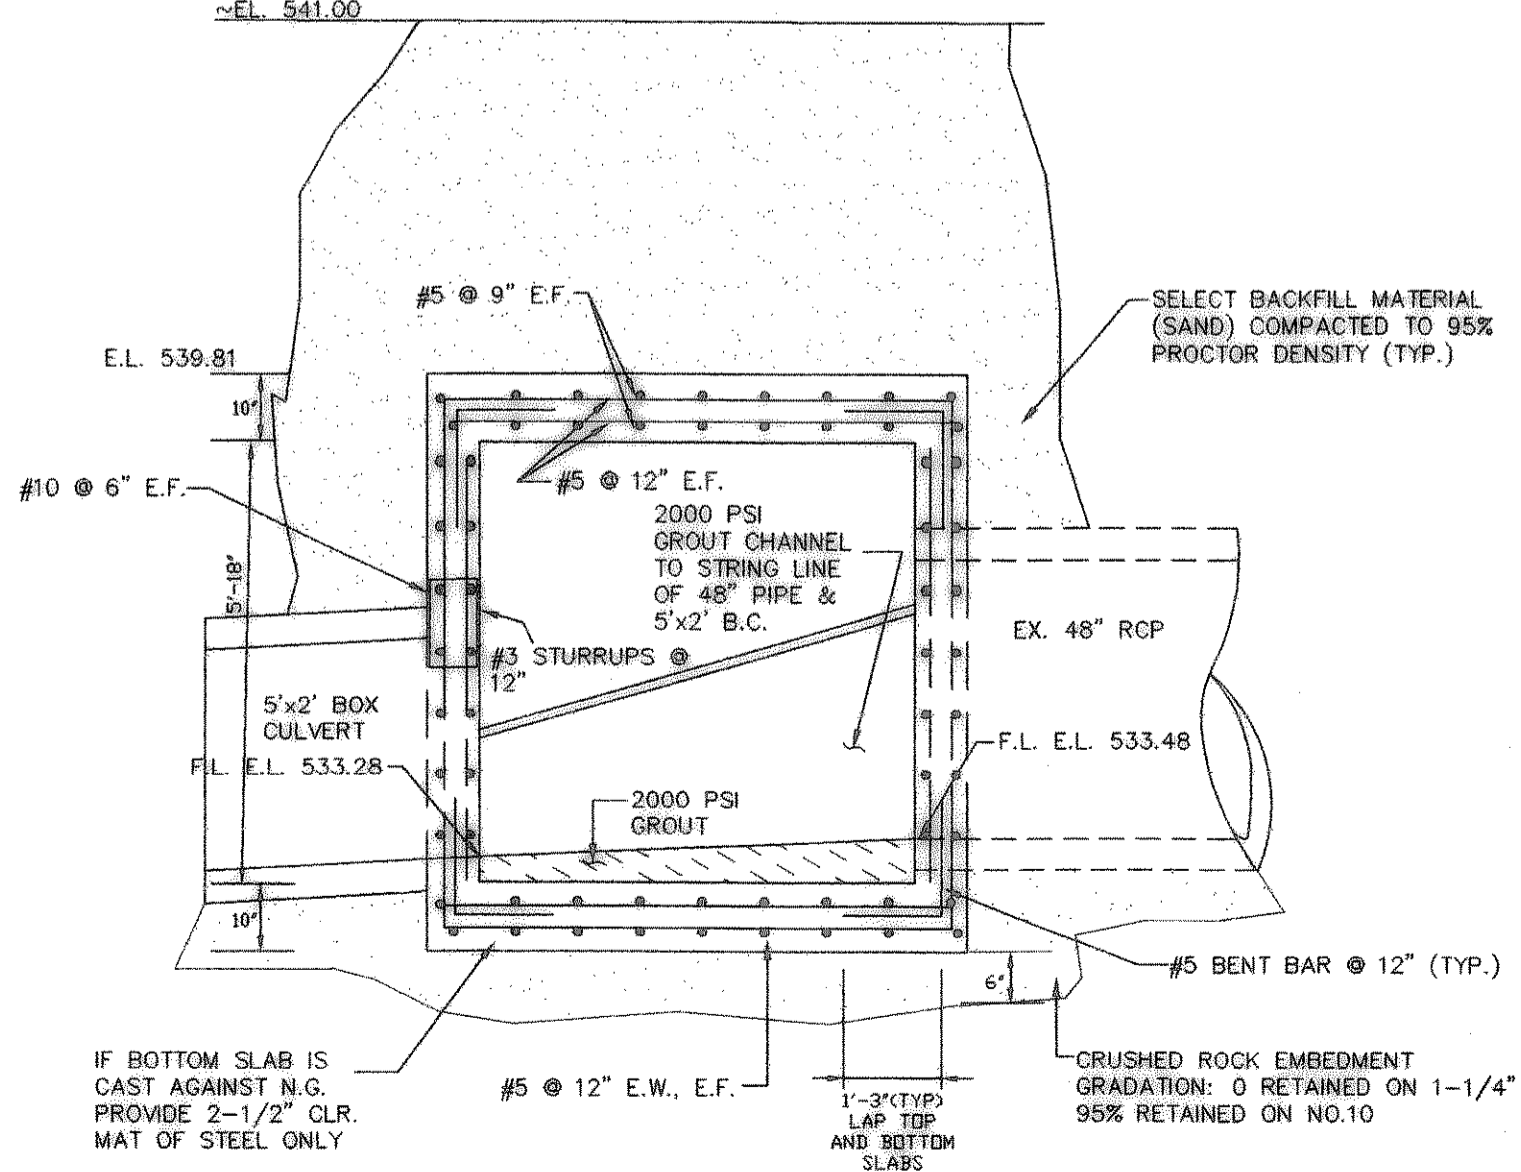


SECTION B-B
N.T.S.

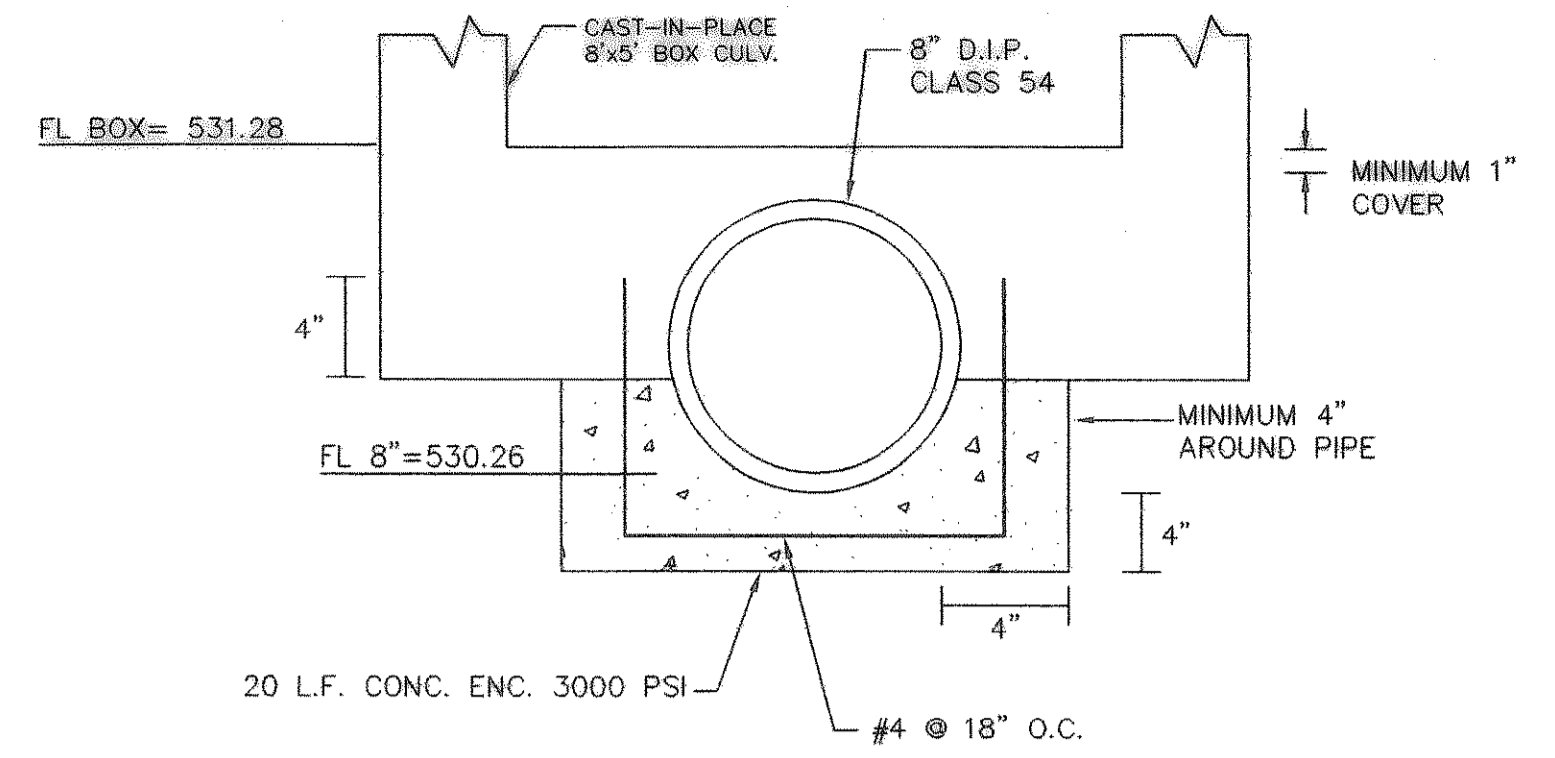

SANITARY SEWER ENCASEMENT DETAIL
N.T.S.

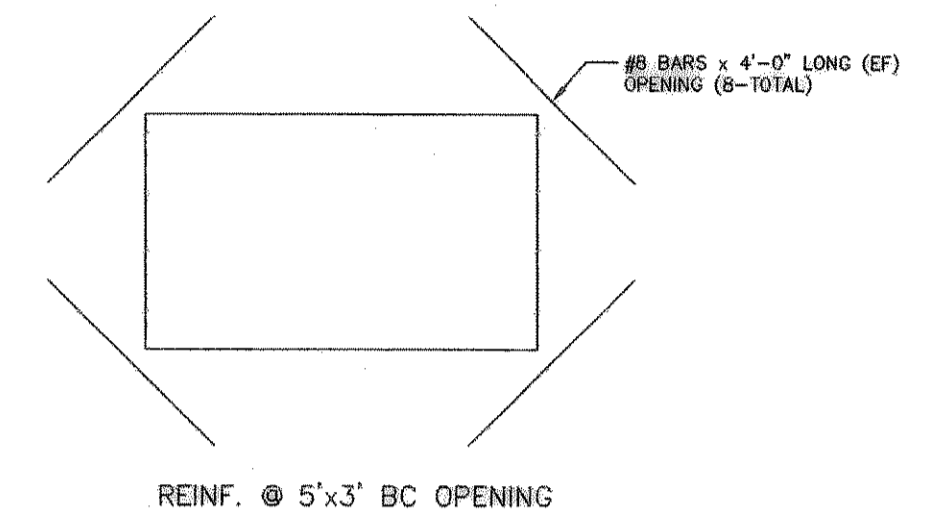

LINE "A" JUNCTION BOX DETAIL
N.T.S.

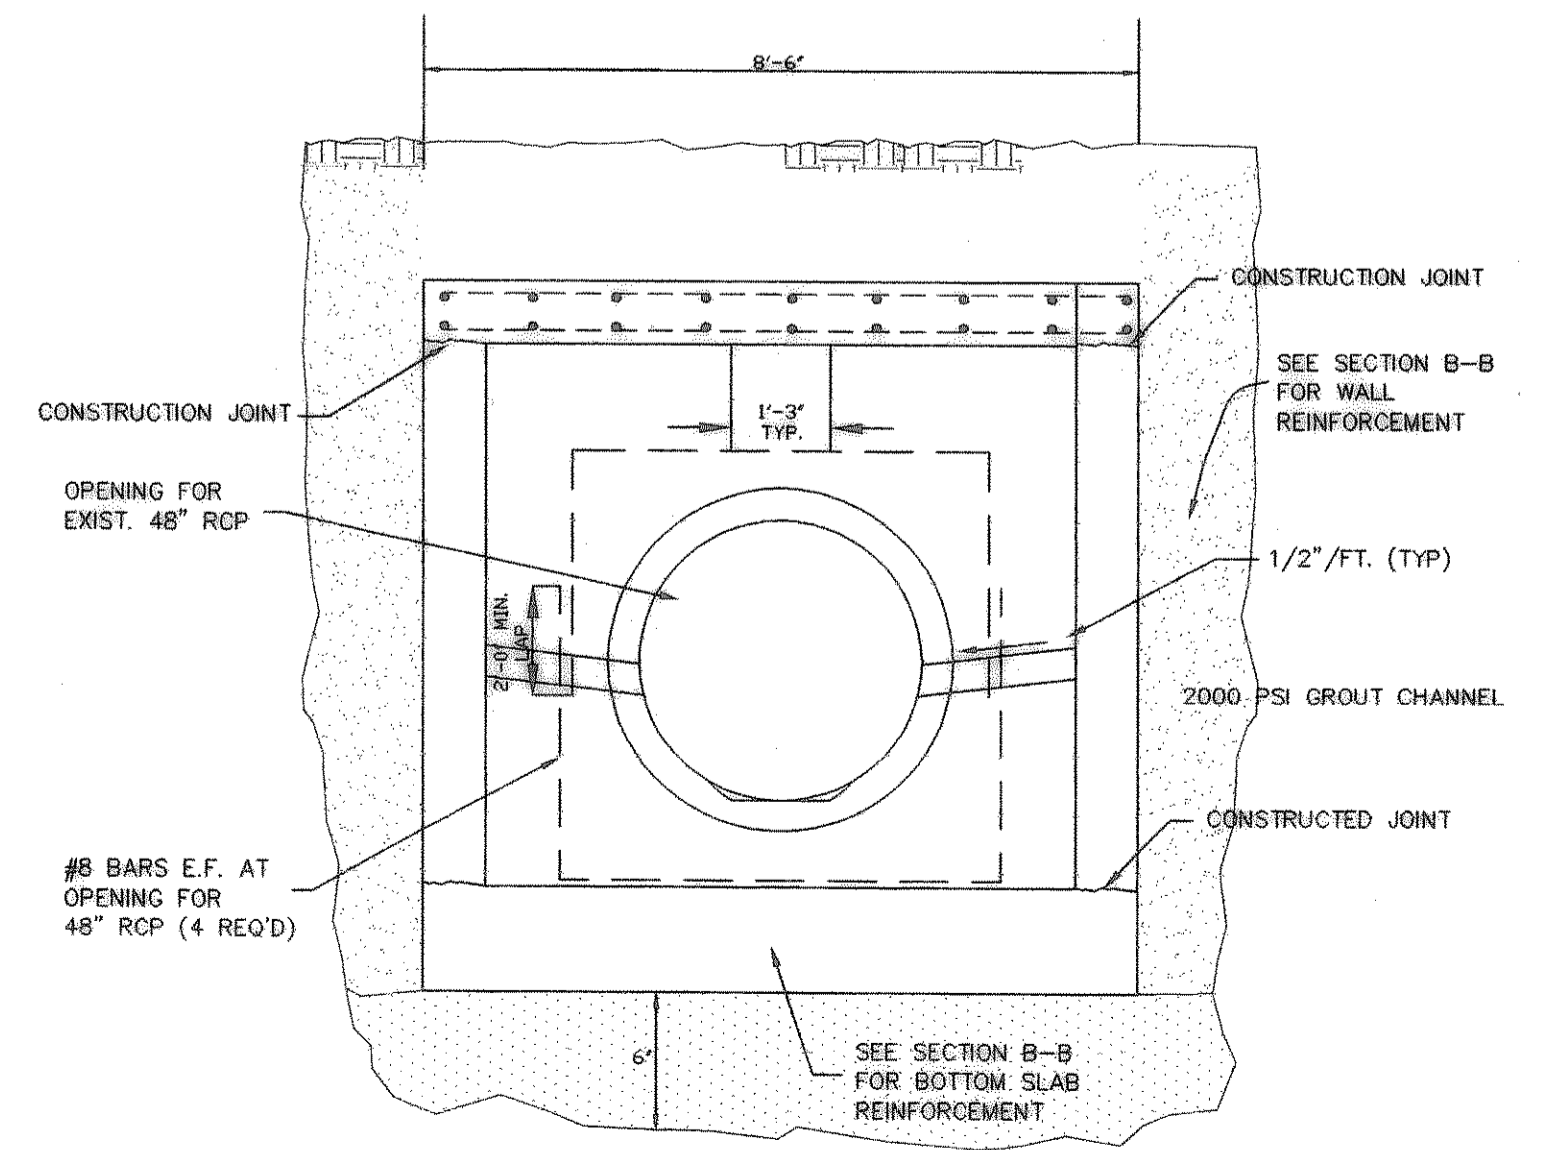

SECTION A-A
N.T.S.

"RECORD DRAWINGS"
NOTE: THE INTENT OF THE OWNER AND ENGINEER WAS TO CONSTRUCT THE IMPROVEMENTS ACCORDING TO THESE PLANS AS APPROVED BY THE CITY OF ROCKWALL. THE LINES DRAWN BY THE CONTRACTOR SHALL BE CONSIDERED AS APPROVED BY THE CONTRACTOR. ANY CHANGES OR REVISIONS TO THESE PLANS DURING CONSTRUCTION SHALL BE NOTED ON THE PLANS.

Kimley-Horn and Associates, Inc.
Tel. No. (972) 770-1300
Fax. No. (972) 258-3820
12700 Park Central Drive, Suite 1800
Dallas, Texas 75251

ROCKWALL RETAIL CENTER
CITY OF ROCKWALL, TEXAS

DETAILS

Scale:	NOT TO SCALE
Designed by:	NES
Drawn by:	RKR
Checked by:	KSG
Date:	JANUARY, 1999
Project No.:	063382.00

C:\DWG\06338200\2006101.dwg 11/05/99 04:15
AREP = AS-65