

# AS-BUILT PLANS FOR PAVING, DRAINAGE, WATER, & WASTEWATER

## RaceTrac®

RACE TRAC STORE # 954

**LOT 6 & 7, BLOCK 1  
MEADOWCREEK BUSINESS CENTER PHASE 2  
S.E.C. STATE HWY 205 & STATE HWY 276  
CITY OF ROCKWALL, TEXAS**

### INDEX OF SHEETS


SHEET NO.	DESCRIPTION
1	COVER SHEET / INDEX
2	PLAT
3	SURVEY
4	SITE PLAN 1 OF 2
4.1	SITE PLAN 2 OF 2
5	DIMENSION CONTROL PLAN
6	GRADING PLAN
7	DRAINAGE PLAN
7.1	DRAINAGE CALCULATIONS
7.2	DRAINAGE PROFILES
8	PAVING PLAN
9	UTILITY PLAN
9.1	UTILITY PROFILES
10	EROSION CONTROL PLAN
11	ADA PLAN & DETAILS
12	PHOTOMETRIC PLAN (CONSTRUCTION USE ONLY)
13	RACETRAC STANDARD DETAILS
14	RACETRAC STANDARD DETAILS
15	GENERAL NOTES
16	STATE HIGHWAY 276 LEFT TURN LANE
17	TRASH ENCLOSURE DETAILS (CONSTRUCTION USE ONLY)
TCP(1-2)-98	TEXAS DEPT. OF TRANSPORTATION TRAFFIC CONTROL PLAN
TCP(2-3)-03	TEXAS DEPT. OF TRANSPORTATION TRAFFIC CONTROL PLAN
TCP(2-4)-03	TEXAS DEPT. OF TRANSPORTATION TRAFFIC CONTROL PLAN
TCP(3-1)-98	TEXAS DEPT. OF TRANSPORTATION TRAFFIC CONTROL PLAN
TCP(3-3)-98	TEXAS DEPT. OF TRANSPORTATION TRAFFIC CONTROL PLAN FOR RPZ INSTALLATION
TCP(7-1)-98	TEXAS DEPT. OF TRANSPORTATION TRAFFIC CONTROL PLAN FOR SURFACING OPERATION
BC(1)-07	BARRICADE AND CONSTRUCTION GENERAL NOTES
BC(2)-07	BARRICADE AND CONSTRUCTION PROJECT LIMIT STANDARD
BC(3)-07	BARRICADE AND CONSTRUCTION WORK ZONE SPEED LIMIT STANDARD
BC(4)-07	BARRICADE AND CONSTRUCTION TEMPORARY SIGN NOTES STANDRAD
BC(5)-07	BARRICADE AND CONSTRUCTION TYPICAL SIGN SUPPORT STANDRAD
BC(6)-07	BARRICADE AND CONSTRUCTION PORTABLE CHANGEABLE MASSING SIGN STANDARD
BC(7)-07	BARRICADE AND CONSTRUCTION ARROW PANELS, REFLECTORS, WARNING LIGHTS & ATTENUATOR STD.
BC(8)-07	BARRICADE AND CONSTRUCTION CHANNELIZING DEVICES STANDARD
BC(9)-07	BARRICADE AND CONSTRUCTION CHANNELIZING DEVICES STANDARD
BC(10)-07	BARRICADE AND CONSTRUCTION CHANNELIZING DEVICES STANDARD
BC(11)-07	BARRICADE AND CONSTRUCTION PAVEMENT MARKING STANDARD
BC(12)-07	BARRICADE AND CONSTRUCTION PAVEMENT MARKING PATTERNS STANDARD
WZ(STPM)-03	WORK ZONE SHORT TERM PAVEMENT MARKING
PEB-05	TEXAS DEPT. OF TRANSPORTATION CURB RAMP DETAILS
CDD-08 (FW)	TEXAS DEPT. OF TRANSPORTATION DRIVE APPROACH DETAILS
SET1	SAFETY END TREATMENT HEADWALL

#### OWNER:

RACETRAC PETROLEUM, INC.  
3225 CUMBERLAND BLVD.  
SUITE 100  
ATLANTA, GEORGIA 30339  
ANITA JAMES  
(770) 431-7600


#### SUBMITTED BY:

THE DIMENSION GROUP  
10755 SANDHILL ROAD  
DALLAS, TEXAS 75238  
(214) 343-9400

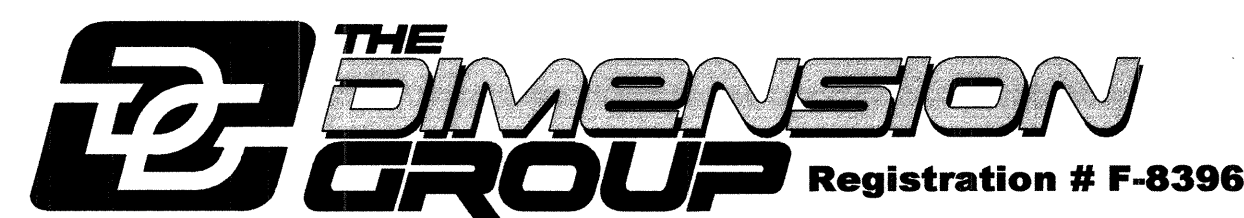

KARTAVYA S. PATEL, P.E.

4/29/11  
DATE

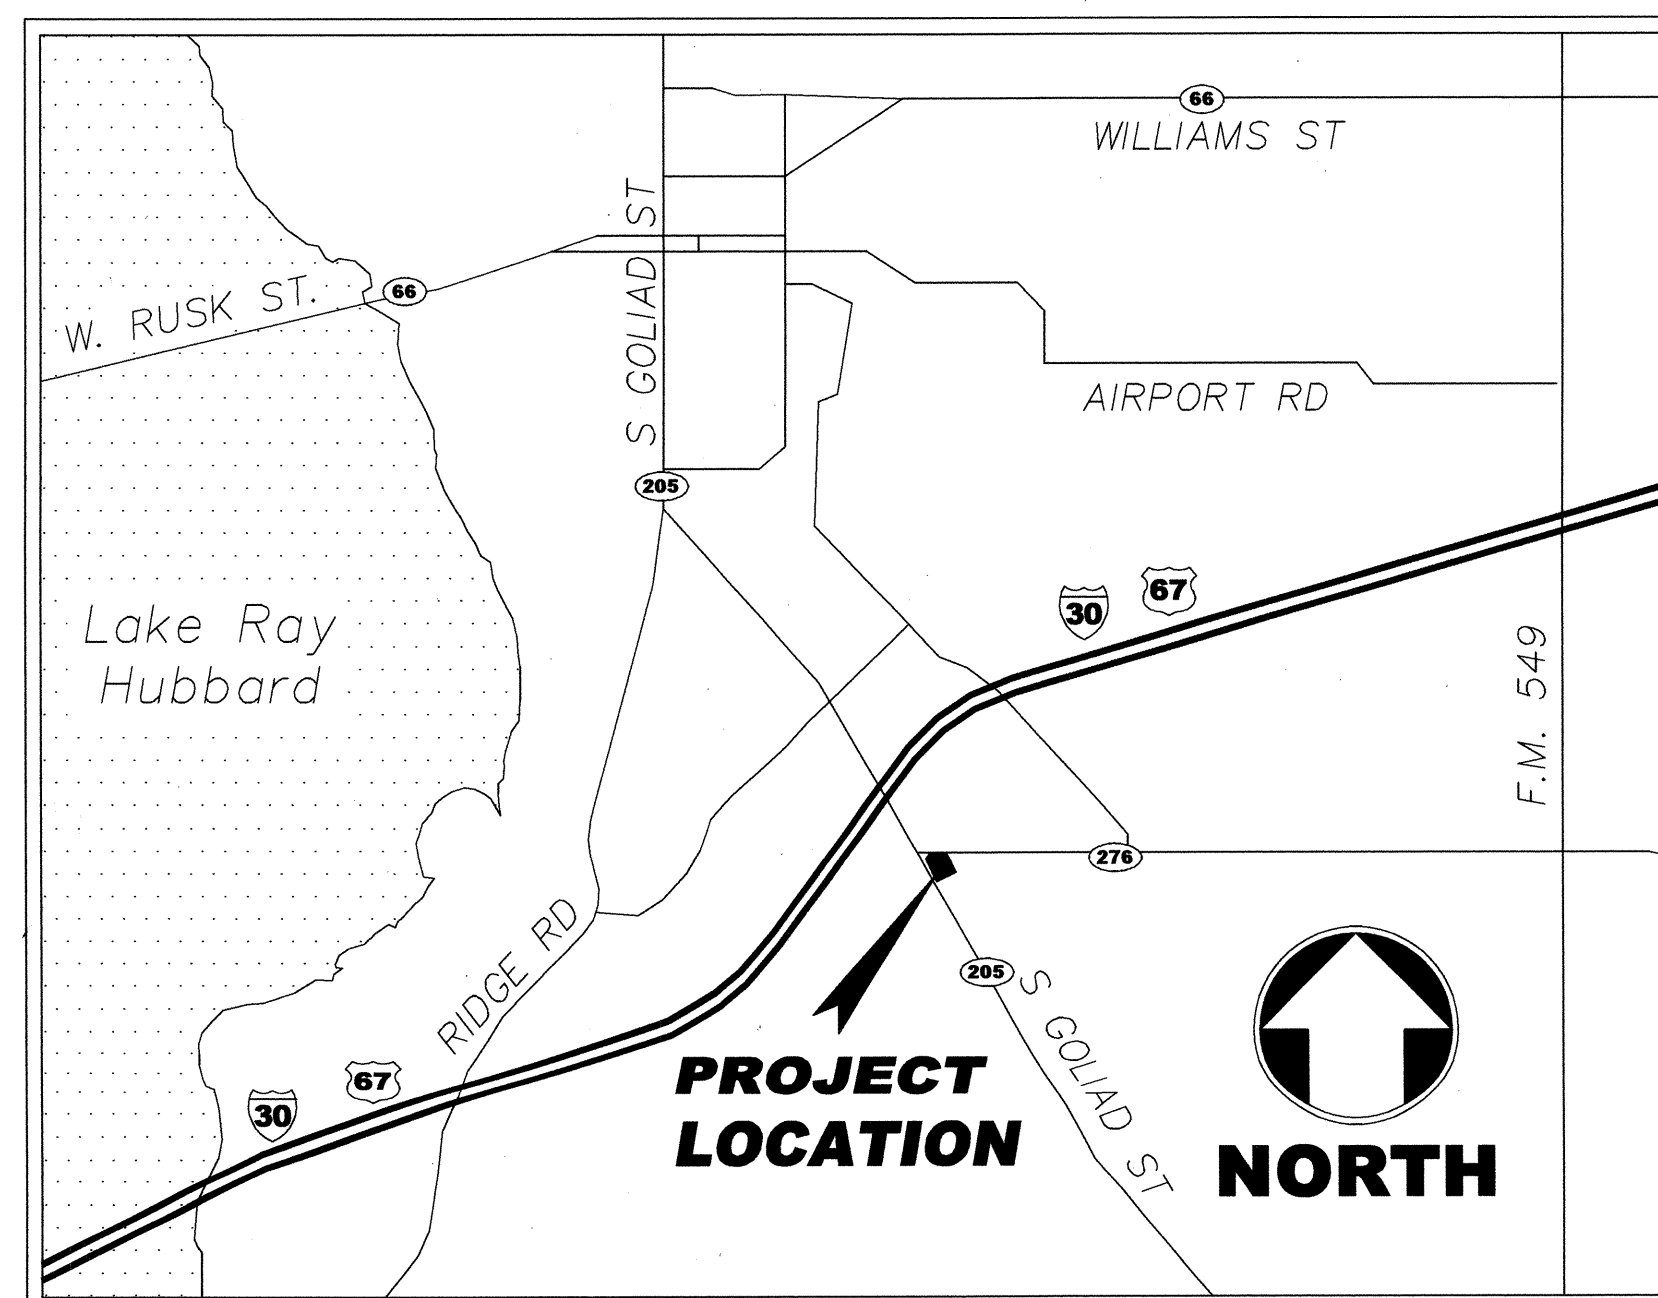

PROJECT VICINITY MAP

N. T. S.

MAPSCO PAGE 30D-A

JUNE 2, 2010

NO.	DESCRIPTION	DATE
1	AS BUILTS	4/18/11