

STORMWATER DETENTION POND CALCULATIONS
Race Trac
Medow Creek Business Park
Rockwall, TX

STORM DATA REFERENCE: CITY STANDARD RAINFALL INTENSITY-FIGURE 1 FOR 100 YEAR STORM FREQUENCY

ALLOWABLE RELEASE RATE EQUAL TO THE 100-YEAR PEAK RUNOFF RATE PRIOR TO SITE DEVELOPMENT
 WHEN C=0.35, I=6.13 @ Tc=20 MINS
 TOTAL SITE AREA: 6.13 ACRES
 BY PASS RUNOFF AREA "B"= 1.68 CFS
 ALLOWABLE RUNOFF FROM SITE: 0.35 X 8.30 X 6.13 = 17.81 CFS
 ALLOWABLE RELEASE FROM DETENTION POND: 17.81-1.68=16.13CFS
 TOTAL DETAINED AREA= 5.94ACRES

STORM DURATION DATA & DETENTION POND SYSTEM CALCULATION:

TIME (Min)	C x Cf	I ¹⁰ (10-Year)	TOTAL AREA (Acres)	Q (CFS)	INFLOW (CF)	OUTFLOW (CF)	STORAGE (CF)
10	0.90	9.80	5.94	52.39	31.434	9.678	21.756
20	0.90	8.30	5.94	44.37	53.246	14.517	38.729
30	0.90	6.90	5.94	36.89	66.397	19.356	47.041
40	0.90	5.80	5.94	31.01	74.416	24.195	50.221
50	0.90	5.00	5.94	26.73	80.190	29.034	51.156
60	0.90	4.50	5.94	24.06	86.605	33.873	52.732
70	0.90	4.20	5.94	22.45	94.303	38.712	55.591
80	0.90	3.90	5.94	20.85	100.077	43.551	56.526
90	0.90	3.50	5.94	18.71	101.039	48.390	52.649

REQUIRED STORAGE VOLUME CALCULATION SUMMARY:

REQUIRED STORAGE VOLUME = INFLOW - OUTFLOW
 INFLOW = STORM DURATION X RESPECTIVE PEAK DISCHARGE X 60 SEC./MIN.
 OUTFLOW = HALF OF THE RESPECTIVE INFLOW DURATION X CONTROL RELEASE DISCHARGE X 60 SEC./MIN.

100 YEAR STORM EVENT @ 70 MIN.
 INFLOW = 0.90 X 3.90 X 5.94 X 80 X 60 = 100,077
 OUTFLOW = 0.5 X 16.13 X 90 X 60 = 43,551

REQUIRED DETENTION SYSTEM STORAGE CAPACITY = INFLOW - OUTFLOW = 100,077-43,551 = 56,526 CF
 PROVIDED DETENTION VOLUME = 62,999 CF

25 YRS ORIFICE CALCULATIONS

From the orifice equation
 $Q = C \cdot A \cdot (2 \cdot g \cdot H)^{1/2}$

Where
 Q = rate of discharge (ft³/s)
 A = orifice area (ft²)
 C = orifice coefficient (usually about 0.60)
 g = gravitational constant (32.2 ft/s²)
 H = depth of water above the centroid of the orifice (ft)

When
 Q = allowable release from detention pond = 14.14 CFS
 H = average depth of water in detention system = 3.5ft

So
 $A = Q / (C \cdot (2 \cdot g \cdot H)^{1/2})$
 $= 14.14 / (0.6 \cdot (2 \cdot 32.2 \cdot 3.5)^{1/2})$
 $= 1.57 \text{ft}^2$

Area Provided=1.57 S.F.

50 YRS ORIFICE CALCULATIONS

From the orifice equation
 $Q = C \cdot A \cdot (2 \cdot g \cdot H)^{1/2}$

Where
 Q = rate of discharge (ft³/s)
 A = orifice area (ft²)
 C = orifice coefficient (usually about 0.60)
 g = gravitational constant (32.2 ft/s²)
 H = depth of water above the centroid of the orifice (ft)

When
 Q = allowable release from detention pond = 15.59CFS
 H = average depth of water in detention system = 3.5ft

So
 $A = Q / (C \cdot (2 \cdot g \cdot H)^{1/2})$
 $= 15.59 / (0.6 \cdot (2 \cdot 32.2 \cdot 3.5)^{1/2})$
 $= 1.73 \text{ft}^2$

Area Provided= 1.73 S.F.

100 YRS ORIFICE CALCULATIONS


From the orifice equation
 $Q = C \cdot A \cdot (2 \cdot g \cdot H)^{1/2}$

Where
 Q = rate of discharge (ft³/s)
 A = orifice area (ft²)
 C = orifice coefficient (usually about 0.60)
 g = gravitational constant (32.2 ft/s²)
 H = depth of water above the centroid of the orifice (ft)


When
 Q = allowable release from detention pond = 16.13CFS
 H = average depth of water in detention system = 3.5ft

So
 $A = Q / (C \cdot (2 \cdot g \cdot H)^{1/2})$
 $= 16.13 / (0.6 \cdot (2 \cdot 32.2 \cdot 3.5)^{1/2})$
 $= 1.79 \text{ft}^2$

Area Provided=1.79 S.F.

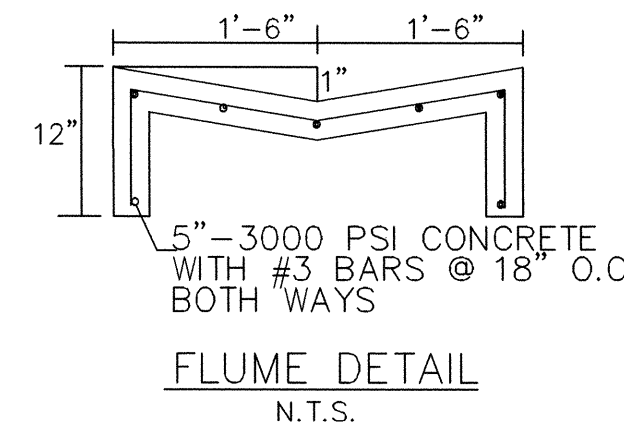

LINE "B" CURB INLET CAPACITY
 $Q = CwLH^{3/2}$
 Q100= 2.02 CFS
 H=CURB OPENING HT.(0.5 FT)
 2.02=3XLX0.5^{3/2}
 L = 1.90 FT.
 THEREFORE 5 FT. CURB INLET.

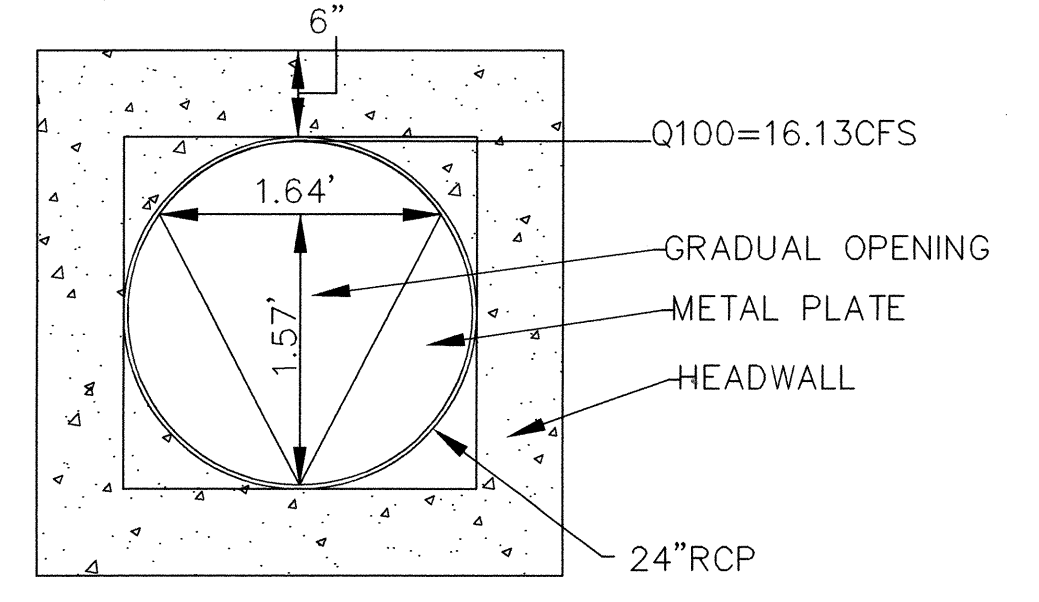

LINE "E" CURB INLET CAPACITY
 $Q = CwLH^{3/2}$
 Q100= 4.85 CFS
 H=CURB OPENING HT.(0.5 FT)
 4.85=3XLX0.5^{3/2}
 L = 4.57 FT.
 THEREFORE 5 FT. CURB INLET.

5 YRS ORIFICE CALCULATIONS

From the orifice equation
 $Q = C \cdot A \cdot (2 \cdot g \cdot H)^{1/2}$

Where
 Q = rate of discharge (ft³/s)
 A = orifice area (ft²)
 C = orifice coefficient (usually about 0.60)
 g = gravitational constant (32.2 ft/s²)
 H = depth of water above the centroid of the orifice (ft)

When
 Q = allowable release from detention pond = 10.40 CFS
 H = average depth of water in detention system = 3.5ft

So
 $A = Q / (C \cdot (2 \cdot g \cdot H)^{1/2})$
 $= 10.40 / (0.6 \cdot (2 \cdot 32.2 \cdot 3.5)^{1/2})$
 $= 1.15 \text{ft}^2$

Area Provided = 1.15 S.F.

VOLUME CALCULATION

ELEVATION (ft)	AREA (sf)	AV.AREA (sf)	INCR DEPTH (ft)	INCR VOL. (cf)	CUMM. VOL. (cf)
22					
23	14443	7221	1	7221	7221
24	17116	15779	1	15779	23000
25	19960	18538	1	18538	41538
26	22962	21461	1	21461	62999

DISCHARGE TABLE

Storm	Q.Allowable	Q.Actual	Water Surface Elevation
5 yrs	10.4	10.4	524.46
25 yrs	14.14	14.14	525.09
50 yrs	15.59	15.59	525.39
100 yrs	16.13	16.13	525.69

CHANNEL "A" (TRAPEZOIDAL SECTION) SLOPE FOR NORMAL DEPTH PROVIDED:
 Q100=2300 CFS
 LEFT SIDE SLOPE= 3:1
 RIGHT SIDE SLOPE= 3:1
 BOTTOM WIDTH= 0.50 FT
 MANNINGS COEFFICIENT=0.030
 RESULT: NORMAL DEPTH(Q100)=2.50 FT

Culvert Summary Table: Culvert "A"

Total Discharge (cfs)	Culvert Discharge (cfs)	Headwater Elevation (ft)	Inlet Control Depth (ft)	Outlet Control Depth (ft)	Flow Type	Normal Depth (ft)	Critical Depth (ft)	Outlet Depth (ft)	Talwater Depth (ft)	Outlet Velocity (ft/s)	Talwater Velocity (ft/s)
0.00	0.00	36.50	0.000	0.0*	0-NF	0.000	0.000	0.000	0.000	0.000	0.000
0.57	0.20	36.73	0.234	0.0*	1-S2n	0.069	0.162	0.071	0.061	3.052	1.654
1.13	0.42	36.81	0.309	0.0*	1-S2n	0.140	0.227	0.140	0.091	4.541	2.096
1.70	0.68	36.87	0.389	0.0*	1-S2n	0.164	0.276	0.166	0.114	6.336	2.414
2.26	0.72	36.92	0.420	0.0*	1-S2n	0.179	0.313	0.209	0.135	4.886	2.638
2.83	0.86	36.96	0.462	0.0*	1-S2n	0.193	0.339	0.229	0.153	4.976	2.803
3.39	1.02	37.00	0.496	0.0*	1-S2n	0.211	0.370	0.219	0.169	6.171	2.991
3.96	1.16	37.03	0.532	0.0*	1-S2n	0.225	0.396	0.226	0.184	6.701	3.153
4.52	1.26	37.06	0.563	0.0*	1-S2n	0.236	0.420	0.240	0.199	6.934	3.277
5.09	1.41	37.09	0.593	0.0*	1-S2n	0.251	0.444	0.268	0.211	6.810	3.386
5.65	1.63	37.12	0.621	0.0*	1-S2n	0.264	0.463	0.272	0.223	6.914	3.514

* theoretical depth is impractical. Depth reported is corrected.

Inlet Elevation (invert): 36.50 ft, Outlet Elevation (invert): 33.20 ft
 Culvert Length: 80.09 ft, Culvert Slope: 0.0412

Culvert Summary Table: Culvert "F"

Total Discharge (cfs)	Culvert Discharge (cfs)	Headwater Elevation (ft)	Inlet Control Depth (ft)	Outlet Control Depth (ft)	Flow Type	Normal Depth (ft)	Critical Depth (ft)	Outlet Depth (ft)	Talwater Depth (ft)	Outlet Velocity (ft/s)	Talwater Velocity (ft/s)
0.00	0.00	22.00	0.000	0.0*	0-NF	0.000	0.000	0.000	0.000	0.000	0.000
1.61	1.51	22.60	0.604	0.0*	1-S2n	0.402	0.434	0.403	0.170	3.577	1.622
3.23	3.23	22.86	0.863	0.003	1-S2n	0.566	0.624	0.573	0.253	4.320	2.033
4.84	4.84	23.08	1.063	0.066	1-S2n	0.700	0.771	0.705	0.316	4.070	2.327
6.45	6.45	23.30	1.290	0.122	1-S2n	0.822	0.895	0.824	0.372	5.295	2.530
8.06	8.06	23.49	1.488	0.169	1-S2n	0.931	1.010	0.934	0.418	5.601	2.718
9.68	9.68	23.67	1.666	0.212	1-S2n	1.036	1.109	1.038	0.462	5.879	2.867
11.29	11.29	23.84	1.838	0.262	1-S2n	1.141	1.205	1.144	0.502	6.080	2.994
12.90	12.90	24.01	2.012	0.288	1-S2n	1.246	1.288	1.246	0.538	6.263	3.123
14.52	14.52	24.20	2.195	0.323	1-S2n	1.354	1.371	1.356	0.573	6.411	3.222
16.13	16.13	24.46	2.392	0.462	2-MC	1.472	1.444	1.448	0.606	6.623	3.321

* theoretical depth is impractical. Depth reported is corrected.

Inlet Elevation (invert): 22.00 ft, Outlet Elevation (invert): 21.75 ft
 Culvert Length: 38.92 ft, Culvert Slope: 0.0064

HYDRAULIC GRADE COMPUTATION FOR LINE "C"

MANHOLE OR INLET	PIPE LENGTH DISTANCE BETWEEN COLLECTION POINTS	STORM WATER RUNOFF "Q" 100YR (c.f.s.)	PIPE FLOW "Q" (c.f.s.)	SIZE OF PIPE (in)	FRICTION GRADIENT SLOPE (ft/ft)	HYDRAULIC GRADIENT ELEVATION		HEAD LOSS AT CHANGE IN SECTION						HGL		
						UP-STREAM (ft MSL)	DOWN-STREAM (ft MSL)	INFLOW VEL. V1 (fps)	OUTFLOW VELOCITY V2 (fps)	V1 ² 2g (ft)	V2 ² 2g (ft)	Kj	Hj			
STA 0+00																
	STA 1+15.85	115.85	11.7	12.9	18	0.0124	35.04	33.60	3.86	6.63	0.23	0.68	0.75	0.28		35.32
STA 1+15.85																
	STA 1+42.10	26.25	6.83	12.9	18	0.0042	35.43		2.47	3.86	0.09	0.23	0.75	0.08		35.51
STA 1+42.10																
	STA 2+35.80	93.70	4.36	12.96	18	0.0017	35.67		0.00	2.47	0.00	0.09	1.25	0.11		35.78

HYDRAULIC GRADE COMPUTATION FOR LINE "B"

MANHOLE OR INLET	PIPE LENGTH DISTANCE BETWEEN COLLECTION POINTS	STORM WATER RUNOFF "Q" 100YR (c.f.s.)	PIPE FLOW "Q" (c.f.s.)	SIZE OF PIPE (in)	FRICTION GRADIENT SLOPE (ft/ft)	HYDRAULIC GRADIENT ELEVATION		HEAD LOSS AT CHANGE IN SECTION						HGL		
						UP-STREAM (ft MSL)	DOWN-STREAM (ft MSL)	INFLOW VEL. V1 (fps)	OUTFLOW VELOCITY V2 (fps)	V1 ² 2g (ft)	V2 ² 2g (ft)	Kj	Hj			
STA 0+00																
	STA 0+98.54	112.07	2.0	10.5	18	0.0004	38.54	38.50	0.00	1.14	0.00	0.02	1.25	0.03		38.57

ALL RESPONSIBILITY FOR ADEQUACY OF DESIGN REMAINS WITH THE DESIGN ENGINEER. THE CITY OF ROCKWALL, IN REVIEWING AND RELEASING PLANS FOR CONSTRUCTION, ASSUMES NO RESPONSIBILITY FOR ADEQUACY OR ACCURACY OF DESIGN.

AS-BUILT

FIRM REGISTRATION # F-8396

THE DIMENSION GROUP

CIVIL ENGINEERING • LAND DEVELOPMENT • PLANNING • ARCHITECTURE • CONSTRUCTION MANAGEMENT
 10755 SANDHILL ROAD, DALLAS, TEXAS 75238 TEL: 214-343-9400 FAX: 214-341-6800

DATE: 4/8/11
 BY: KP
 REVISIONS:
 NO. 1 AS-BUILTS

Racetrac
 THESE PLANS ARE SUBJECT TO FEDERAL COPYRIGHT LAWS. ANY USE OF SAME WITHOUT THE EXPRESSED WRITTEN PERMISSION OF RACETRAC PETROLEUM, INC. IS PROHIBITED.
 © 2000 RACETRAC PETROLEUM, INC.

Racetrac
 RACETRAC PETROLEUM, INC.
 300 TECHNOLOGY COURT
 SMYRNA, GEORGIA 30082
 (770) 431-7600

DRAINAGE CALCS
 RACETRAC SERVICE STATION
 SH 205 & SH 276
 ROCKWALL, TEXAS
 N.T.S.
 SCALE: ICS
 DRAWN BY: TCS
 DATE: 5/18/10
 DWG NO.: 7.1

7.1

SHEET NO. REV.