

PAMREX 24 INCH MANHOLE COVER AND FRAME

Manhole cover and frame shall be called PAMREX or approved equal. Cover and frame shall be manufactured from Ductile Iron.

Covers shall be hinged and incorporate a 90 degree blocking system to prevent accidental closure. Covers shall be one man operable using standard tools and shall be capable of withstanding a test load of 80,000 lbs.

Frames shall be circular, incorporate a seating ring and fitted plug in the hinge housing, and be available in a 24 inch clear opening. The frame depth shall not exceed 4 inches, and the flange shall incorporate bedding clots, bolt holes, and lifting eyes.


All components shall be black coated.

Frame weight: 73 lbs.
Cover weight: 122 lbs.
Total weight: 195 lbs.

PAMREX is available from Jim Cox Sales, Inc. (800) 838-7377.

DIMENSIONS (INCHES)			WEIGHT (lbs)		
A	O	H	COVER AND FRAME	COVER	REFERENCE
33 1/2	24	4	195	122	RE 24 R8 FD

ALL SANITARY SEWER WORK DESIGNATED AS "PRIVATE" IN THIS SET OF PLANS SHALL BE INSTALLED IN ACCORDANCE WITH THE INTERNATIONAL PLUMBING CODE, PERMITTED AND INSPECTED BY THE CITY BUILDING INSPECTION DEPARTMENT AND INSTALLED BY A LICENSED CONTRACTOR.

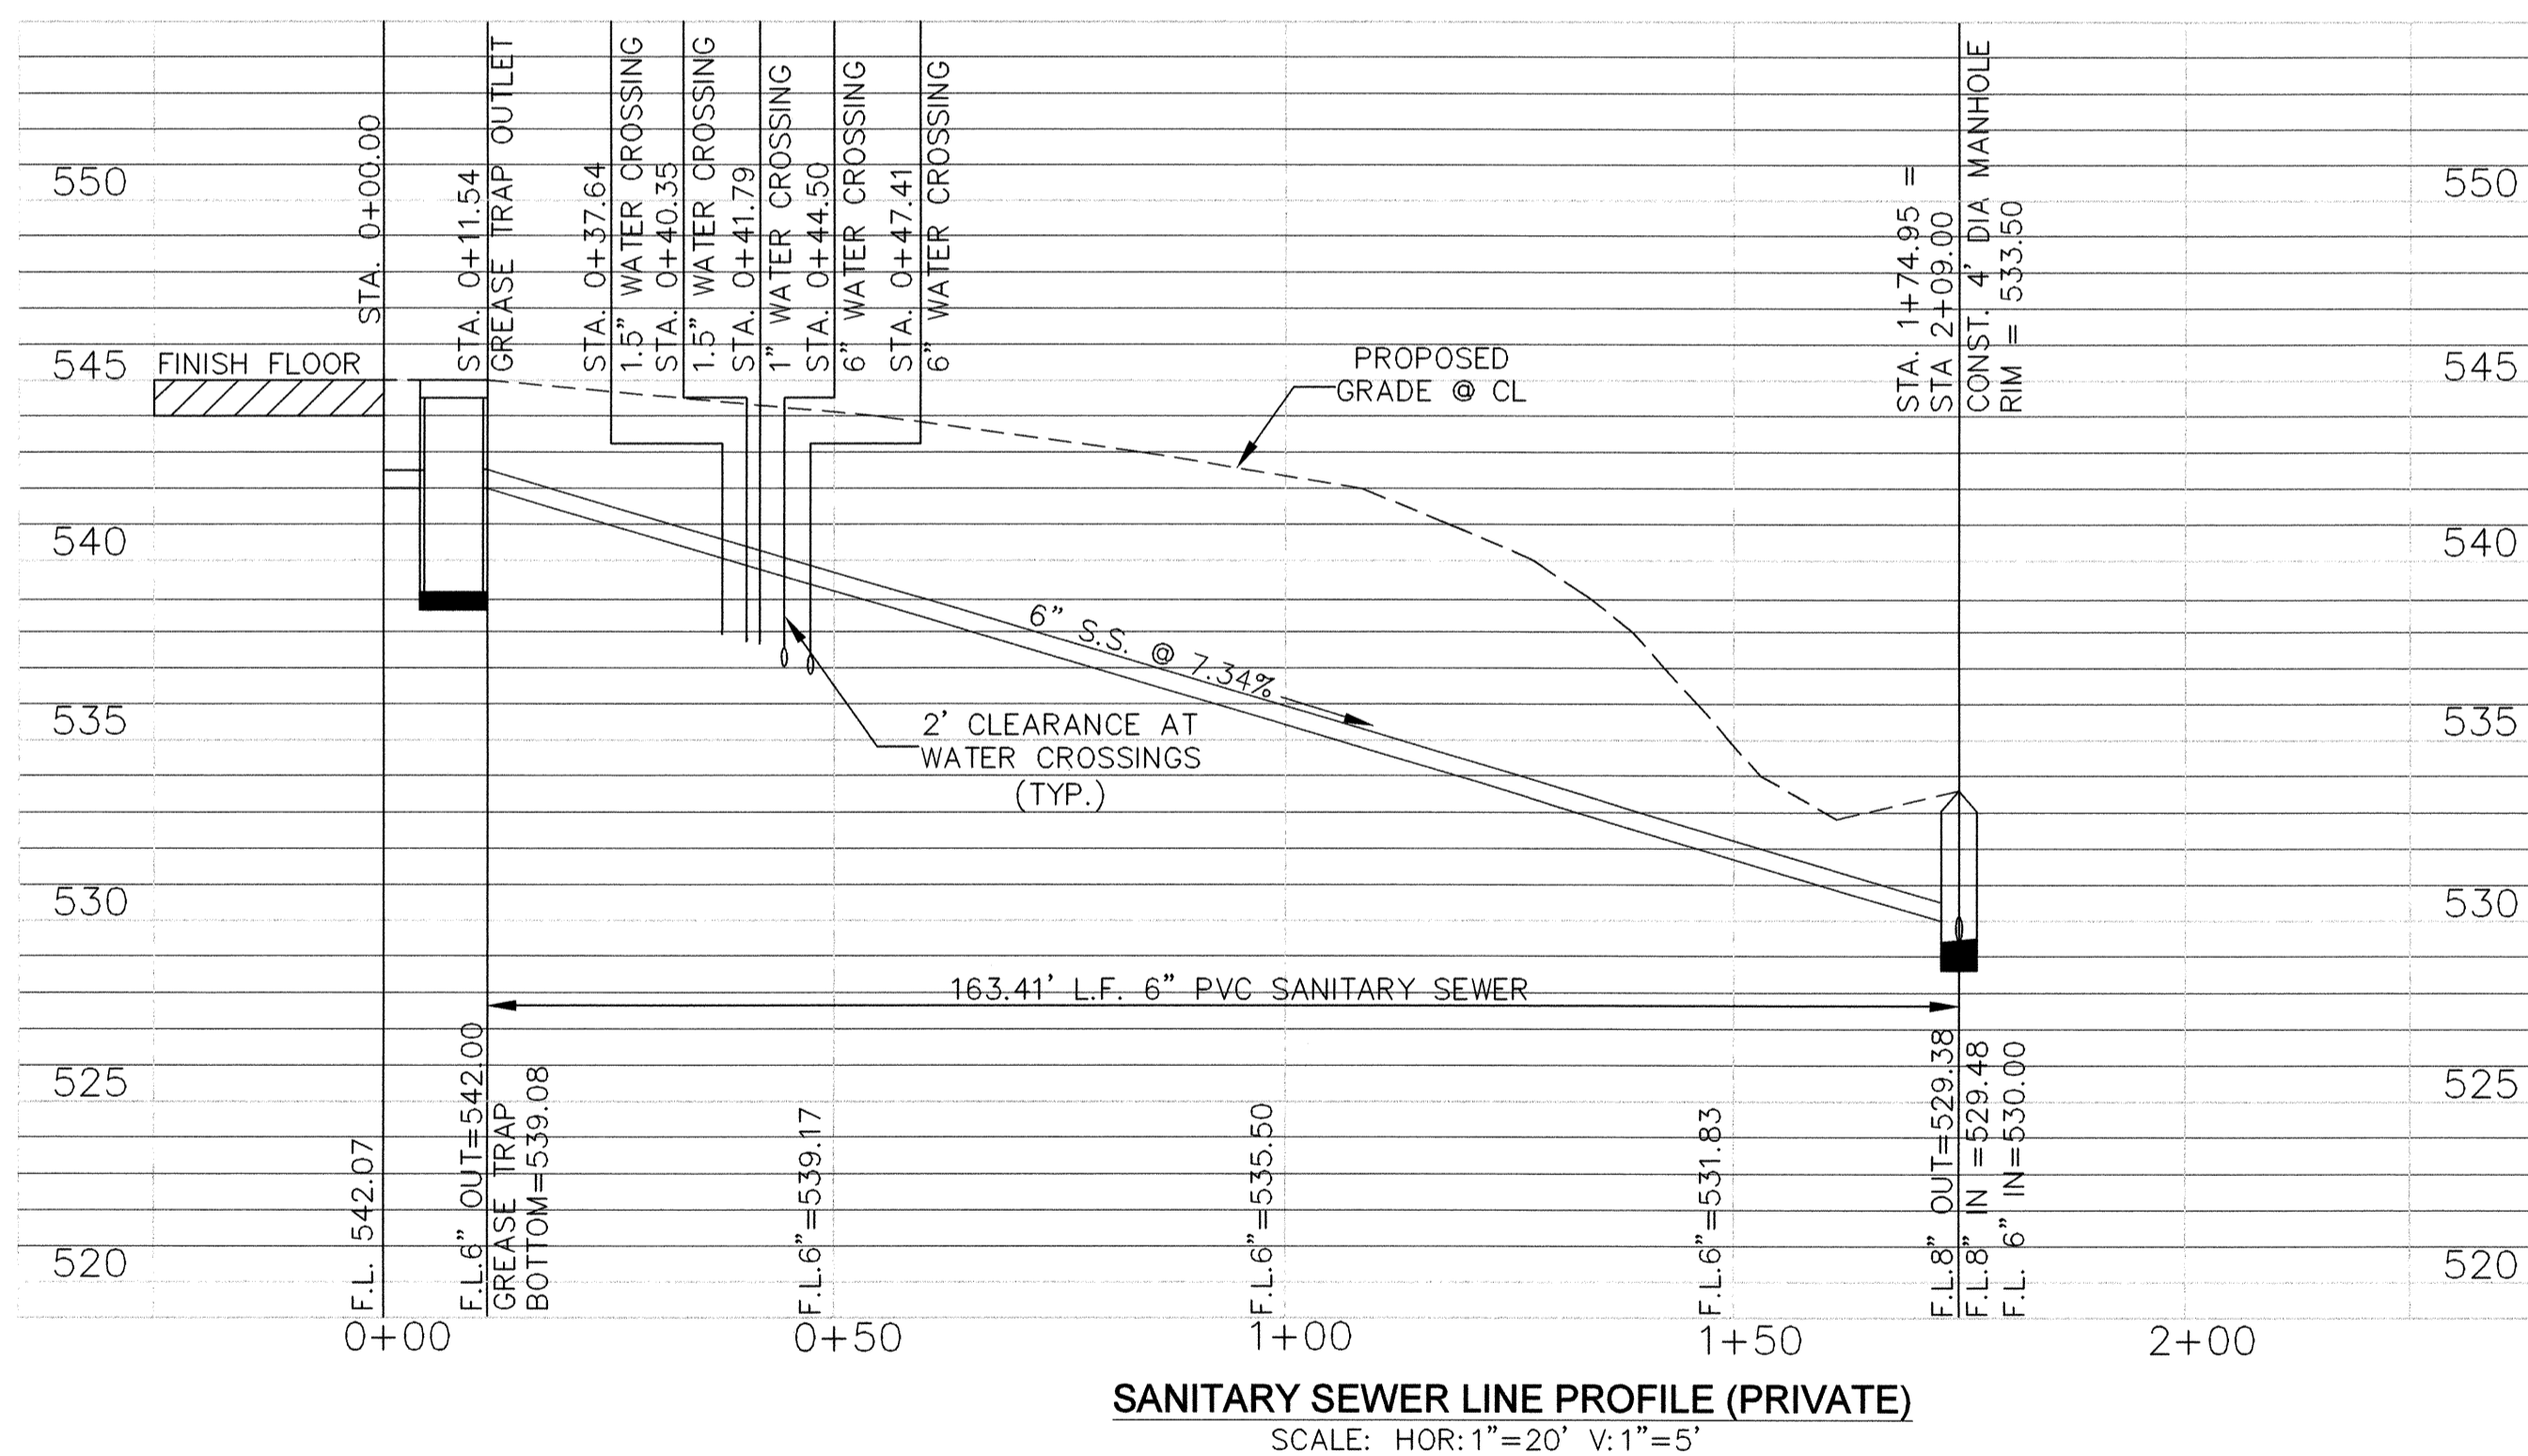

CAUTION!
CONTACT BEFORE YOU DIG-
VERIZON: 1-800-483-4400
ATMOS ENERGY: 1-800-621-1867
CHARTER COMMUNICATION:
1-866-333-8145
CEBRIDGE CONNECTION:
1-877-423-2743
DENTON MANICIPAL ELECTRIC:
1-800-735-2989

EXISTING ABOVE GROUND UTILITIES HAVE BEEN SHOWN BASED ON INFORMATION SHOWN ON A SURVEY OF THE PROPERTY. UNDERGROUND UTILITIES ARE SHOWN BASED ON RECORDED DATA AND MAY NOT BE COMPLETE OR EXACT. THE CONTRACTOR SHALL BE RESPONSIBLE FOR VERIFYING THE LOCATIONS AND DEPTHS OF ALL ABOVE GROUND AND UNDERGROUND UTILITIES PRIOR TO SETTING THE FINISH GRADE. THE CONTRACTOR SHALL BE RESPONSIBLE FOR DAMAGE TO EXISTING ABOVE GROUND OR UNDERGROUND UTILITIES, INCLUDING THOSE NOT SHOWN ON THE PLANS. THE CONTRACTOR IS ADVISED TO CONTACT THE CITY AND ALL FRANCHISE UTILITY COMPANIES, EASEMENT HOLDERS, ETC. AT LEAST 48 HOURS PRIOR TO BEGINNING EXCAVATION IN THE VICINITY OF ANY UNDERGROUND UTILITY.



AS-BUILT

THE DIMENSION GROUP
FIRM REGISTRATION # F-8396
CIVIL ENGINEERING • LAND DEVELOPMENT • PLANNING • ARCHITECTURE • CONSTRUCTION MANAGEMENT
10755 SANDHILL ROAD, DALLAS, TEXAS 75238 TEL: 214-343-9400 FAX: 214-341-9090

UTILITY PROFILES

RACETRAC SERVICE STATION
S.H. 205 & S.H. 276
ROCKWALL, TEXAS

SCALE: 1"=20'
DATE: 5/18/10
DRAWN BY: CS

9.1

SHEET NO. REV.

BY: KP
DATE: 4/18/11

REVISIONS

NO. 1 AS-BUILT

Racetrac
THESE PLANS ARE SUBJECT TO FEDERAL COPYRIGHT LAWS. ANY USE OF SAME WITHOUT THE EXPRESSED WRITTEN PERMISSION OF RACETRAC PETROLEUM, INC. IS PROHIBITED. ©2000 RACETRAC PETROLEUM, INC.

Racetrac
RACETRAC PETROLEUM, INC.
300 TECHNOLOGY COURT
SMYRNA, GEORGIA 30082
(770) 431-7600

KARTHYA SATEL
LICENSED PROFESSIONAL ENGINEER
07594