


DISCLAIMER : The use of this standard is governed by the Texas Engineering Practice Act. No warranty of any kind is made by TxDOT for any purpose whatsoever. TxDOT assumes no responsibility for the conversion of this standard to other formats or for incorrect results or damages resulting from its use.

http://www.dot.state.tx.us/ftw/specinfo/standard.htm cdfw.dgn

LEVELS DISPLAYED	6
	1
	2
	3
	4
	5



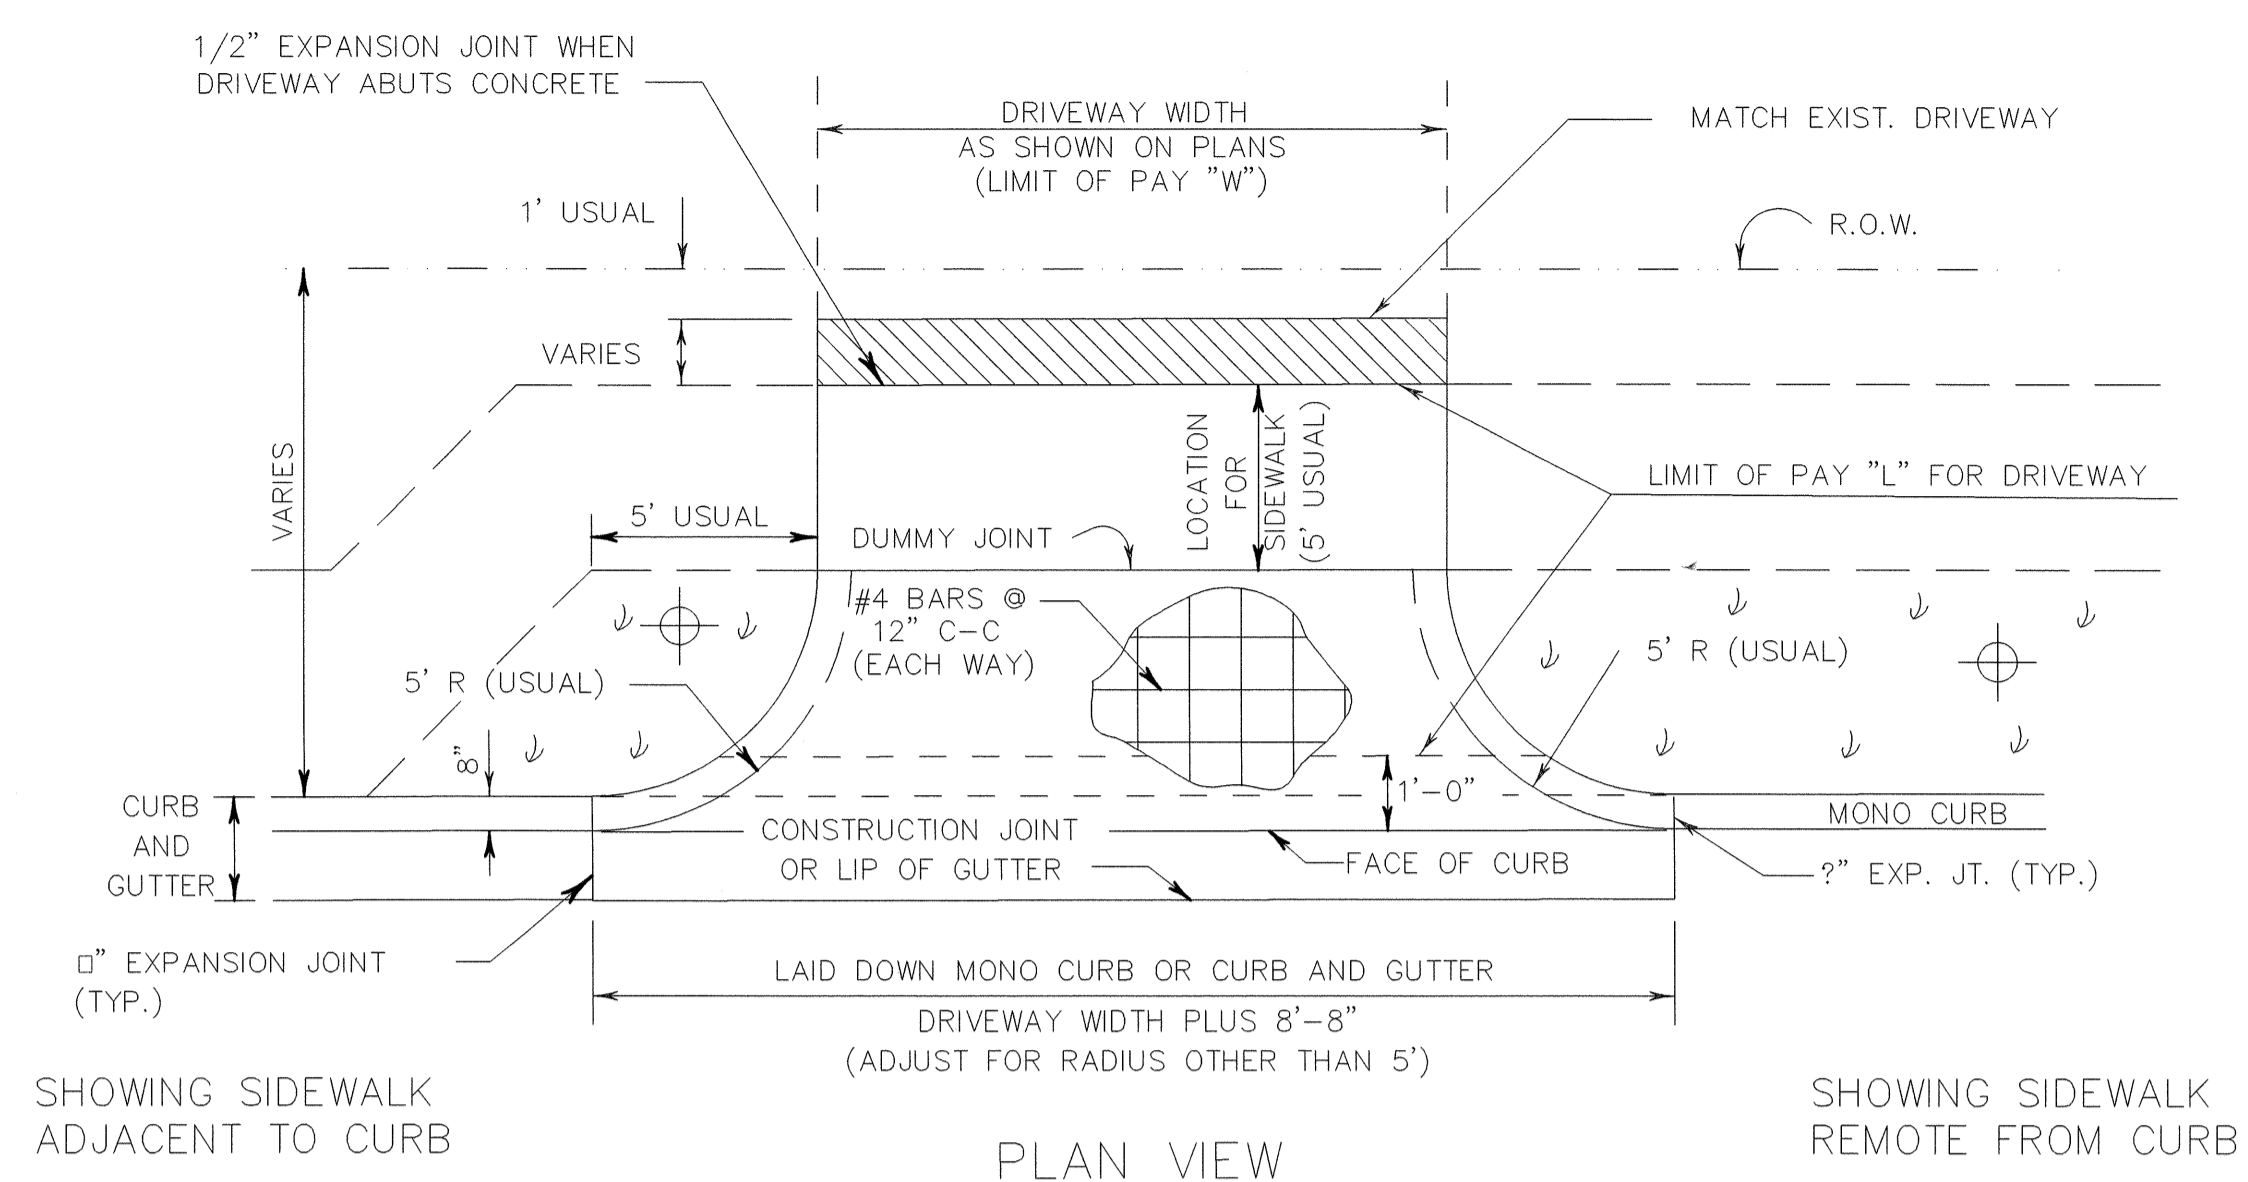


DO NOT PAVE AREA BETWEEN SIDEWALK AND DRIVEWAY CURB. SEED, SOD, OR LANDSCAPE AS DIRECTED.

SEEDING OR OTHER SURFACE NOT SUITABLE AS PEDESTRIAN WALKWAY.



PAY AREA FOR DRIVEWAY SHALL BE THE PRODUCT OF "L" x "W"

S.Y. NON-PAY CONCRETE IN DRIVEWAY RADIUS	S.Y. NON-PAY CONC.
2-90° RADII (FT)	
5	0.42
10	3.04
20	15.36
30	37.19

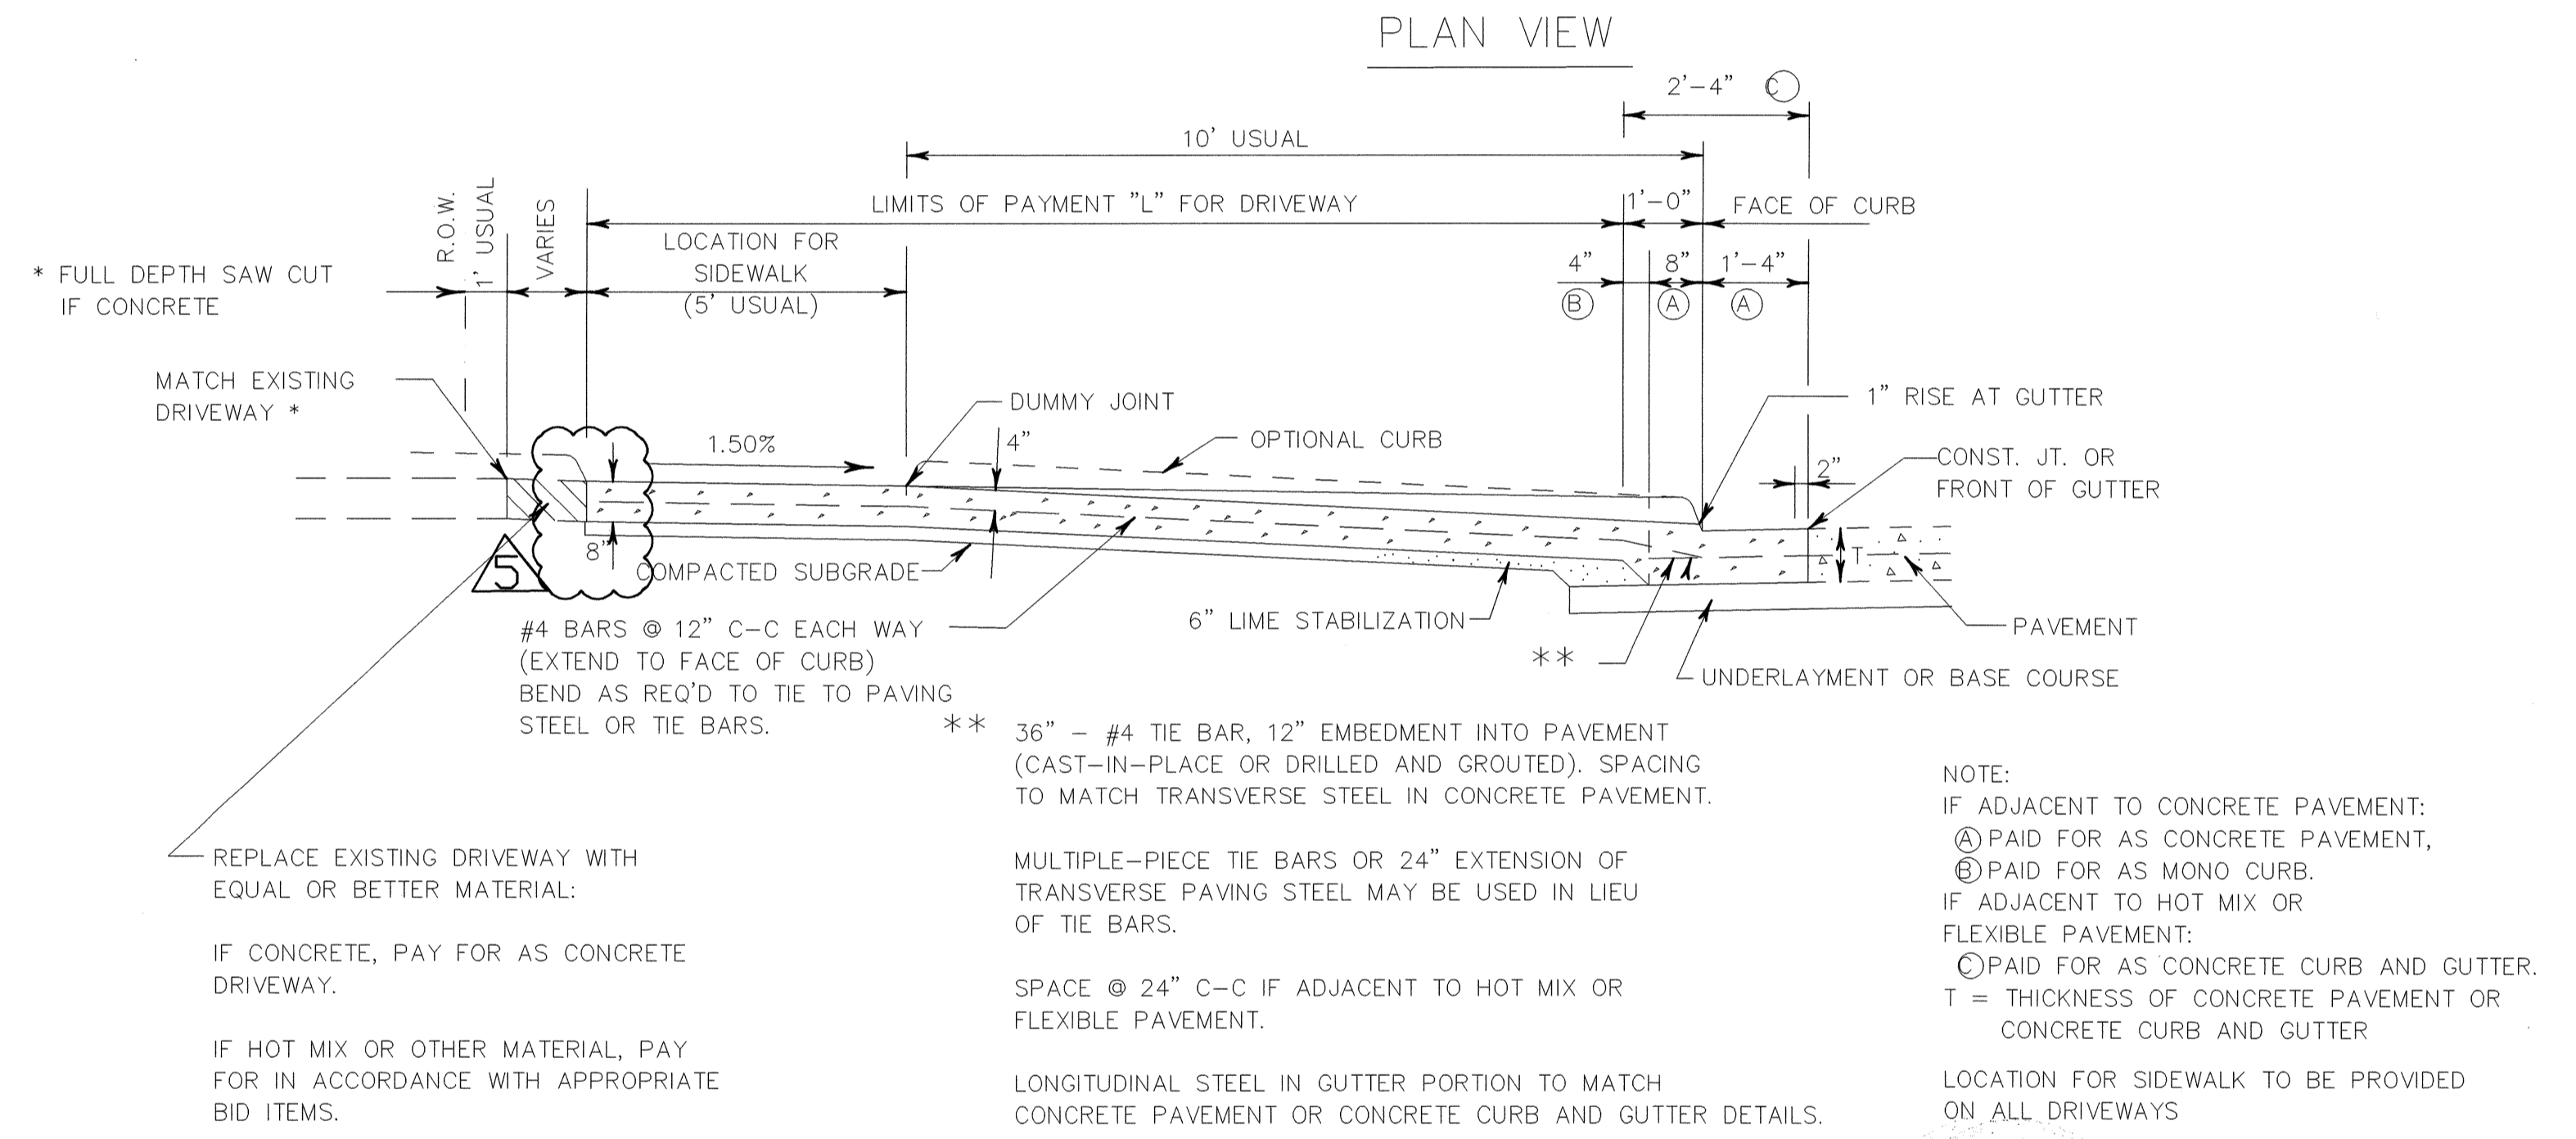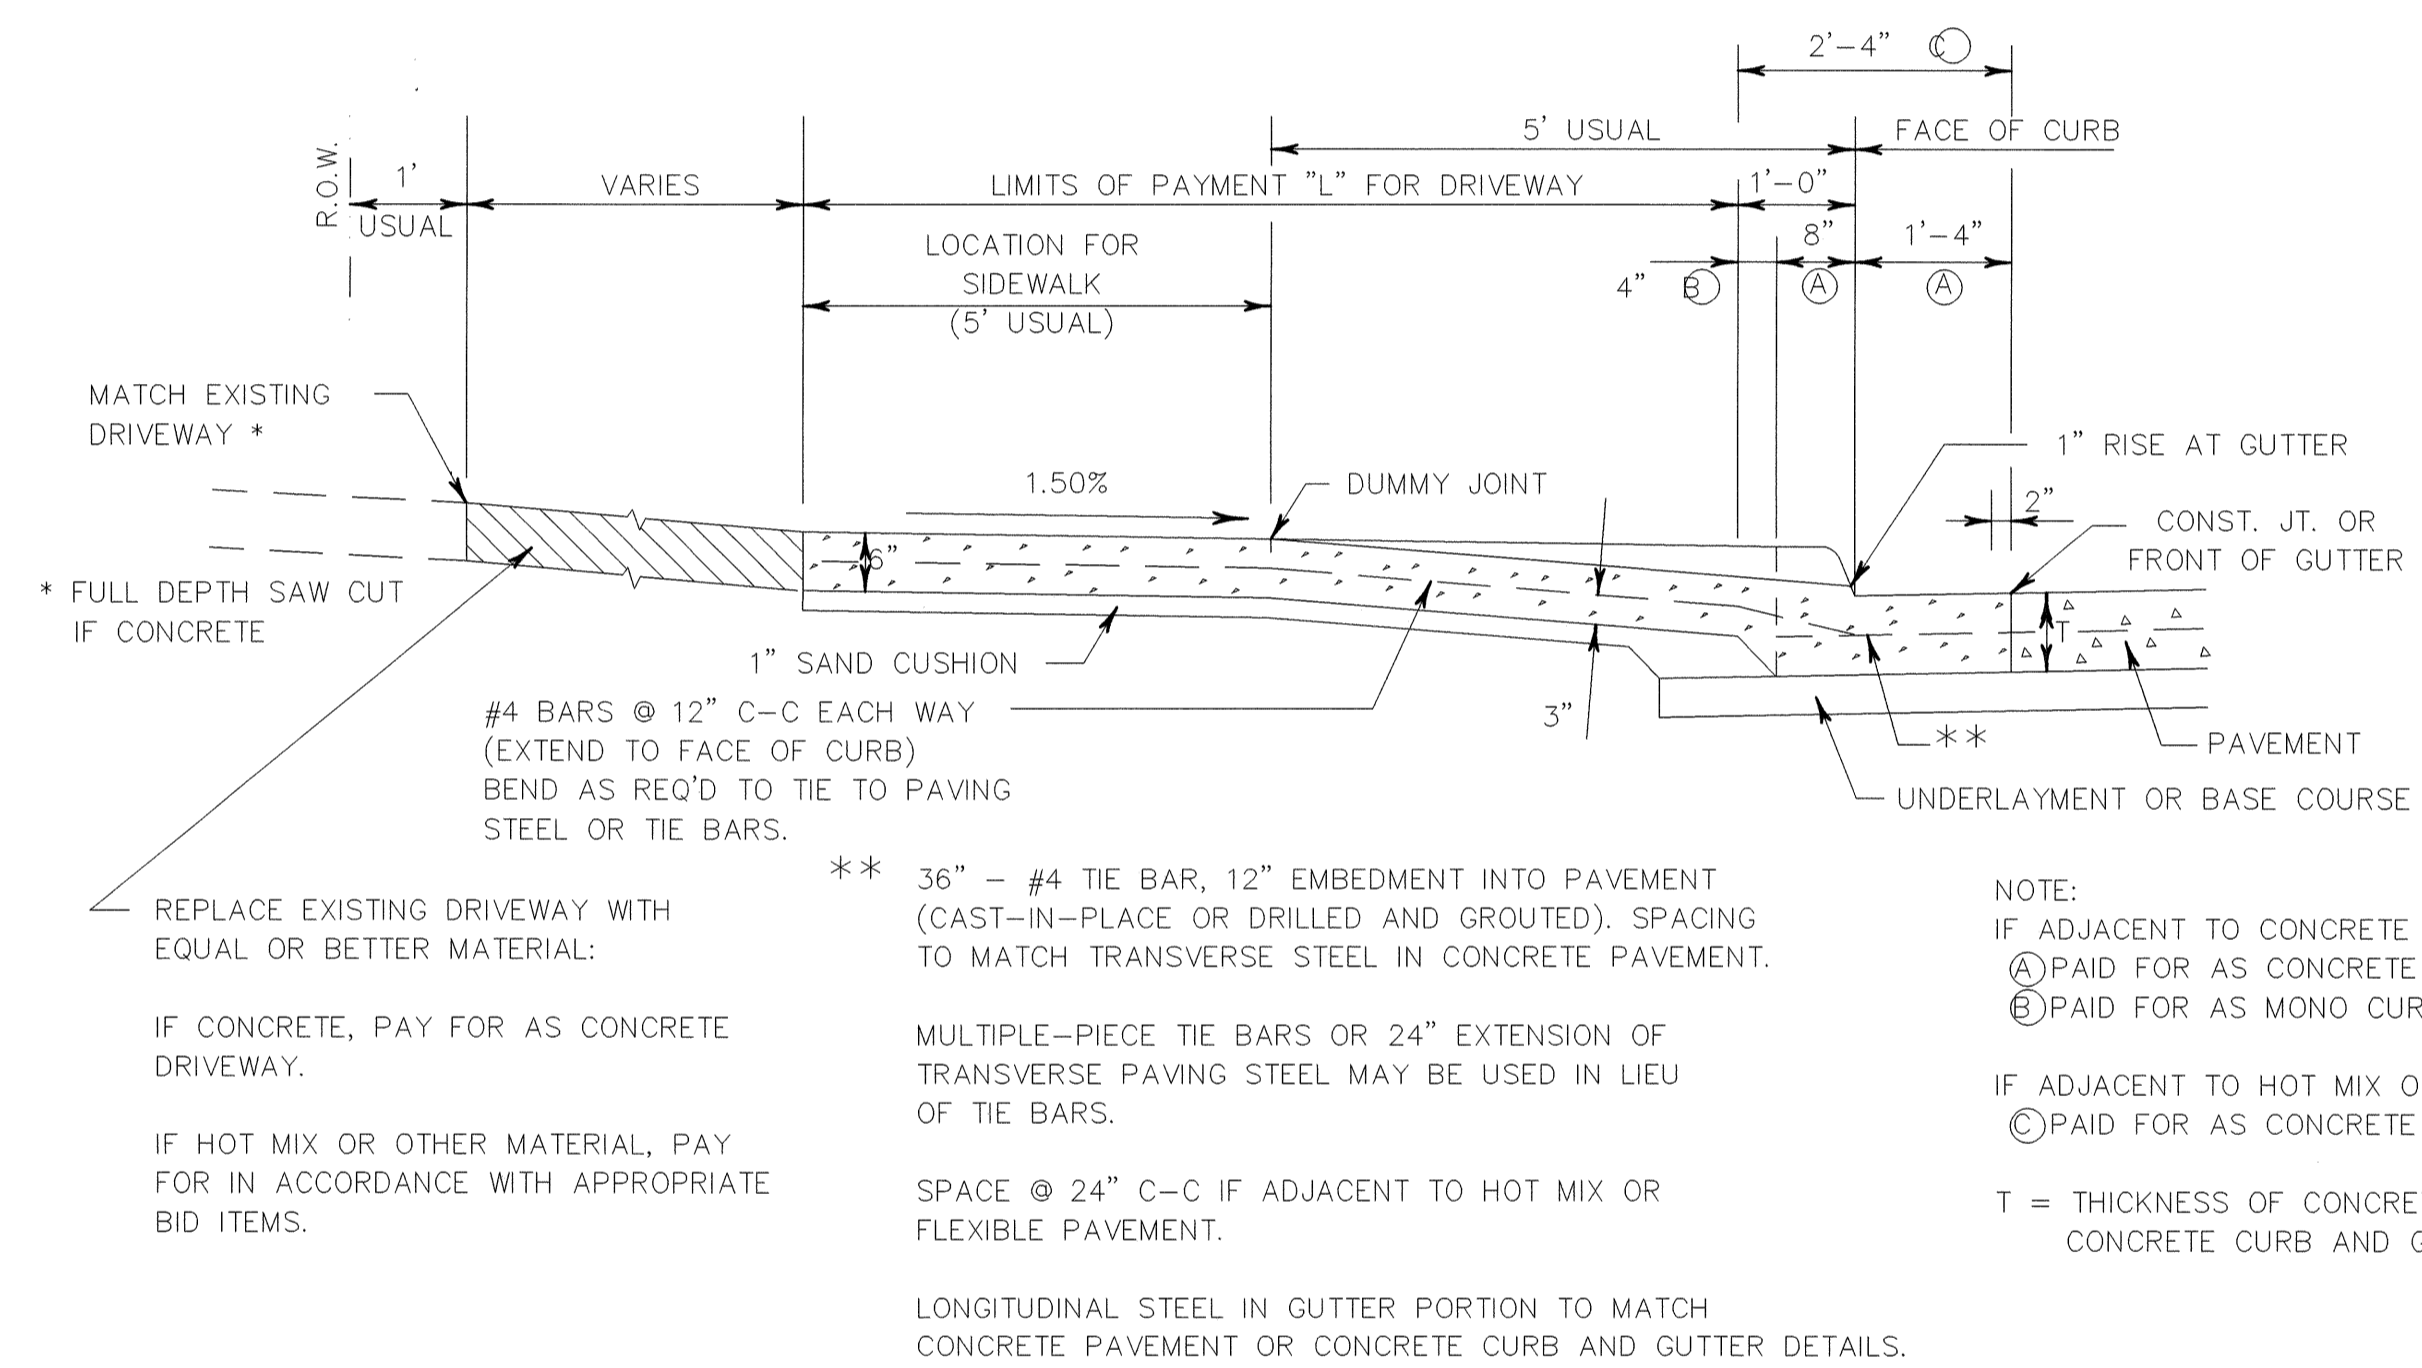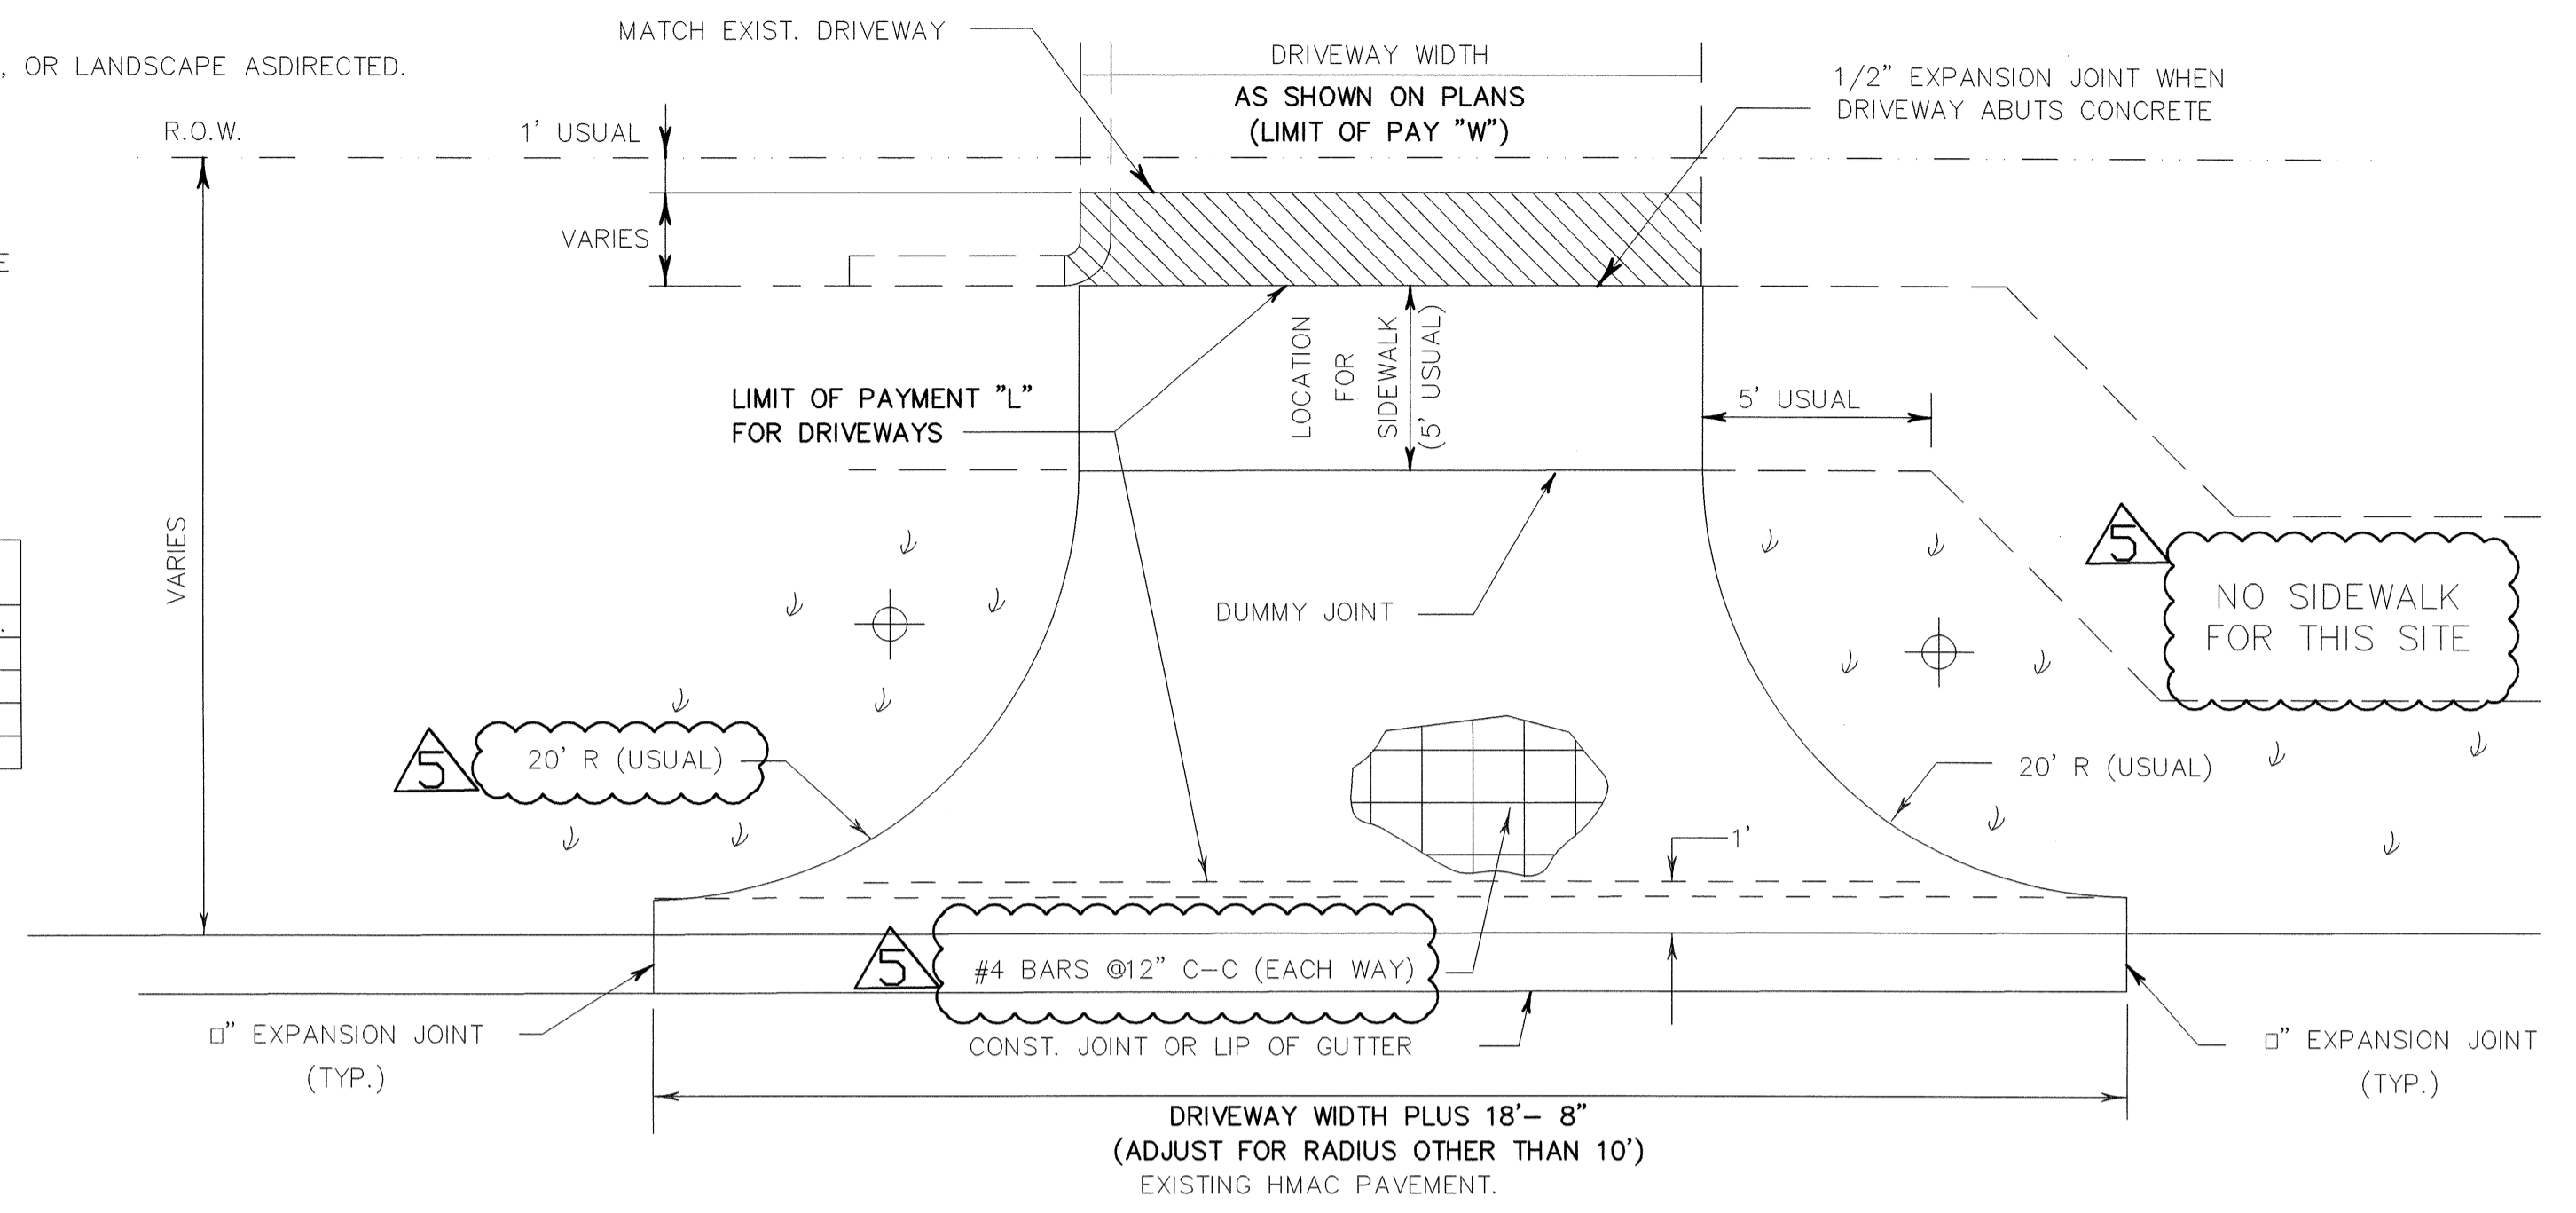

CONCRETE RESIDENTIAL DRIVEWAY

CONCRETE COMMERCIAL DRIVEWAY

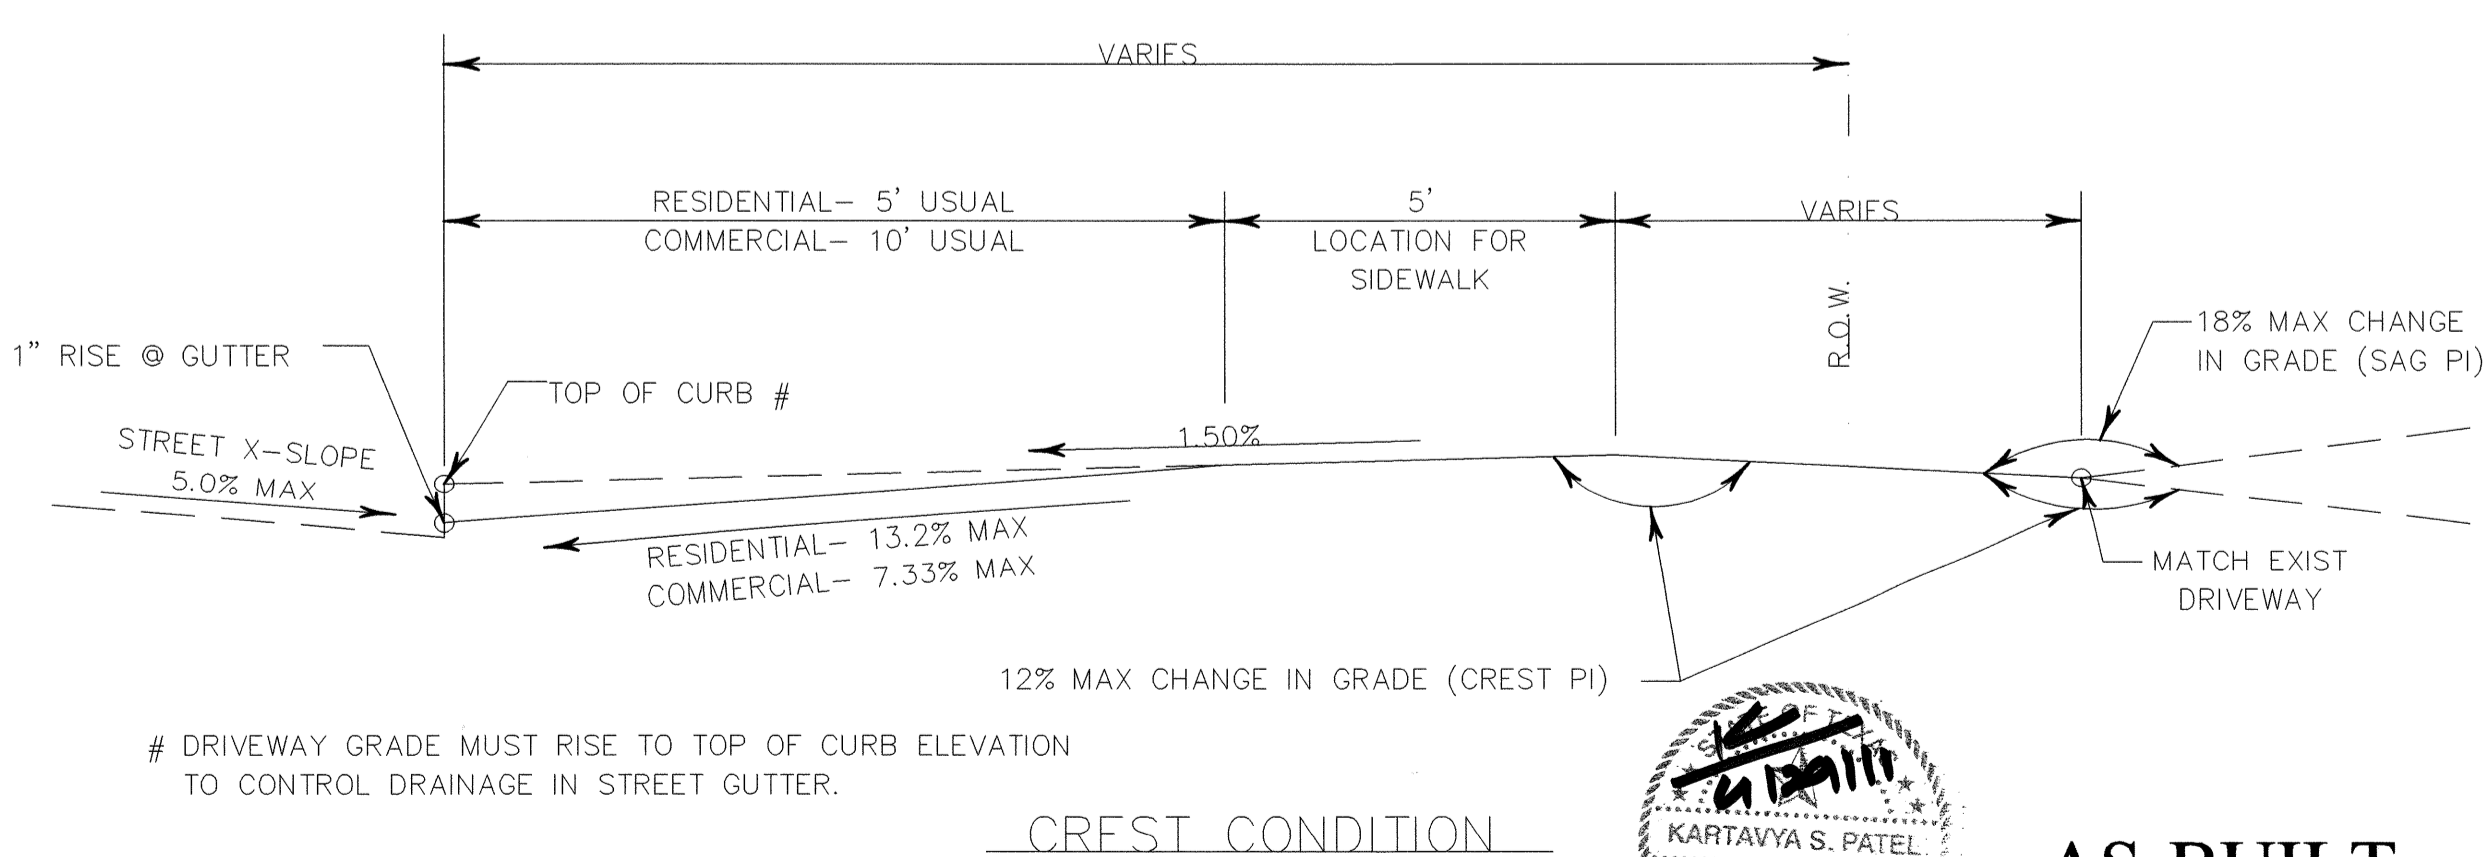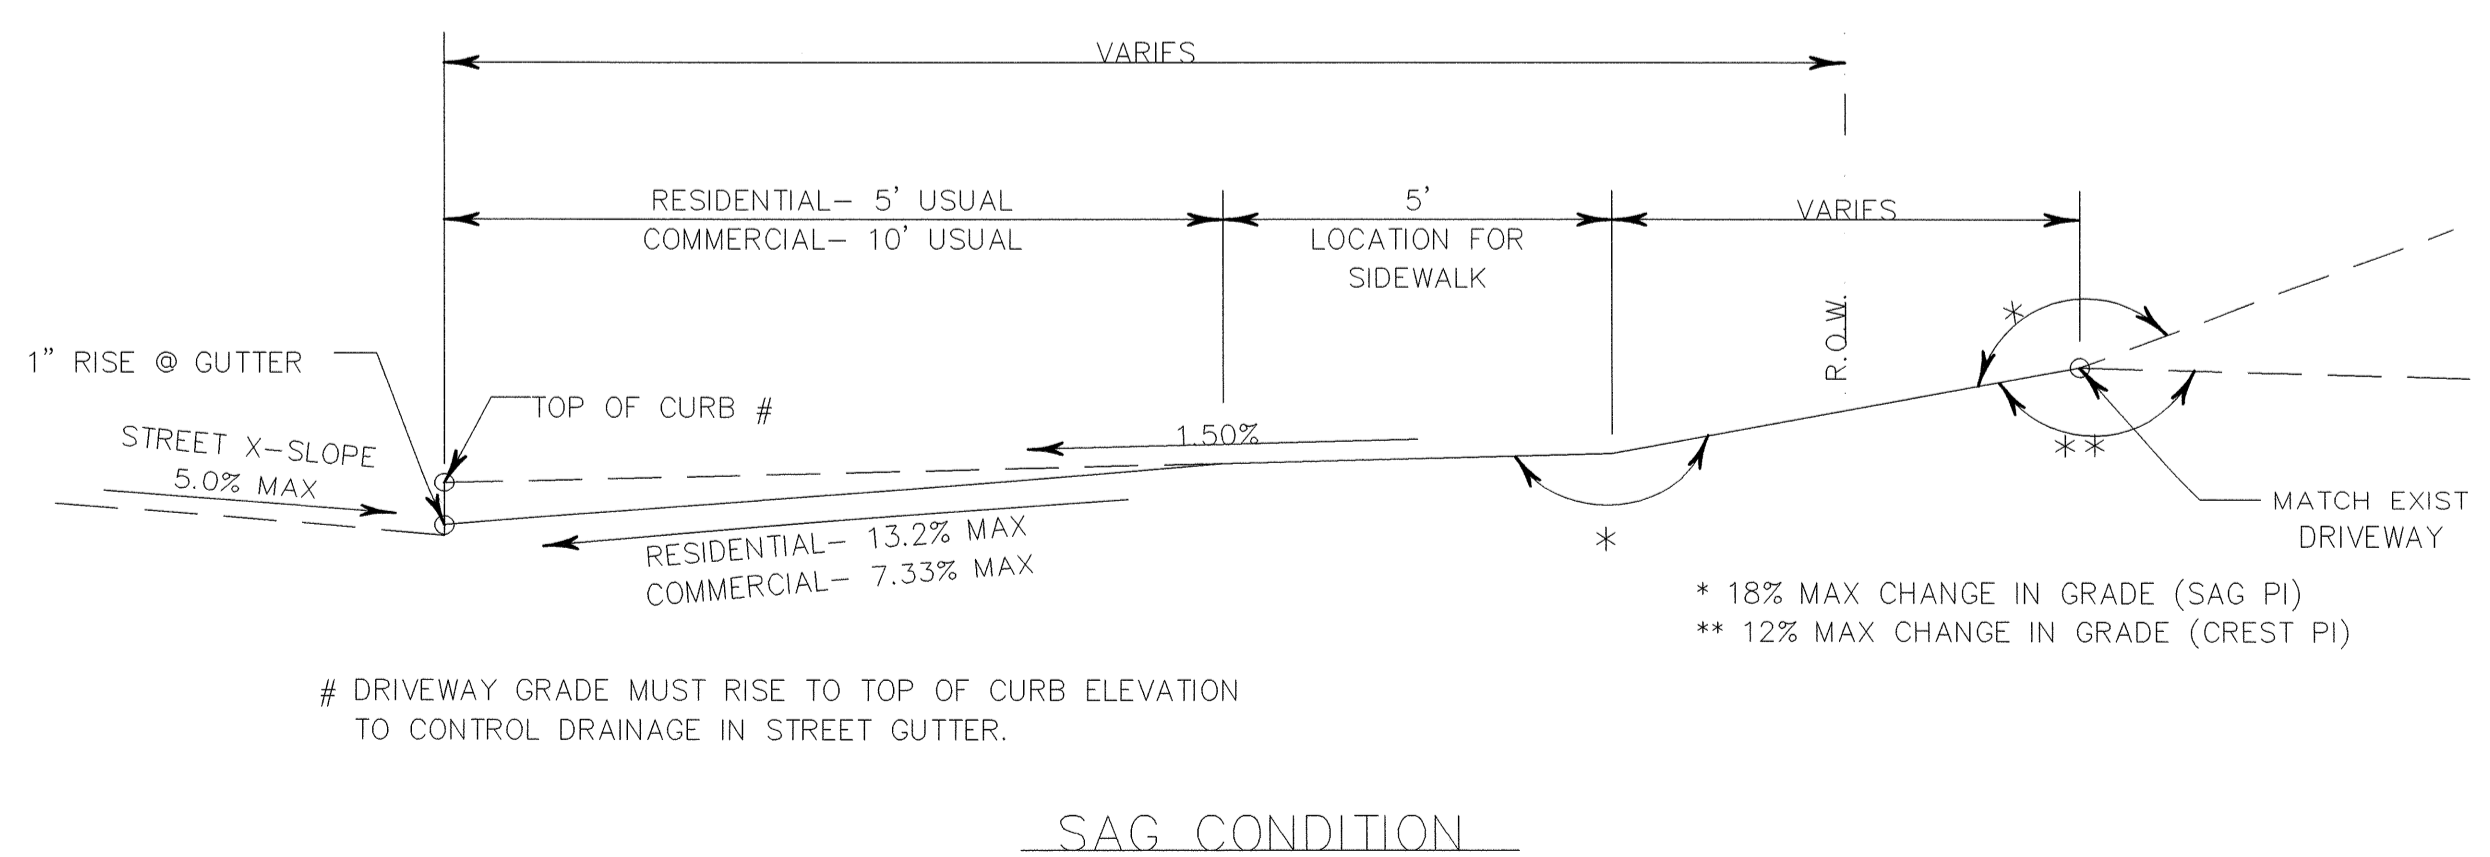

ALLOWABLE DRIVEWAY GRADES



FORT WORTH DISTRICT

CONCRETE DRIVEWAY DETAILS

CDD-08 (FW)

ORIGINAL DRAWING	FED. RD. DIV. NO.	PROJECT NO.	SHEET NO.
JUNE 2008	6		
REVISIONS:	STATE	DIST.	COUNTY
	TEXAS		
	CONT.	SECT.	JOB
			HIGHWAY NO.



AS-BUILT

2008 by Texas Department of Transportation; all rights reserved