

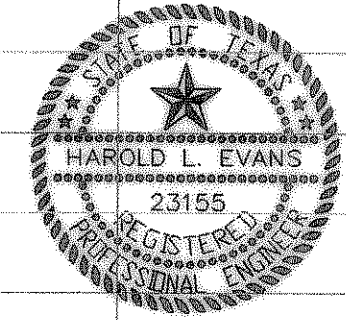
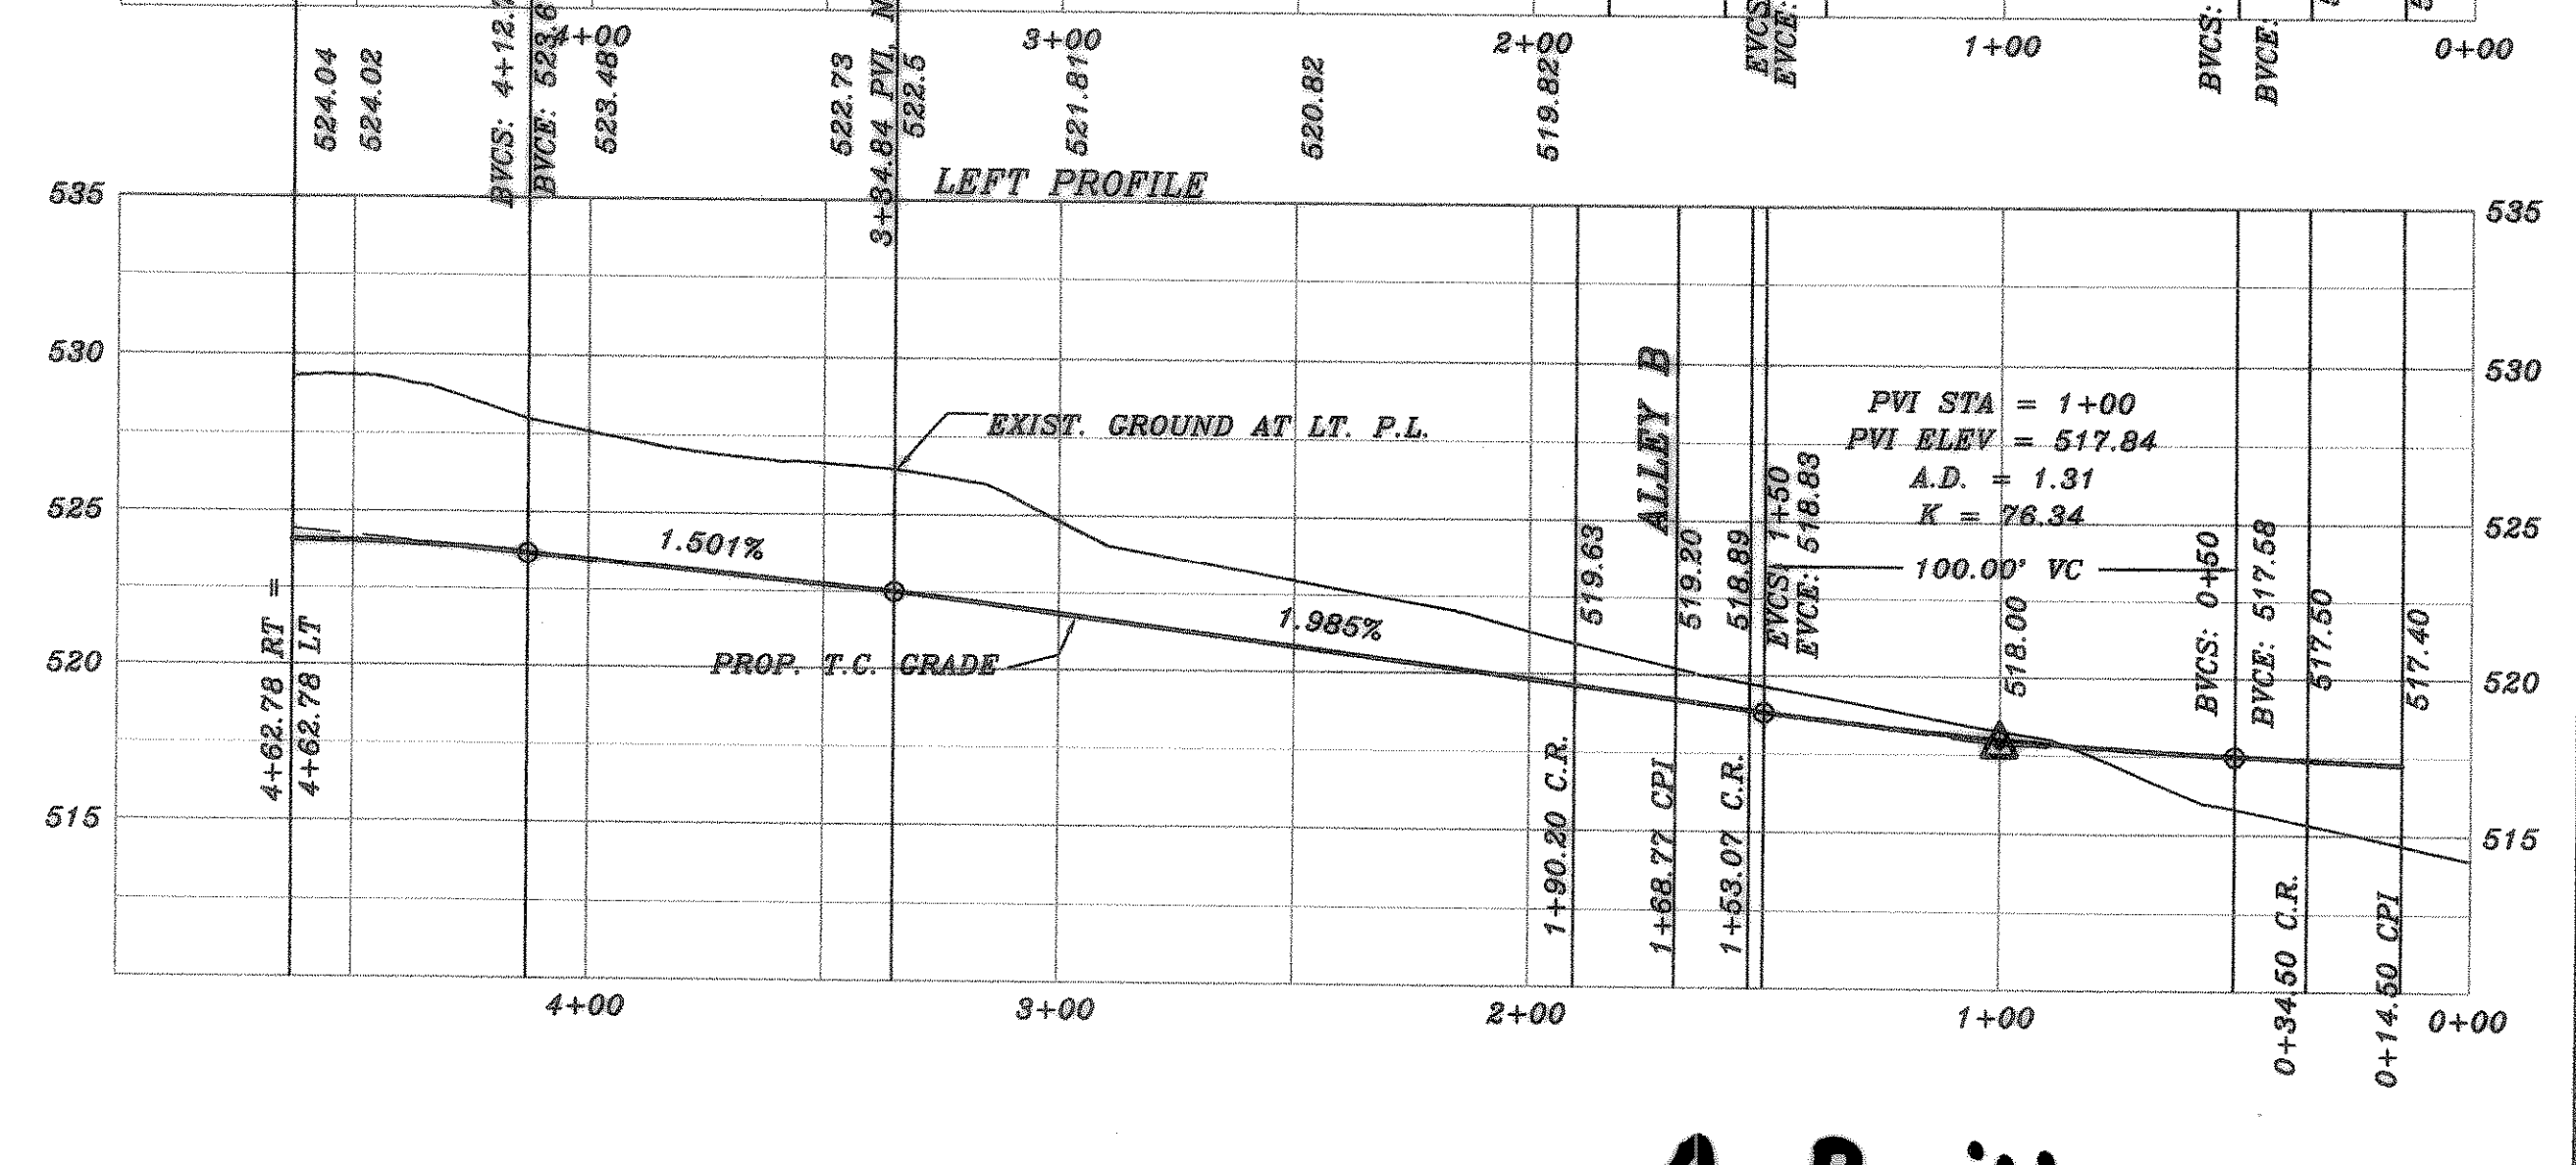
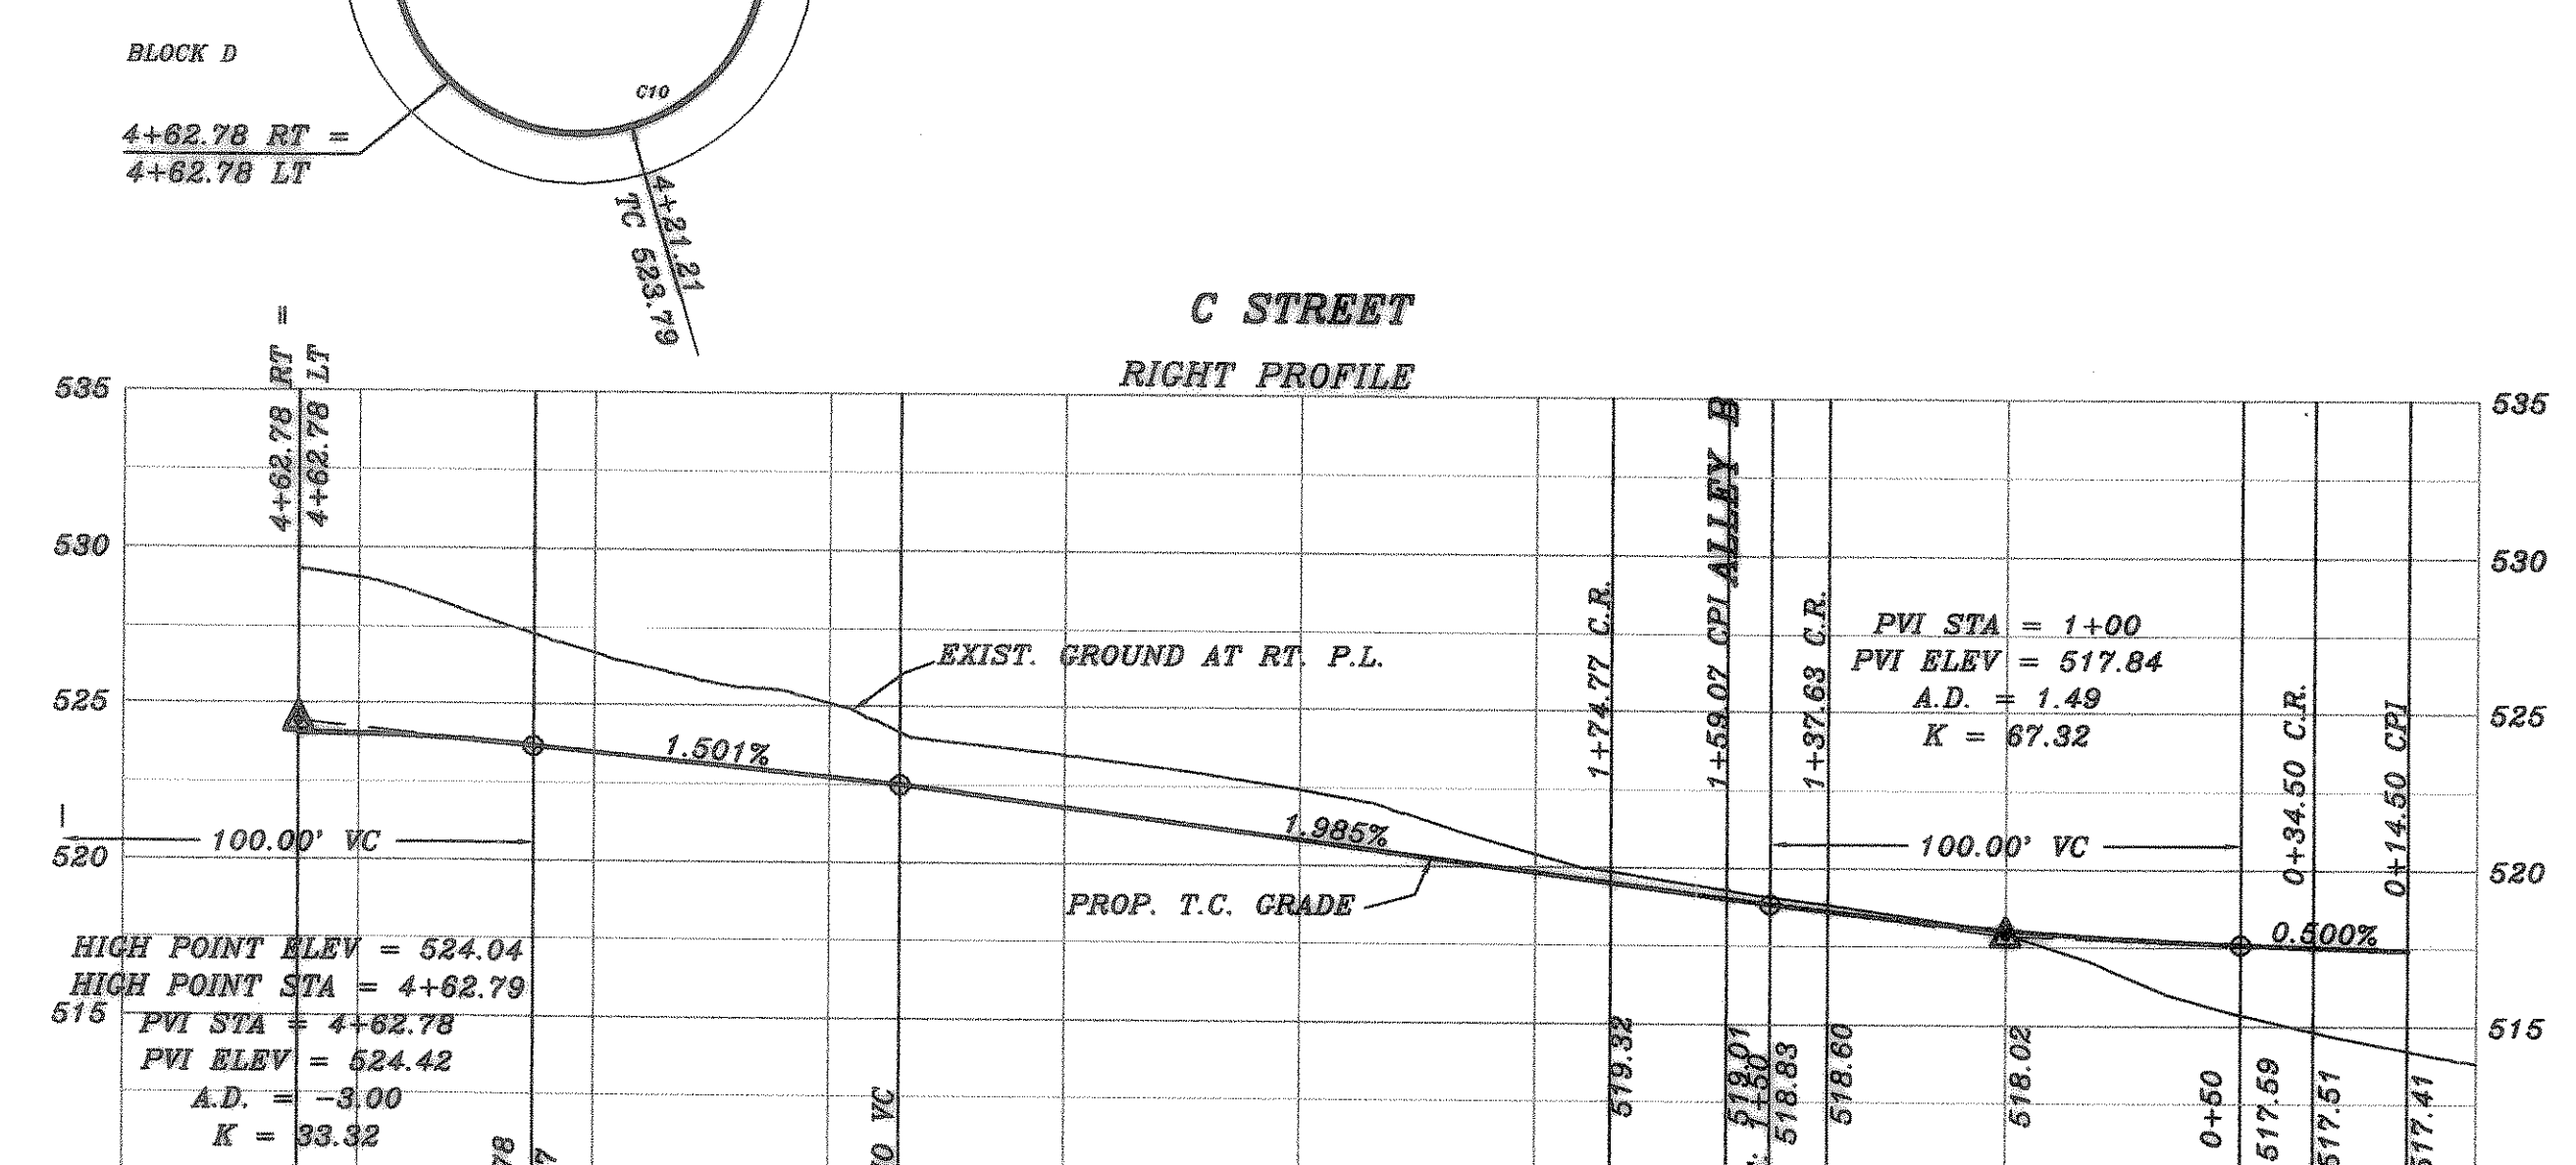
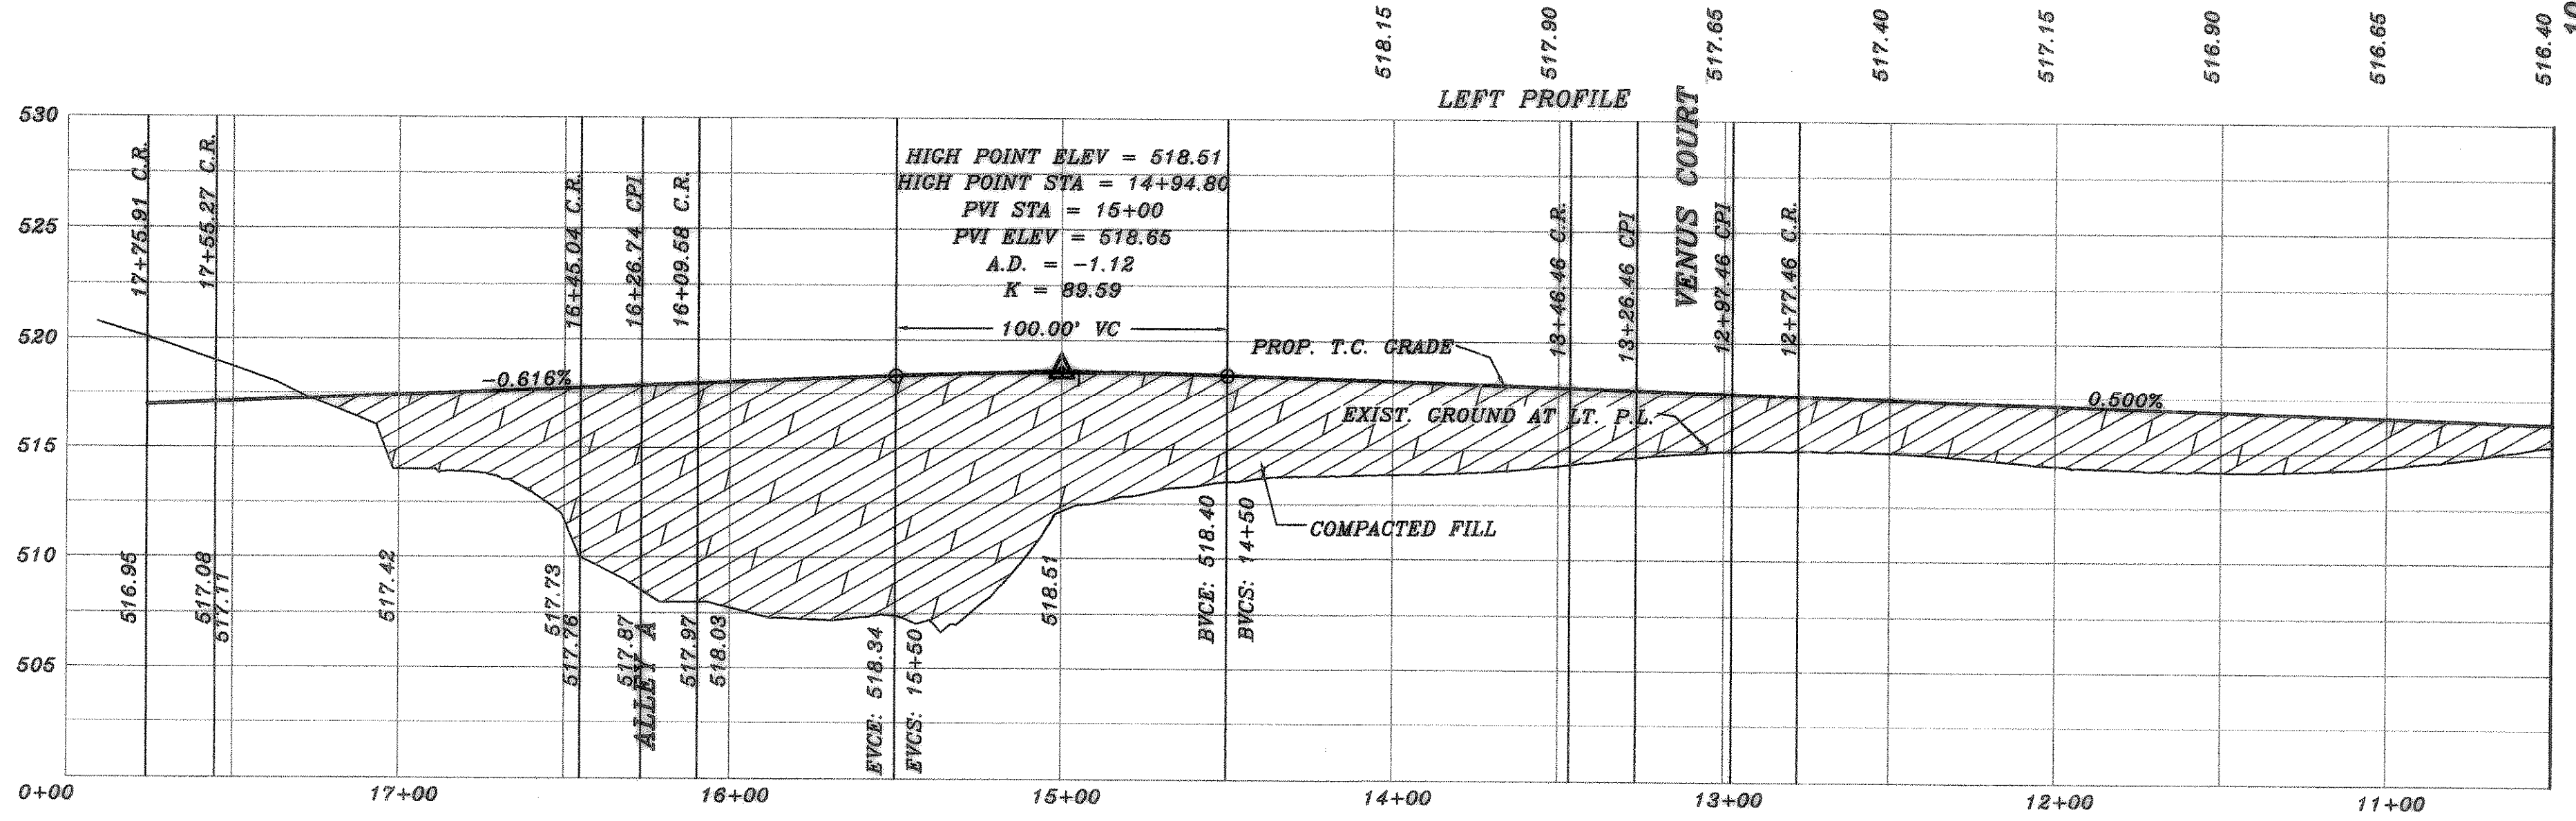
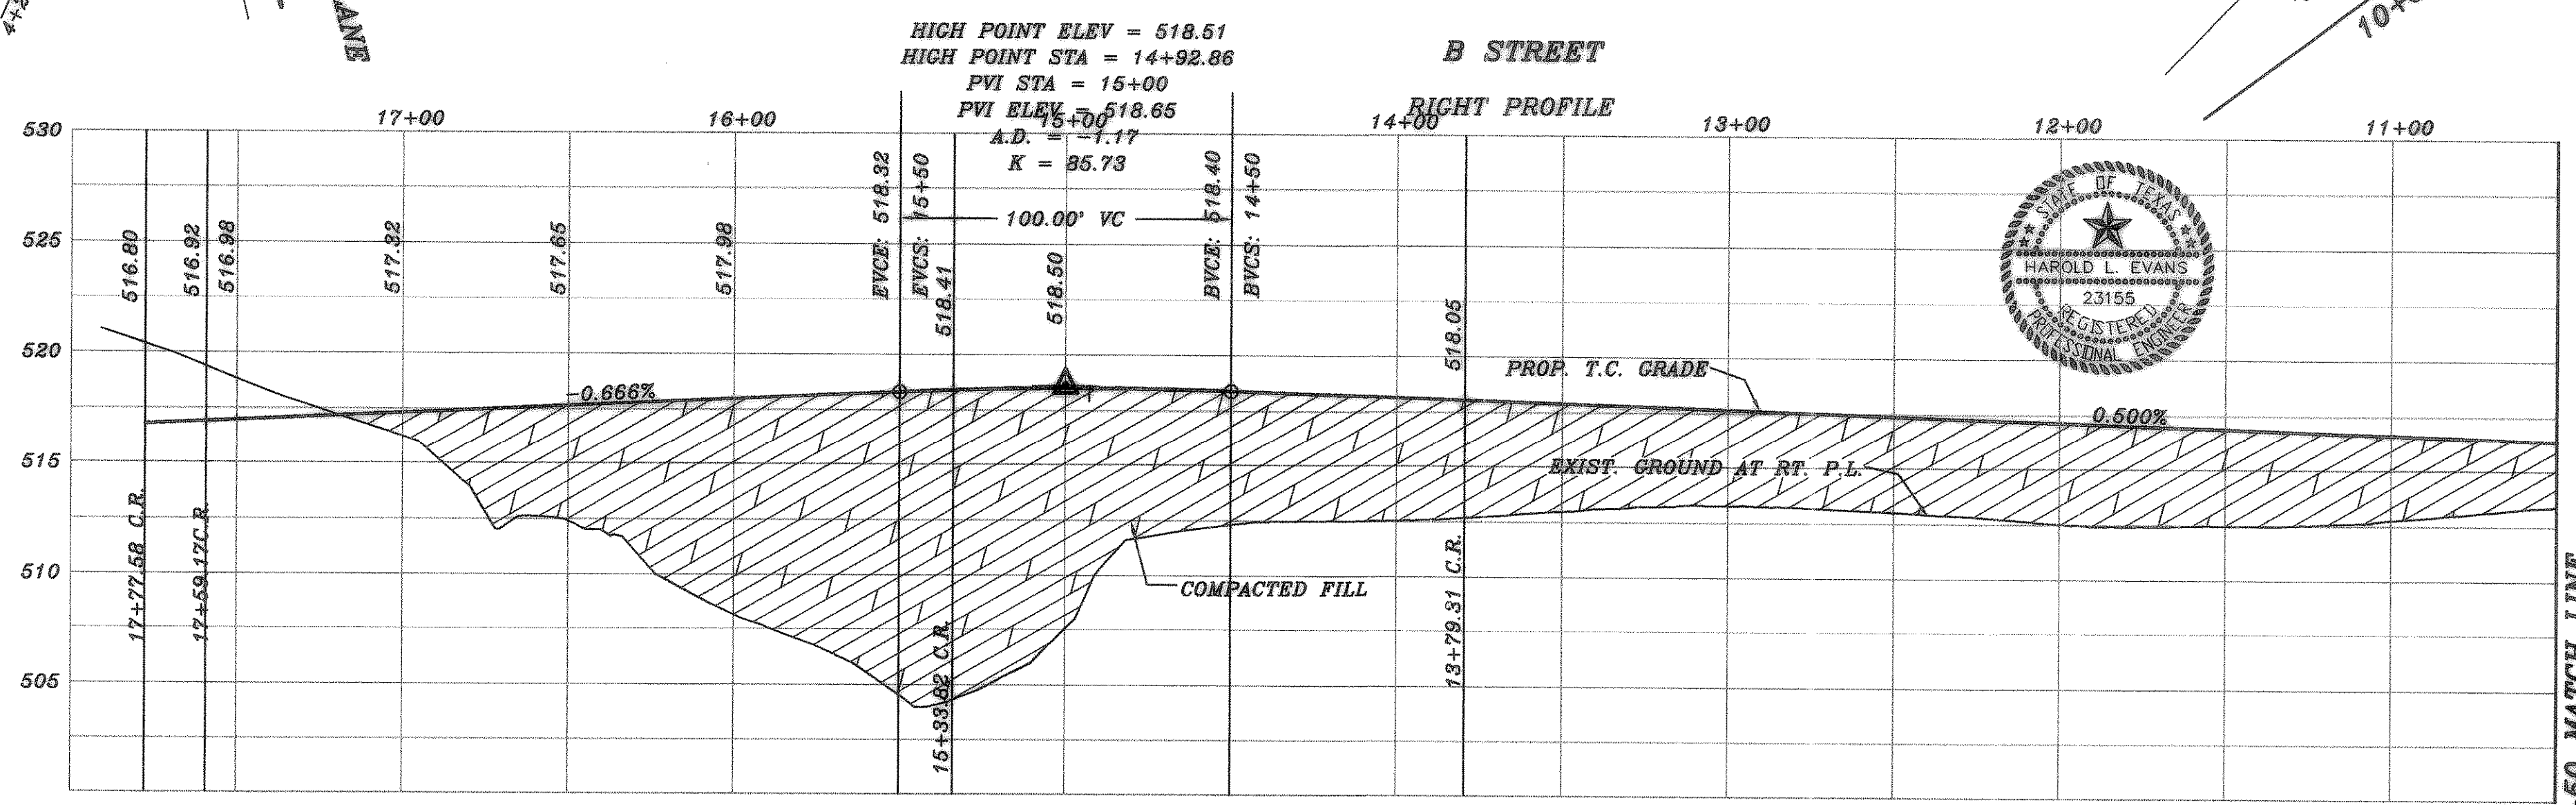


CURVE	RADIUS	LENGTH	TANGENT	DELTA
C1	210.00'	330.02'	210.15'	90°02'28"
C2	210.00'	173.86'	92.26'	47°26'03"
C3	20.00'	4.32'	2.17'	12°17'53"
C4	139.50'	162.75'	92.08'	66°50'39"
C5	20.00'	4.40'	2.21'	12°36'48"
C6	171.50'	55.35'	27.92'	16°29'34"
C7	20.00'	24.74'	14.23'	70°52'08"
C8	20.00'	11.76'	6.08'	33°42'08"
C9	39.50'	92.99'	35.08'	134°52'42"
C10	39.50'	103.20'	145.85'	149°41'34"

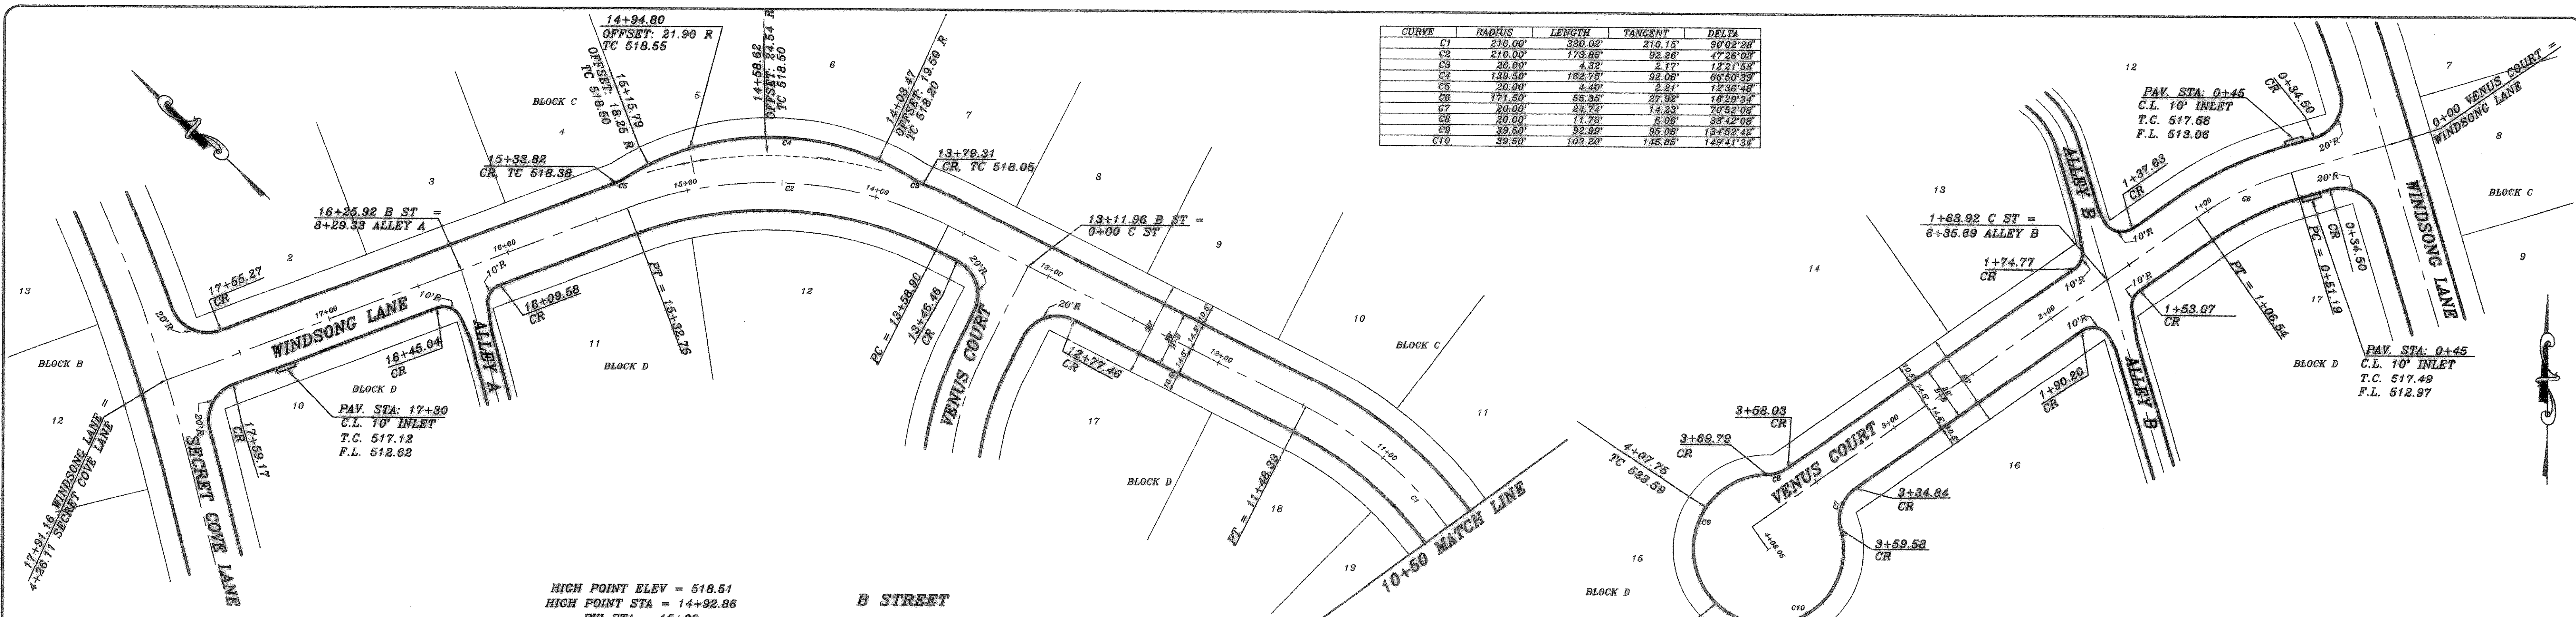

As Built
6-21-05

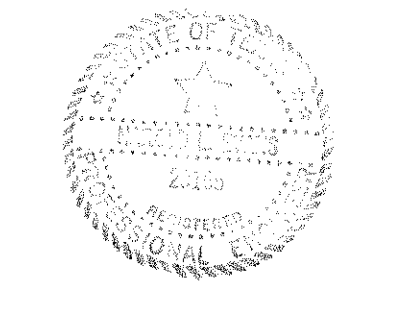

REV. STREET NAMES 4/6/00		DATE 4/10		SCALE 1" = 40' 1" = 6'		DESIGN H.L.E.		DRAWN	
HAROLD L. EVANS CONSULTING ENGINEER P.O. BOX 28355 2331 GUS THOMASSON ROAD, SUITE 102 DALLAS, TEXAS 75228, (214) 388-8133				PROPOSED PAVING WINDSONG LANE & VENUS COURT RAINBOW LAKE ESTATES CITY OF ROCKWALL					
SHEET NO. 5 15								JOB NO. 98111	