




CONST. 5' WIDE E-B CONC.  
POSITIVE OVERFLOW FLUME  
SEE FLUME DETAIL THIS SHEET

RAINBOW LAKE  
POOL ELEV. 499.00  
SPILLWAY CREST 508.50

**LEGEND**  
MINIMUM FINISHED  
FLOOR ELEV. 517.50  
DENOTES AREAS TO BE FILLED  
AS NEEDED BY PROPERTY OWNER  
AT TIME OF CONSTRUCTION TO  
ATTAIN MIN. F.F. ELEV. 517.50

*Revised Drawing*  
6-21-05

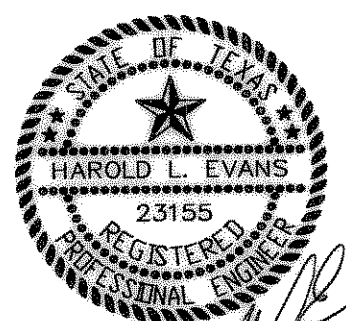

REV.	STREET NAMES	DATE	SCALE	DESIGN	DRAWN
1		4/6/00	1" = 40'	H.L.E.	
2					
3					
4					

**HAROLD L. EVANS**  
CONSULTING ENGINEER  
P.O. BOX 28855  
2331 GUS THOMASSON ROAD, SUITE 102  
DALLAS, TEXAS 75228, (214) 328-8133

**LOT GRADING PLAN**  
**RAINBOW LAKE ESTATES**  
**CITY OF ROCKWALL**

SHEET NO.	13
	15
JOB NO.	98111