

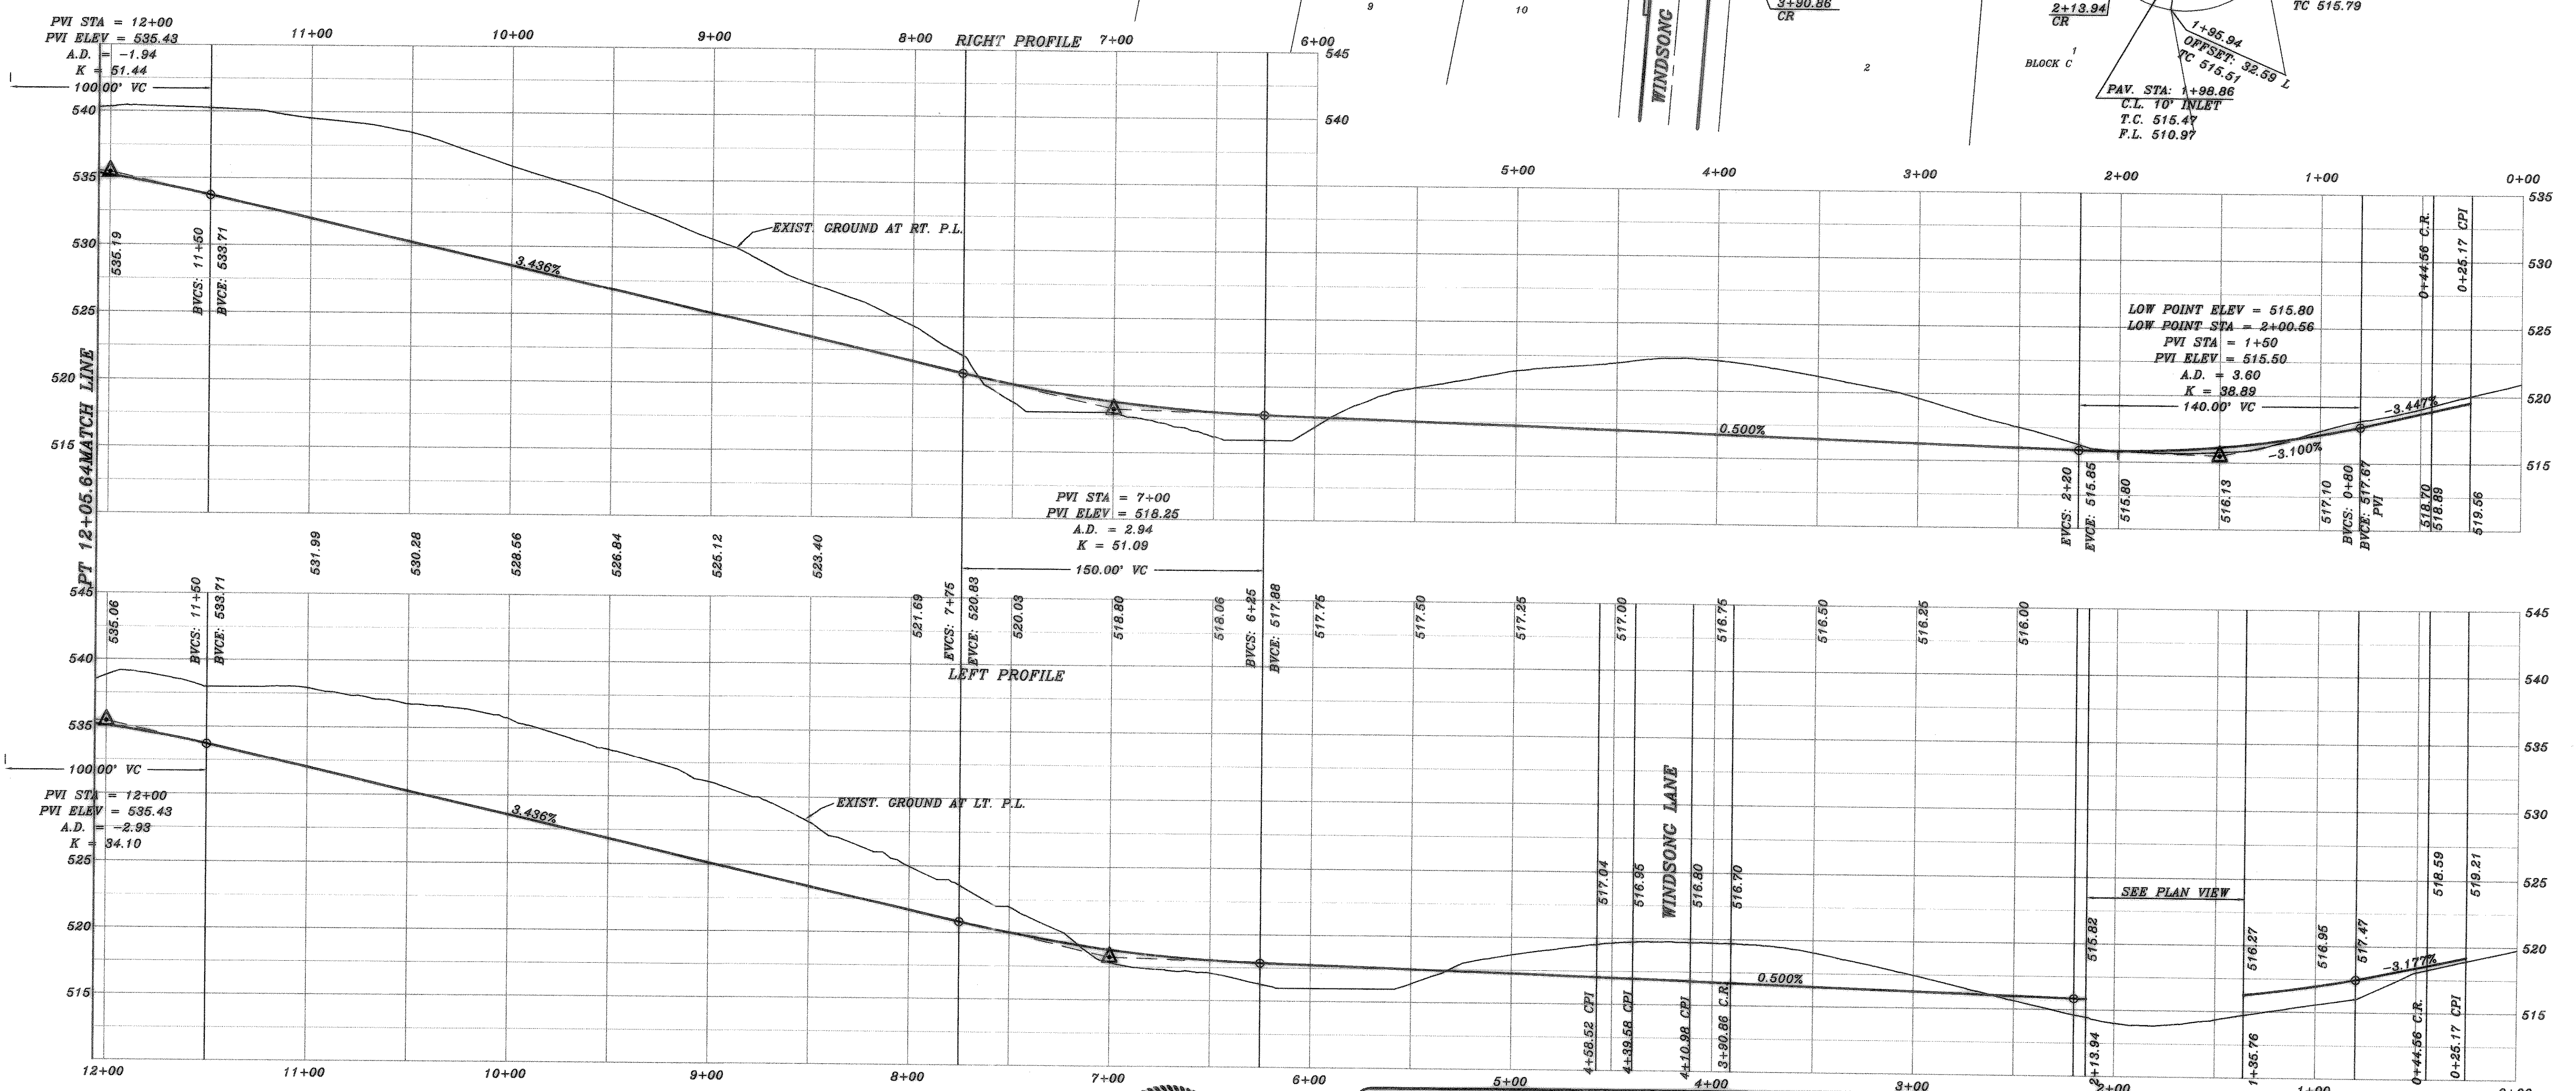


CURVE	RADIUS	LENGTH	TANGENT	DELTA
C1	45.00'	72.37'	47.34'	92°54'14"
C2	933.25'	267.17'	134.50'	16°24'09"
C3	772.50'	84.40'	47.26'	07°00'00"
C4	427.50'	287.95'	155.31'	39°55'58"
C5	20.00'	14.52'	7.60'	41°35'29"
C6	39.50'	120.66'	907.31'	175°00'52"
C7	20.00'	14.11'	7.36'	40°24'30"

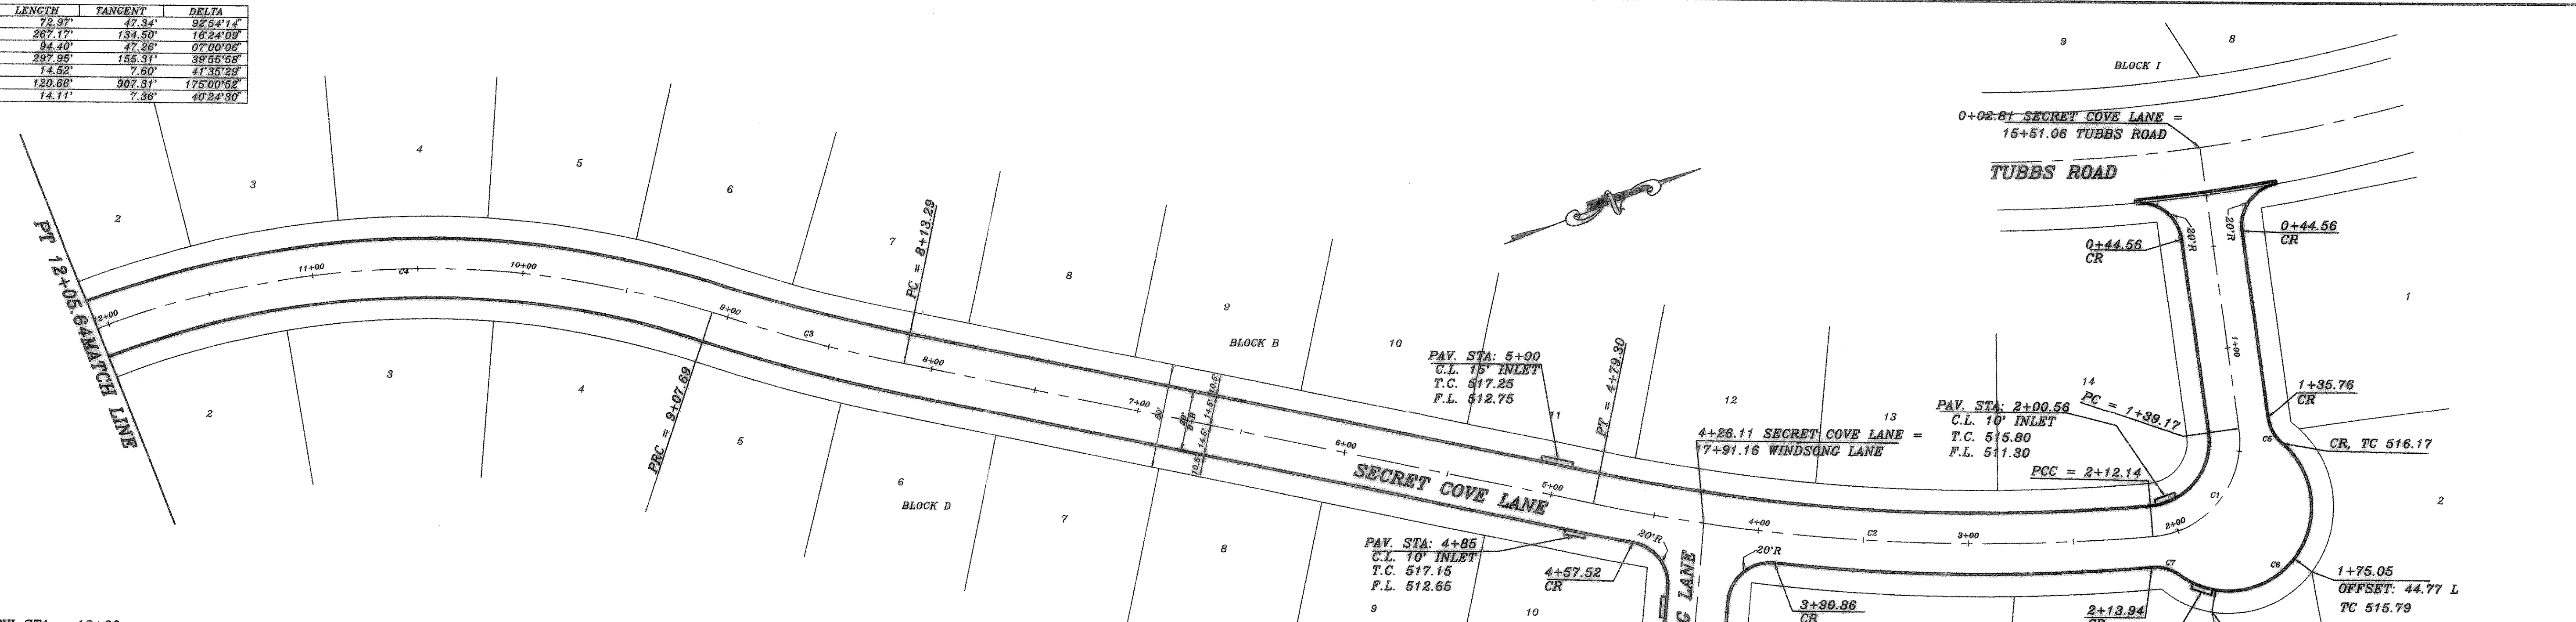

*As Built*  
6-21-05

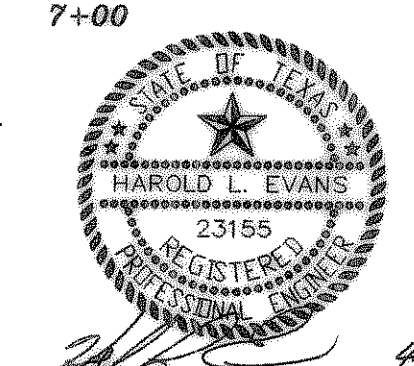

REVISION DESCRIPTION	DATE	SCALE	DESIGN	DRAWN
38111PVI		1" = 40' 1" = 6'	H.L.E.	

**HAROLD L. EVANS**  
CONSULTING ENGINEER  
P.O. BOX 28355  
2331 CUS THOMASSON ROAD, SUITE 102  
DALLAS, TEXAS 75228, (214) 328-8133

**PROPOSED PAVING**  
**SECRET COVE LANE**  
**RAINBOW LAKE ESTATES**  
**CITY OF ROCKWALL**

SHEET NO.  
3  
15  
JOB NO.  
98111