

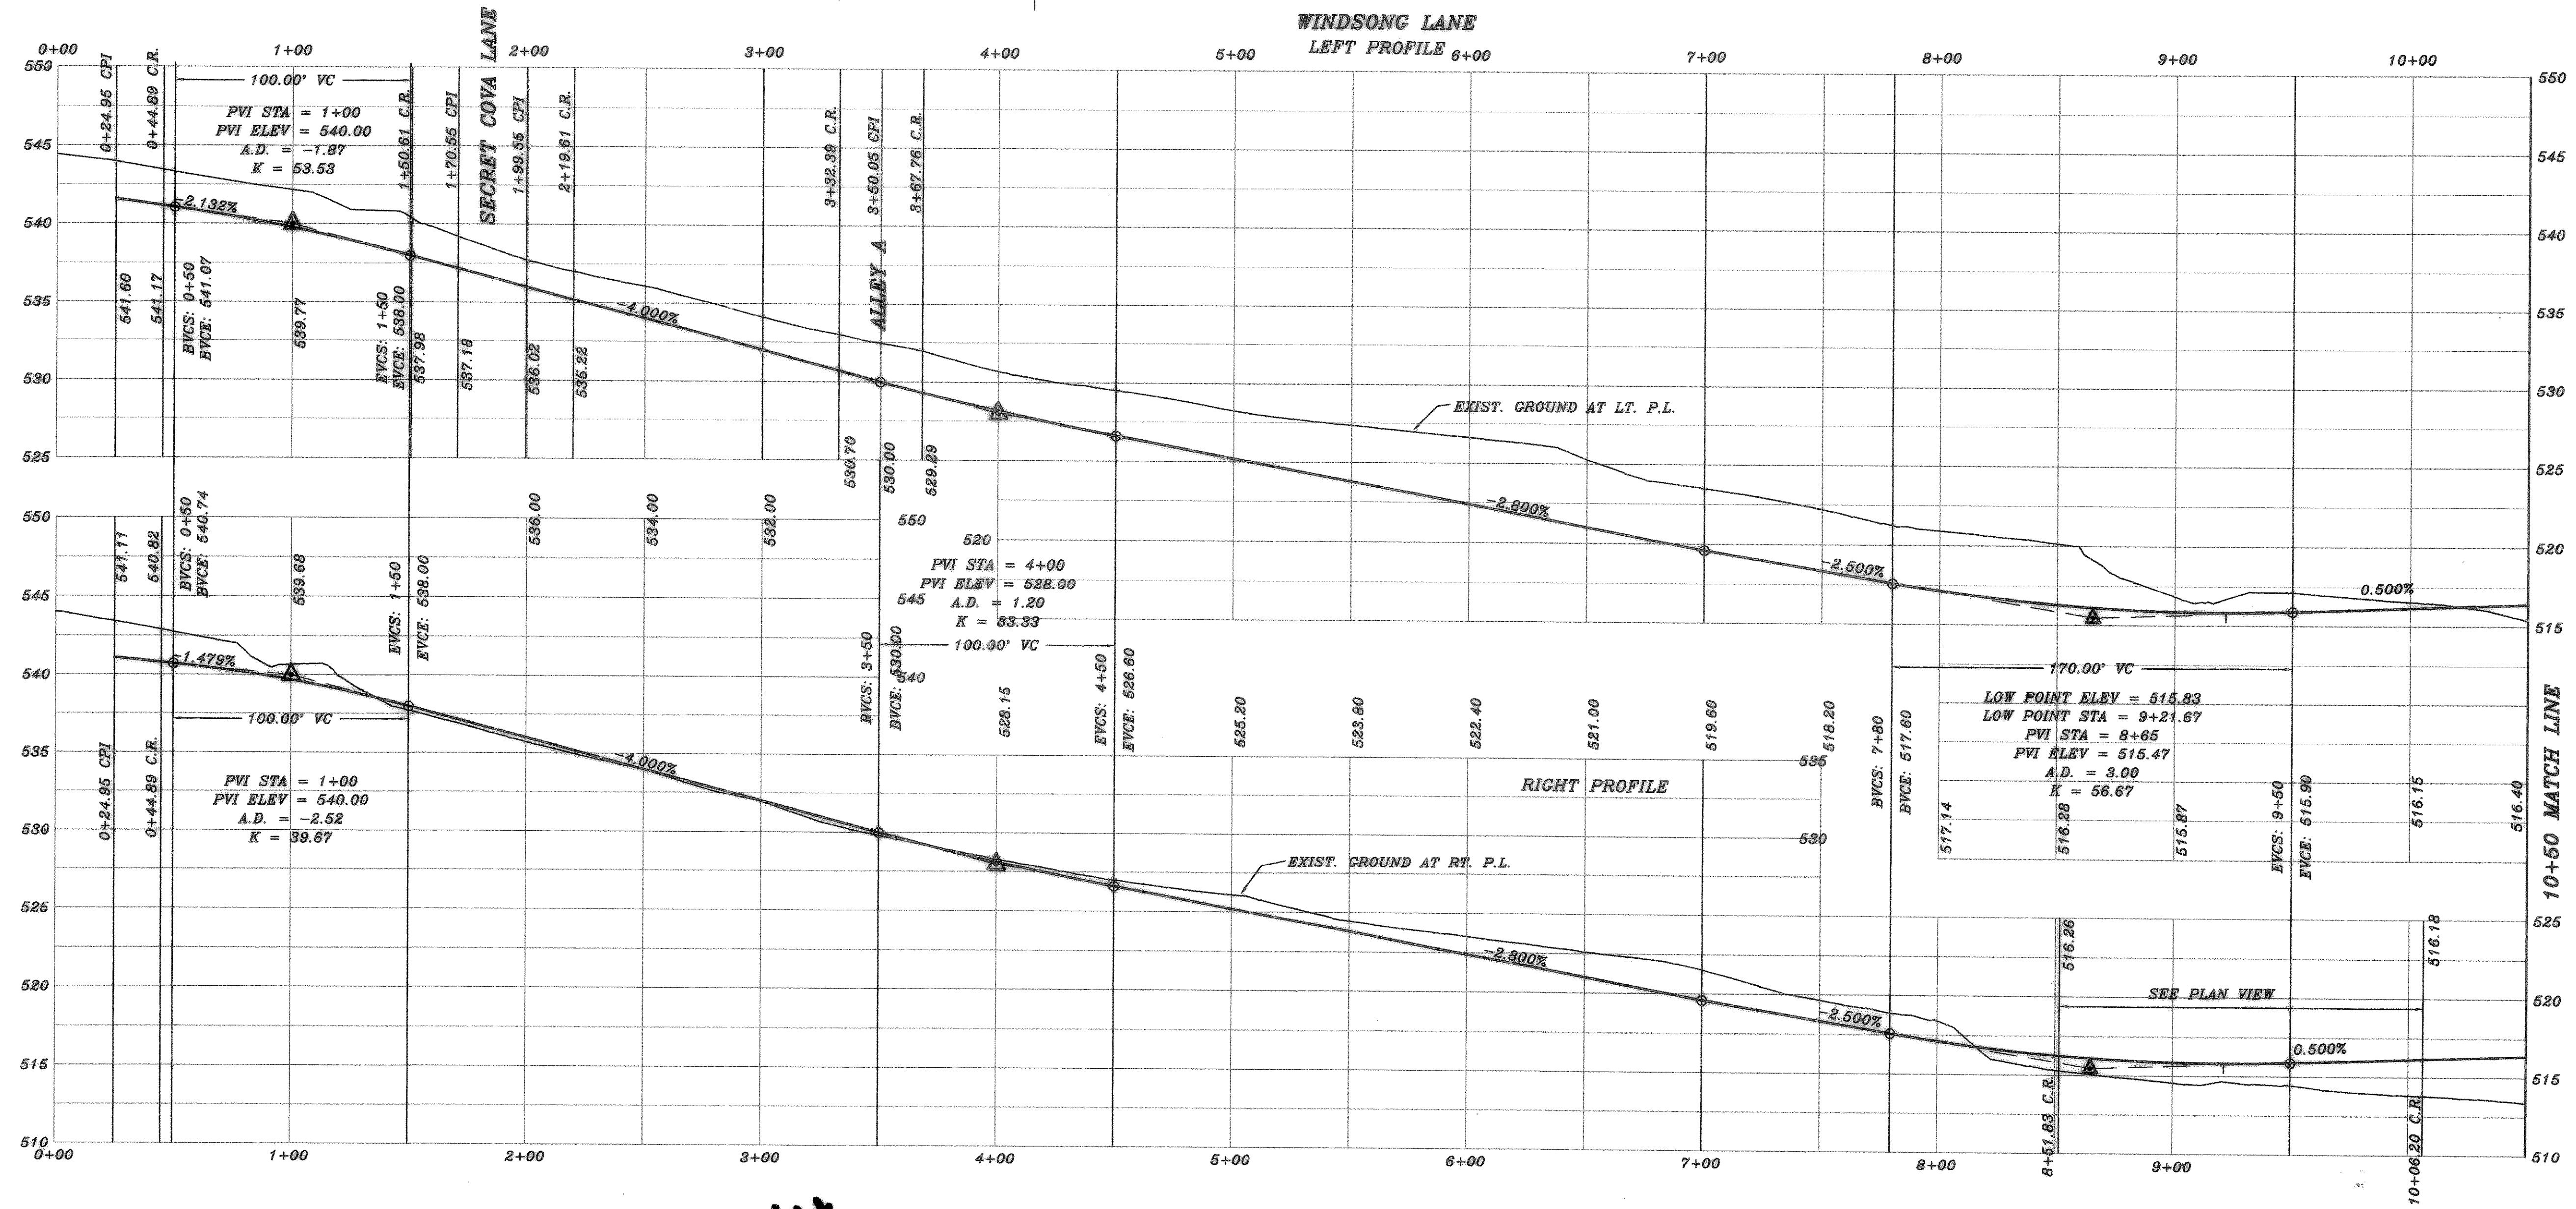
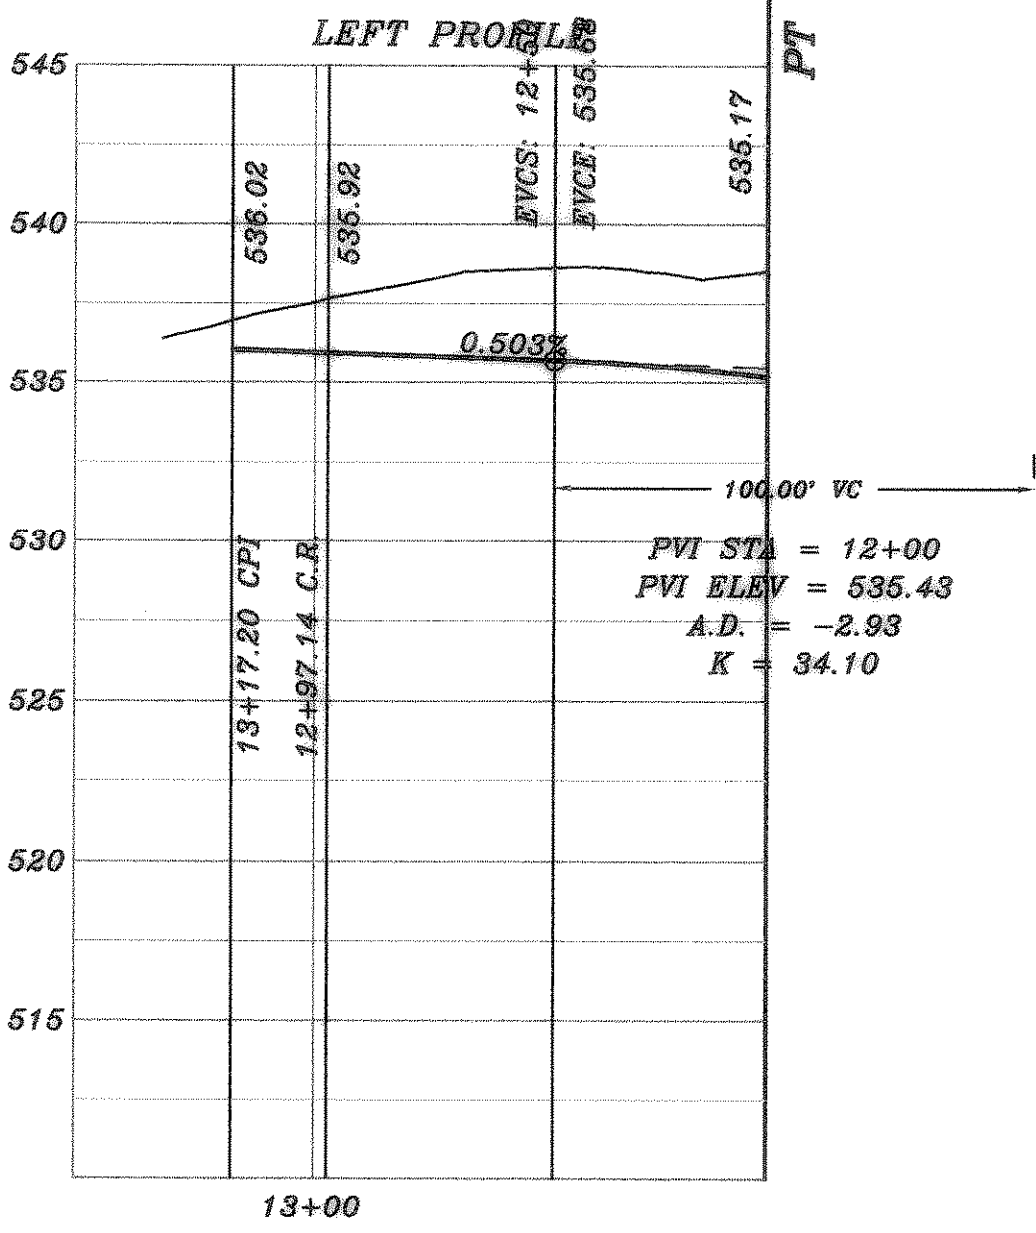
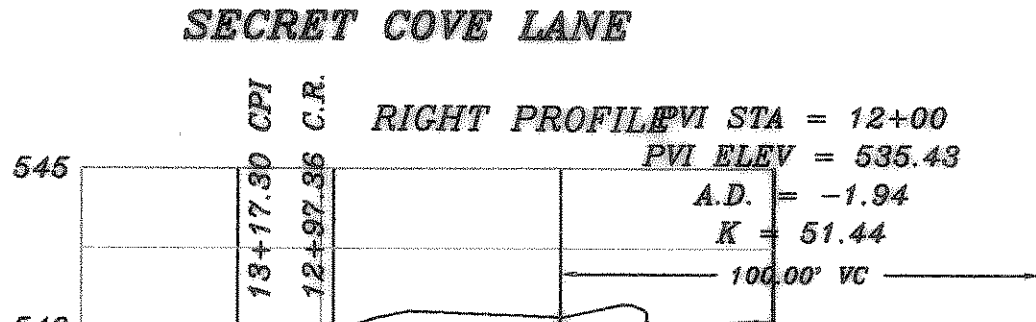


CURVE	RADIUS	LENGTH	TANGENT	DELTA
C1	527.00'	164.18'	82.82'	160°25'
C2	210.00'	330.02'	210.15'	90°02'28"
C3	20.00'	4.32'	2.17'	1°21'53"
C4	138.50'	162.76'	82.07'	86°50'53"
C5	20.00'	4.32'	2.17'	1°21'53"

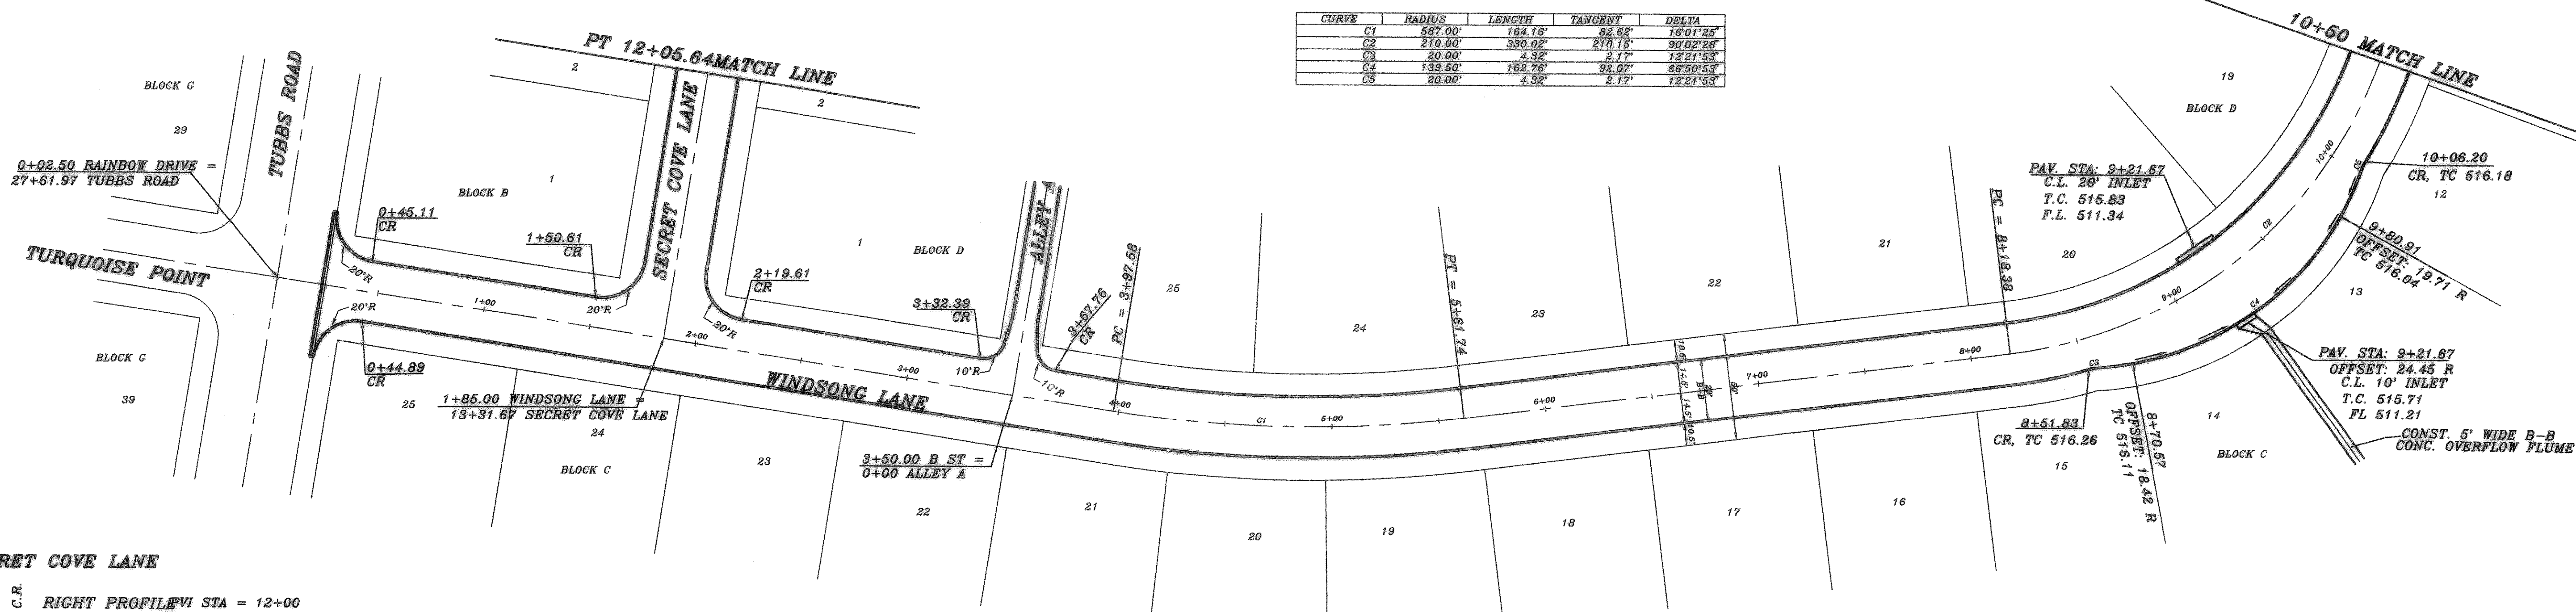

A. Built
6-21-05

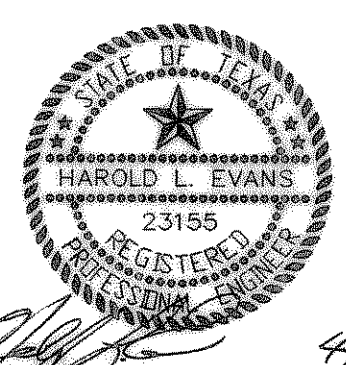

HAROLD L. EVANS CONSULTING ENGINEER 2381 GUS THOMAS ROAD, SUITE 102 P.O. BOX 28855 DALLAS, TEXAS 75228 (214) 328-8133		SHEET NO. 4 15
REV. STREET NAME 4/8/00	REV. PER CITY REVIEW 11/3/99	JOB NO. 98111
REVISION DESCRIPTION	DATE SCALE 1" = 40' 1" = 6'	DESIGN H.L.E.

PROPOSED PAVING
SECRET COVE LANE & WINDSONG LANE
RAINBOW LAKE ESTATES
CITY OF ROCKWALL