

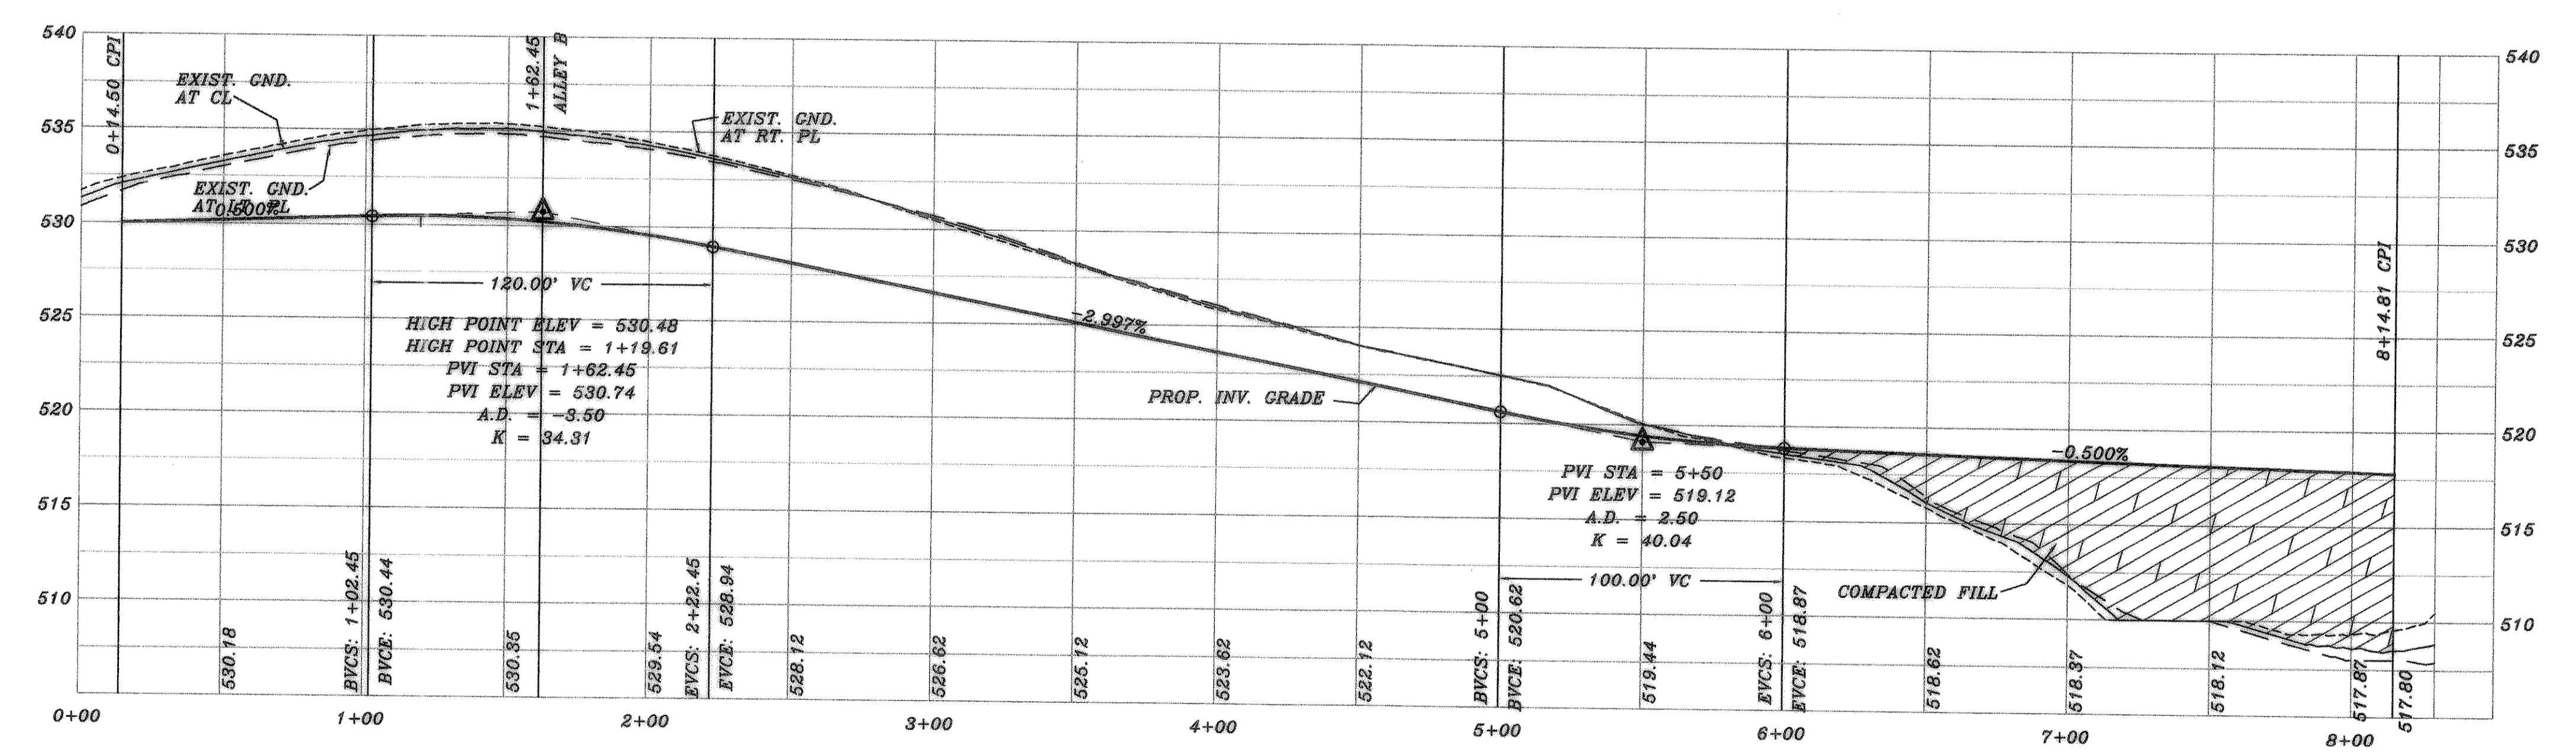


CURVE	RADIUS	LENGTH	TANGENT	DELTA
C1	262.50'	182.95'	95.37'	39°55'58"
C2	937.50'	114.57'	57.35'	07°00'00"
C3	1098.25'	72.26'	36.14'	03°46'11"
C4	44.00'	68.72'	43.60'	89°28'53"
C5	44.00'	69.66'	71.82'	117°00'46"
C6	44.00'	64.03'	39.19'	83°23'05"
C7	44.00'	74.20'	49.40'	96°38'55"

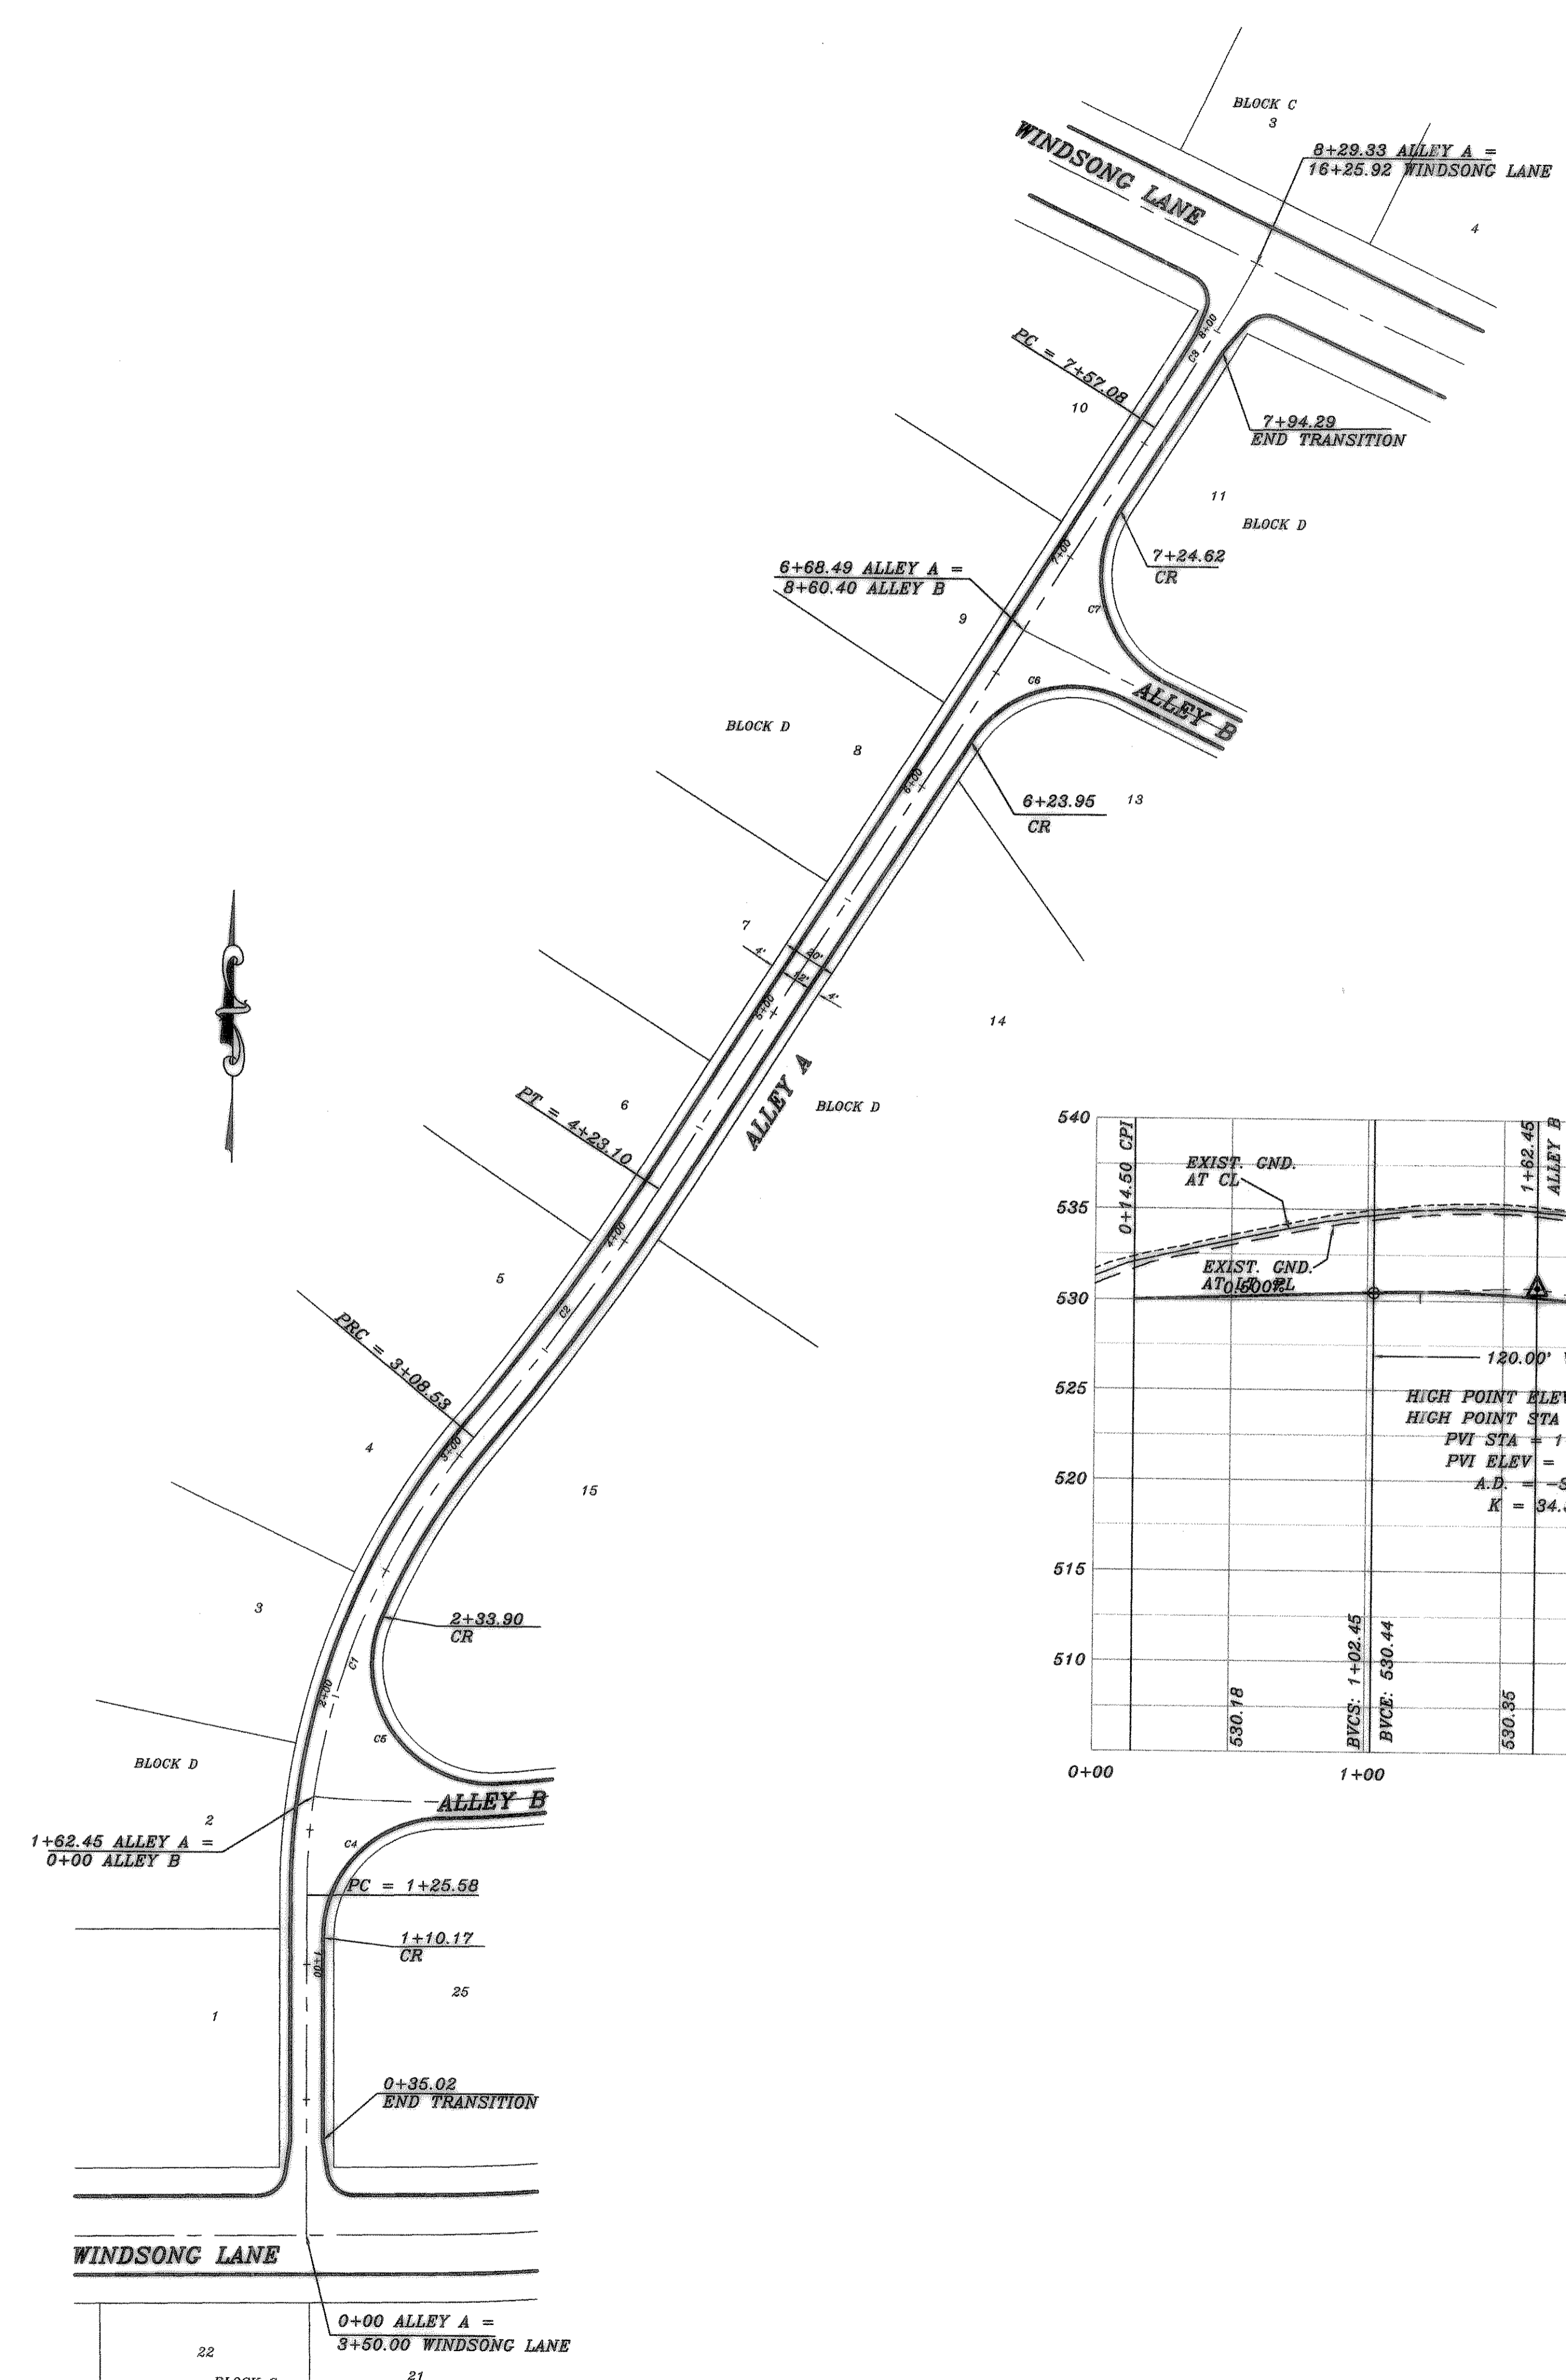

As Built
6-21-05

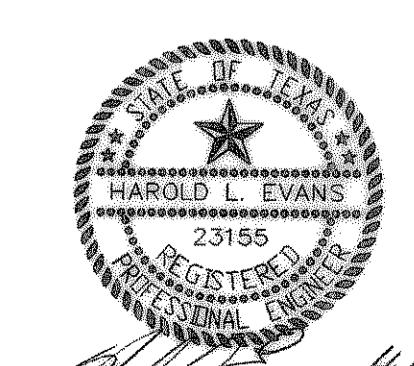

HAROLD L. EVANS CONSULTING ENGINEER P.O. BOX 28355 2331 GUS THOMASSON ROAD, SUITE 102 DALLAS, TEXAS 75228, (214) 328-8133		PROPOSED PAVING ALLEY A RAINBOW LAKE ESTATES CITY OF ROCKWALL		SHEET NO. 6 15	
REV. STREET NAME 4/6/00	DATE 4/6/00	SCALE 1" = 40' 1" = 8'	DESIGN H.L.E.	DRAWN	JOB NO. 98111
REVISION DESCRIPTION		DATE		SCALE	