



CURVE	RADIUS	LENGTH	TANGENT	DELTA
C1	427.00'	163.97'	83.01'	22°00'06"
C2	50.00'	76.56'	30.04'	30°02'38"
C3	50.00'	41.38'	21.97'	47°26'03"
C4	44.00'	66.72'	43.60'	89°28'53"
C5	44.00'	39.86'	71.82'	117°00'46"
C6	44.00'	64.03'	33.19'	65°23'05"
C7	44.00'	74.20'	49.40'	96°36'55"

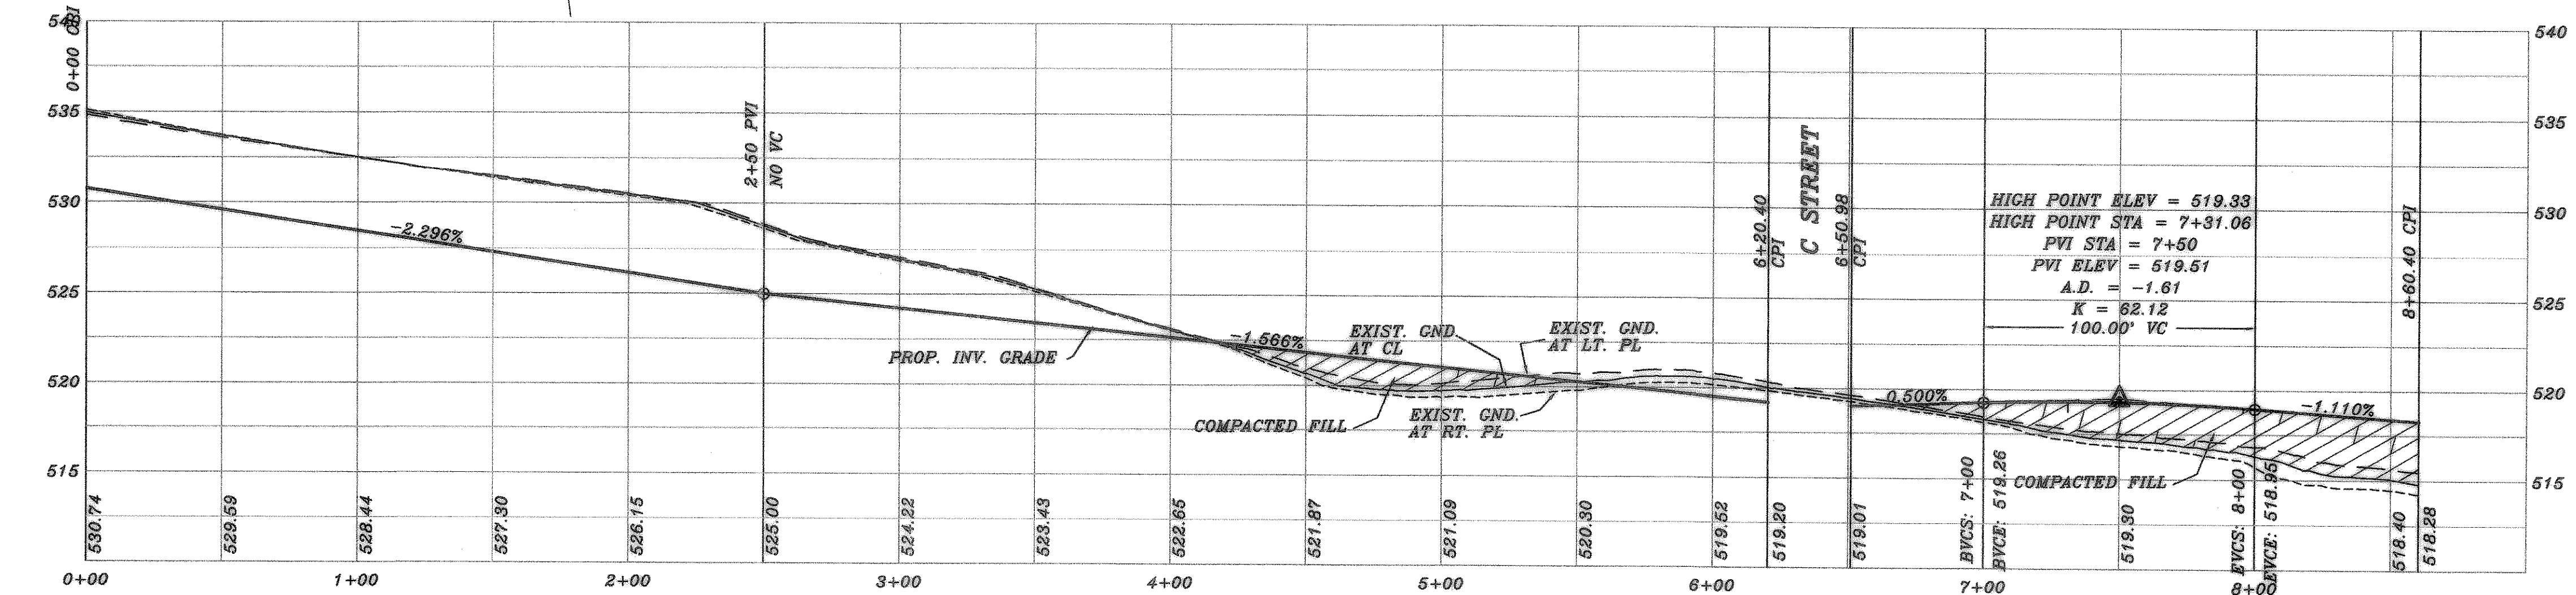

As Built
6-21-05

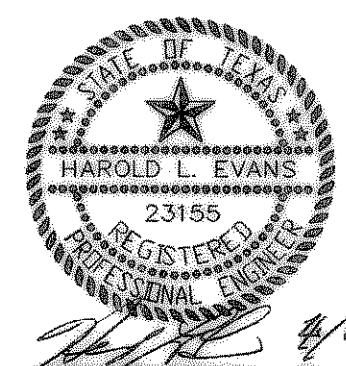

REV. STREET NAME	4/6/00
REVISION DESCRIPTION	

HAROLD L. EVANS
CONSULTING ENGINEER
P.O. BOX 28355
DALLAS, TEXAS 75228, (214) 328-8133

DATE: 4/6/00
SCALE: 1" = 40'
1" = 8'

DESIGN: H.L.E.
DRAWN:

PROPOSED PAVING
ALLEY B
RAINBOW LAKE ESTATES
CITY OF ROCKWALL

SHEET NO.	7
	15
JOB NO.	98111