
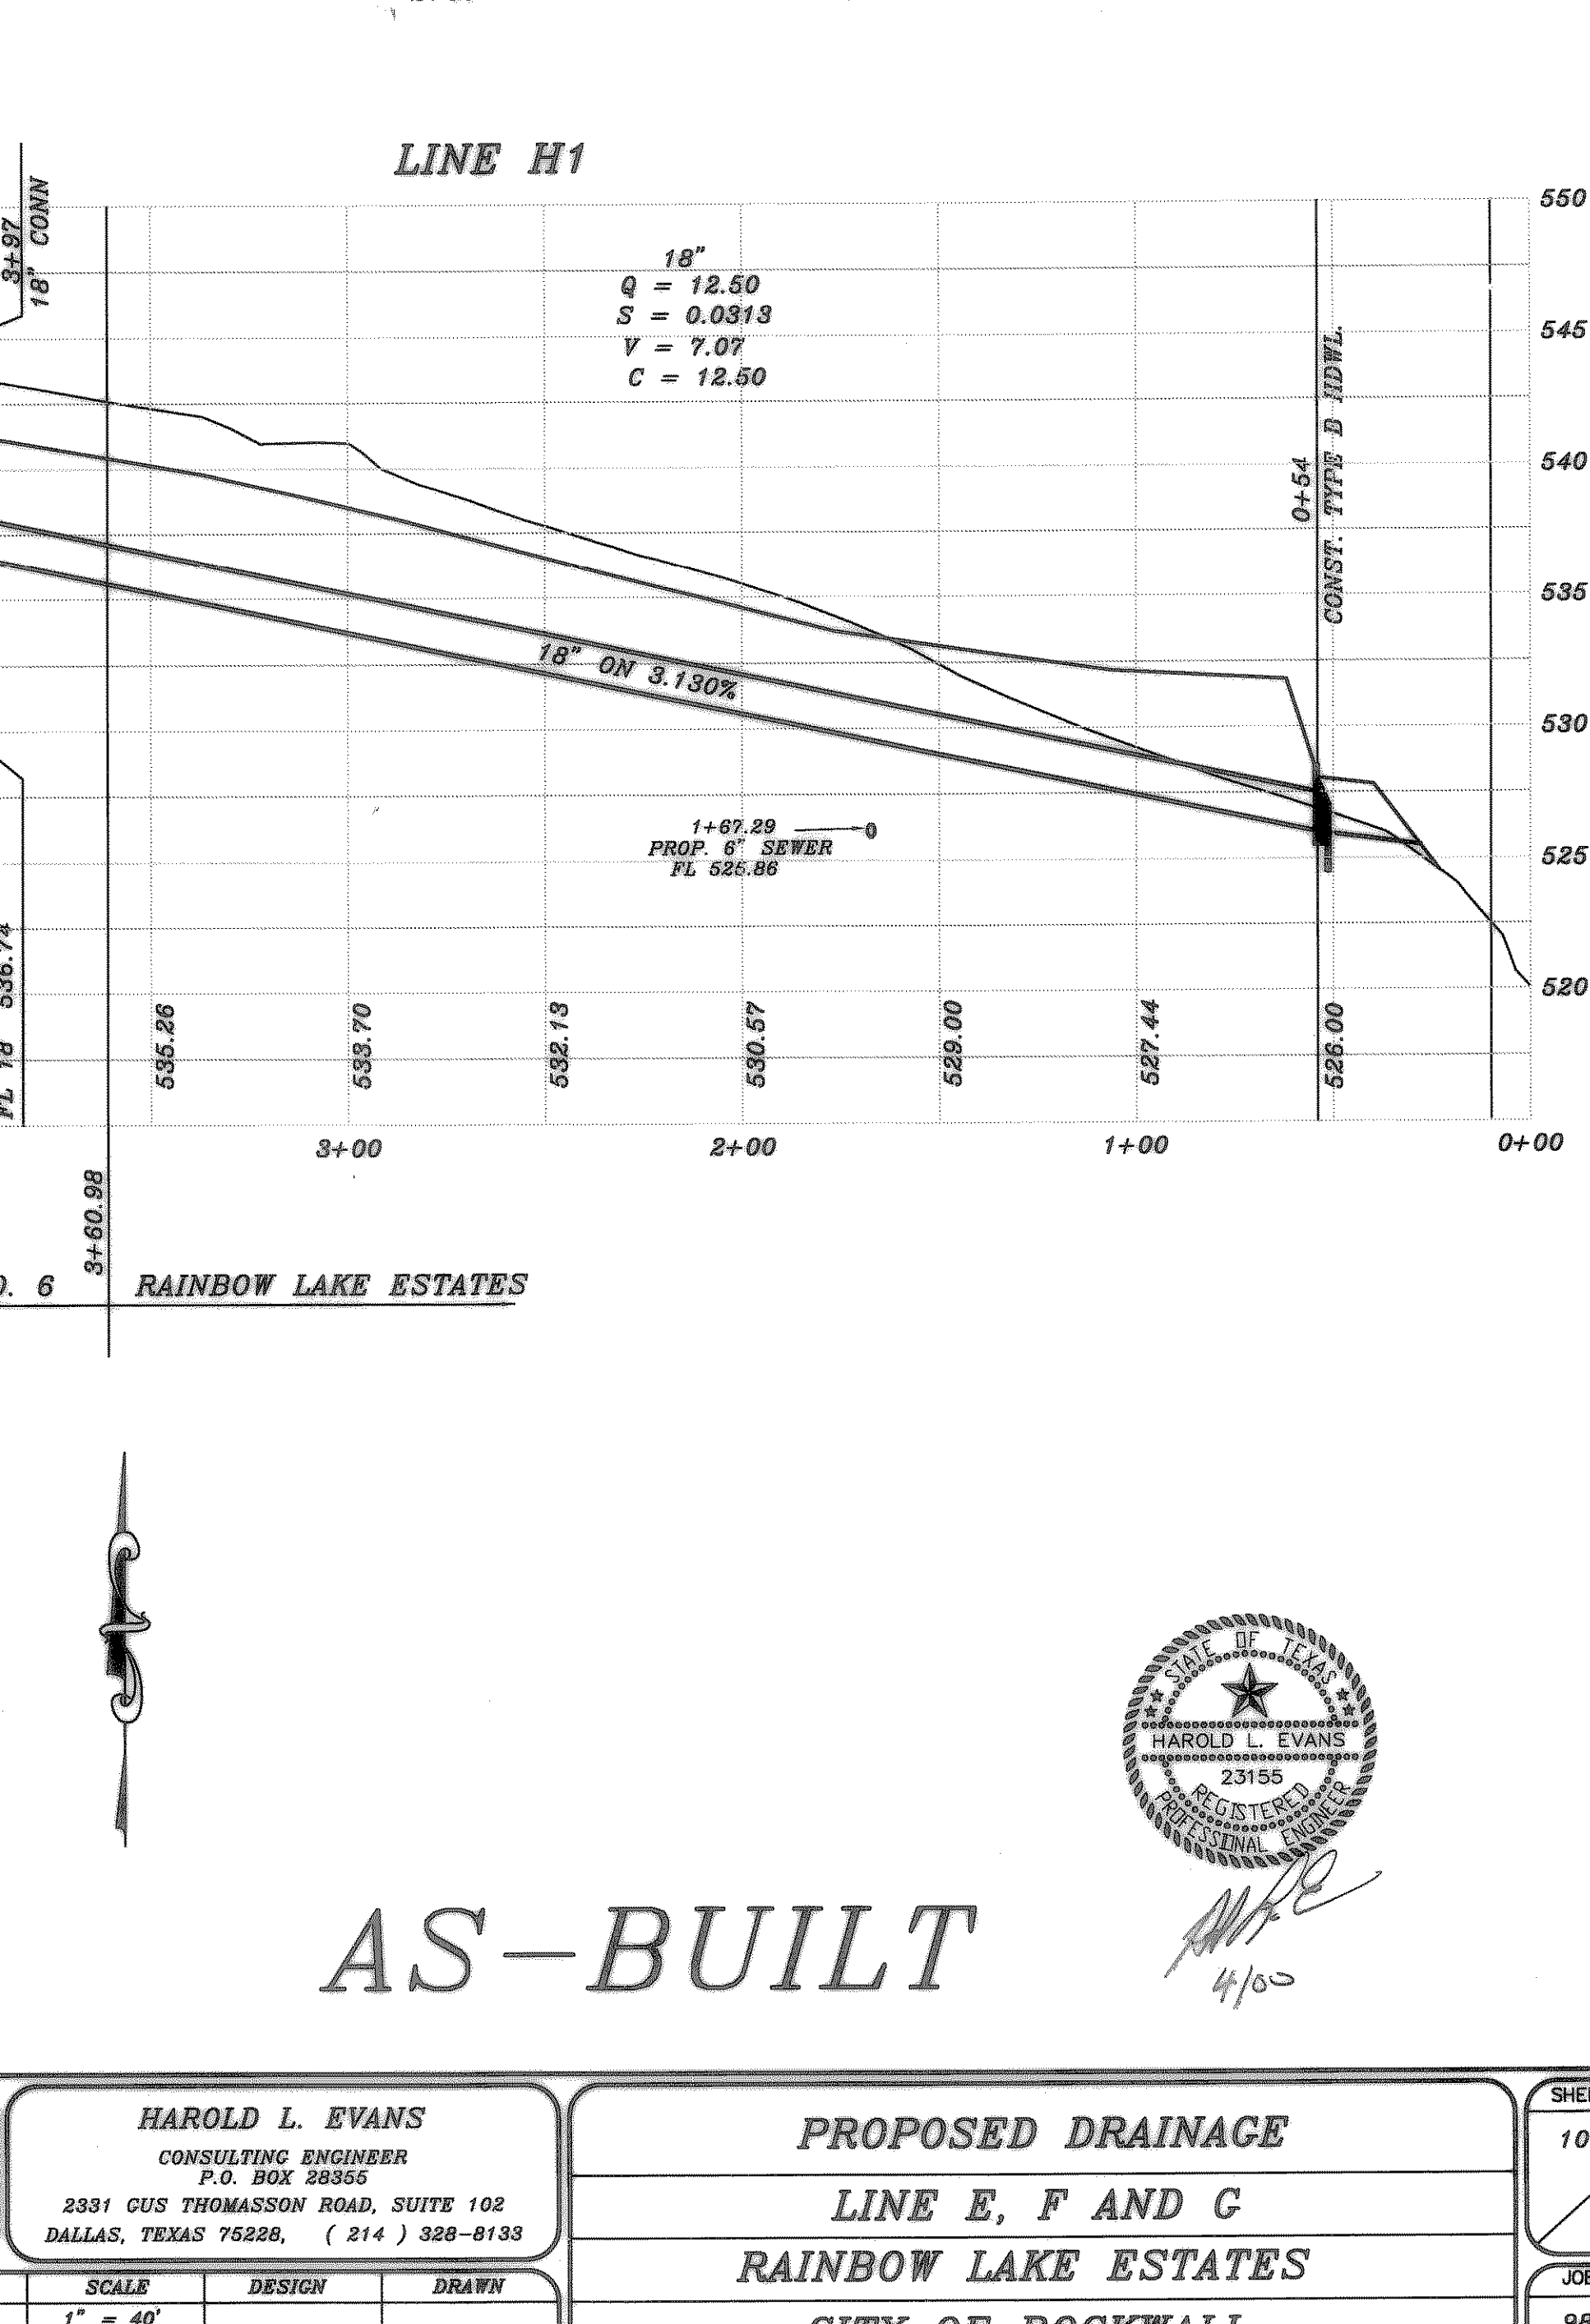
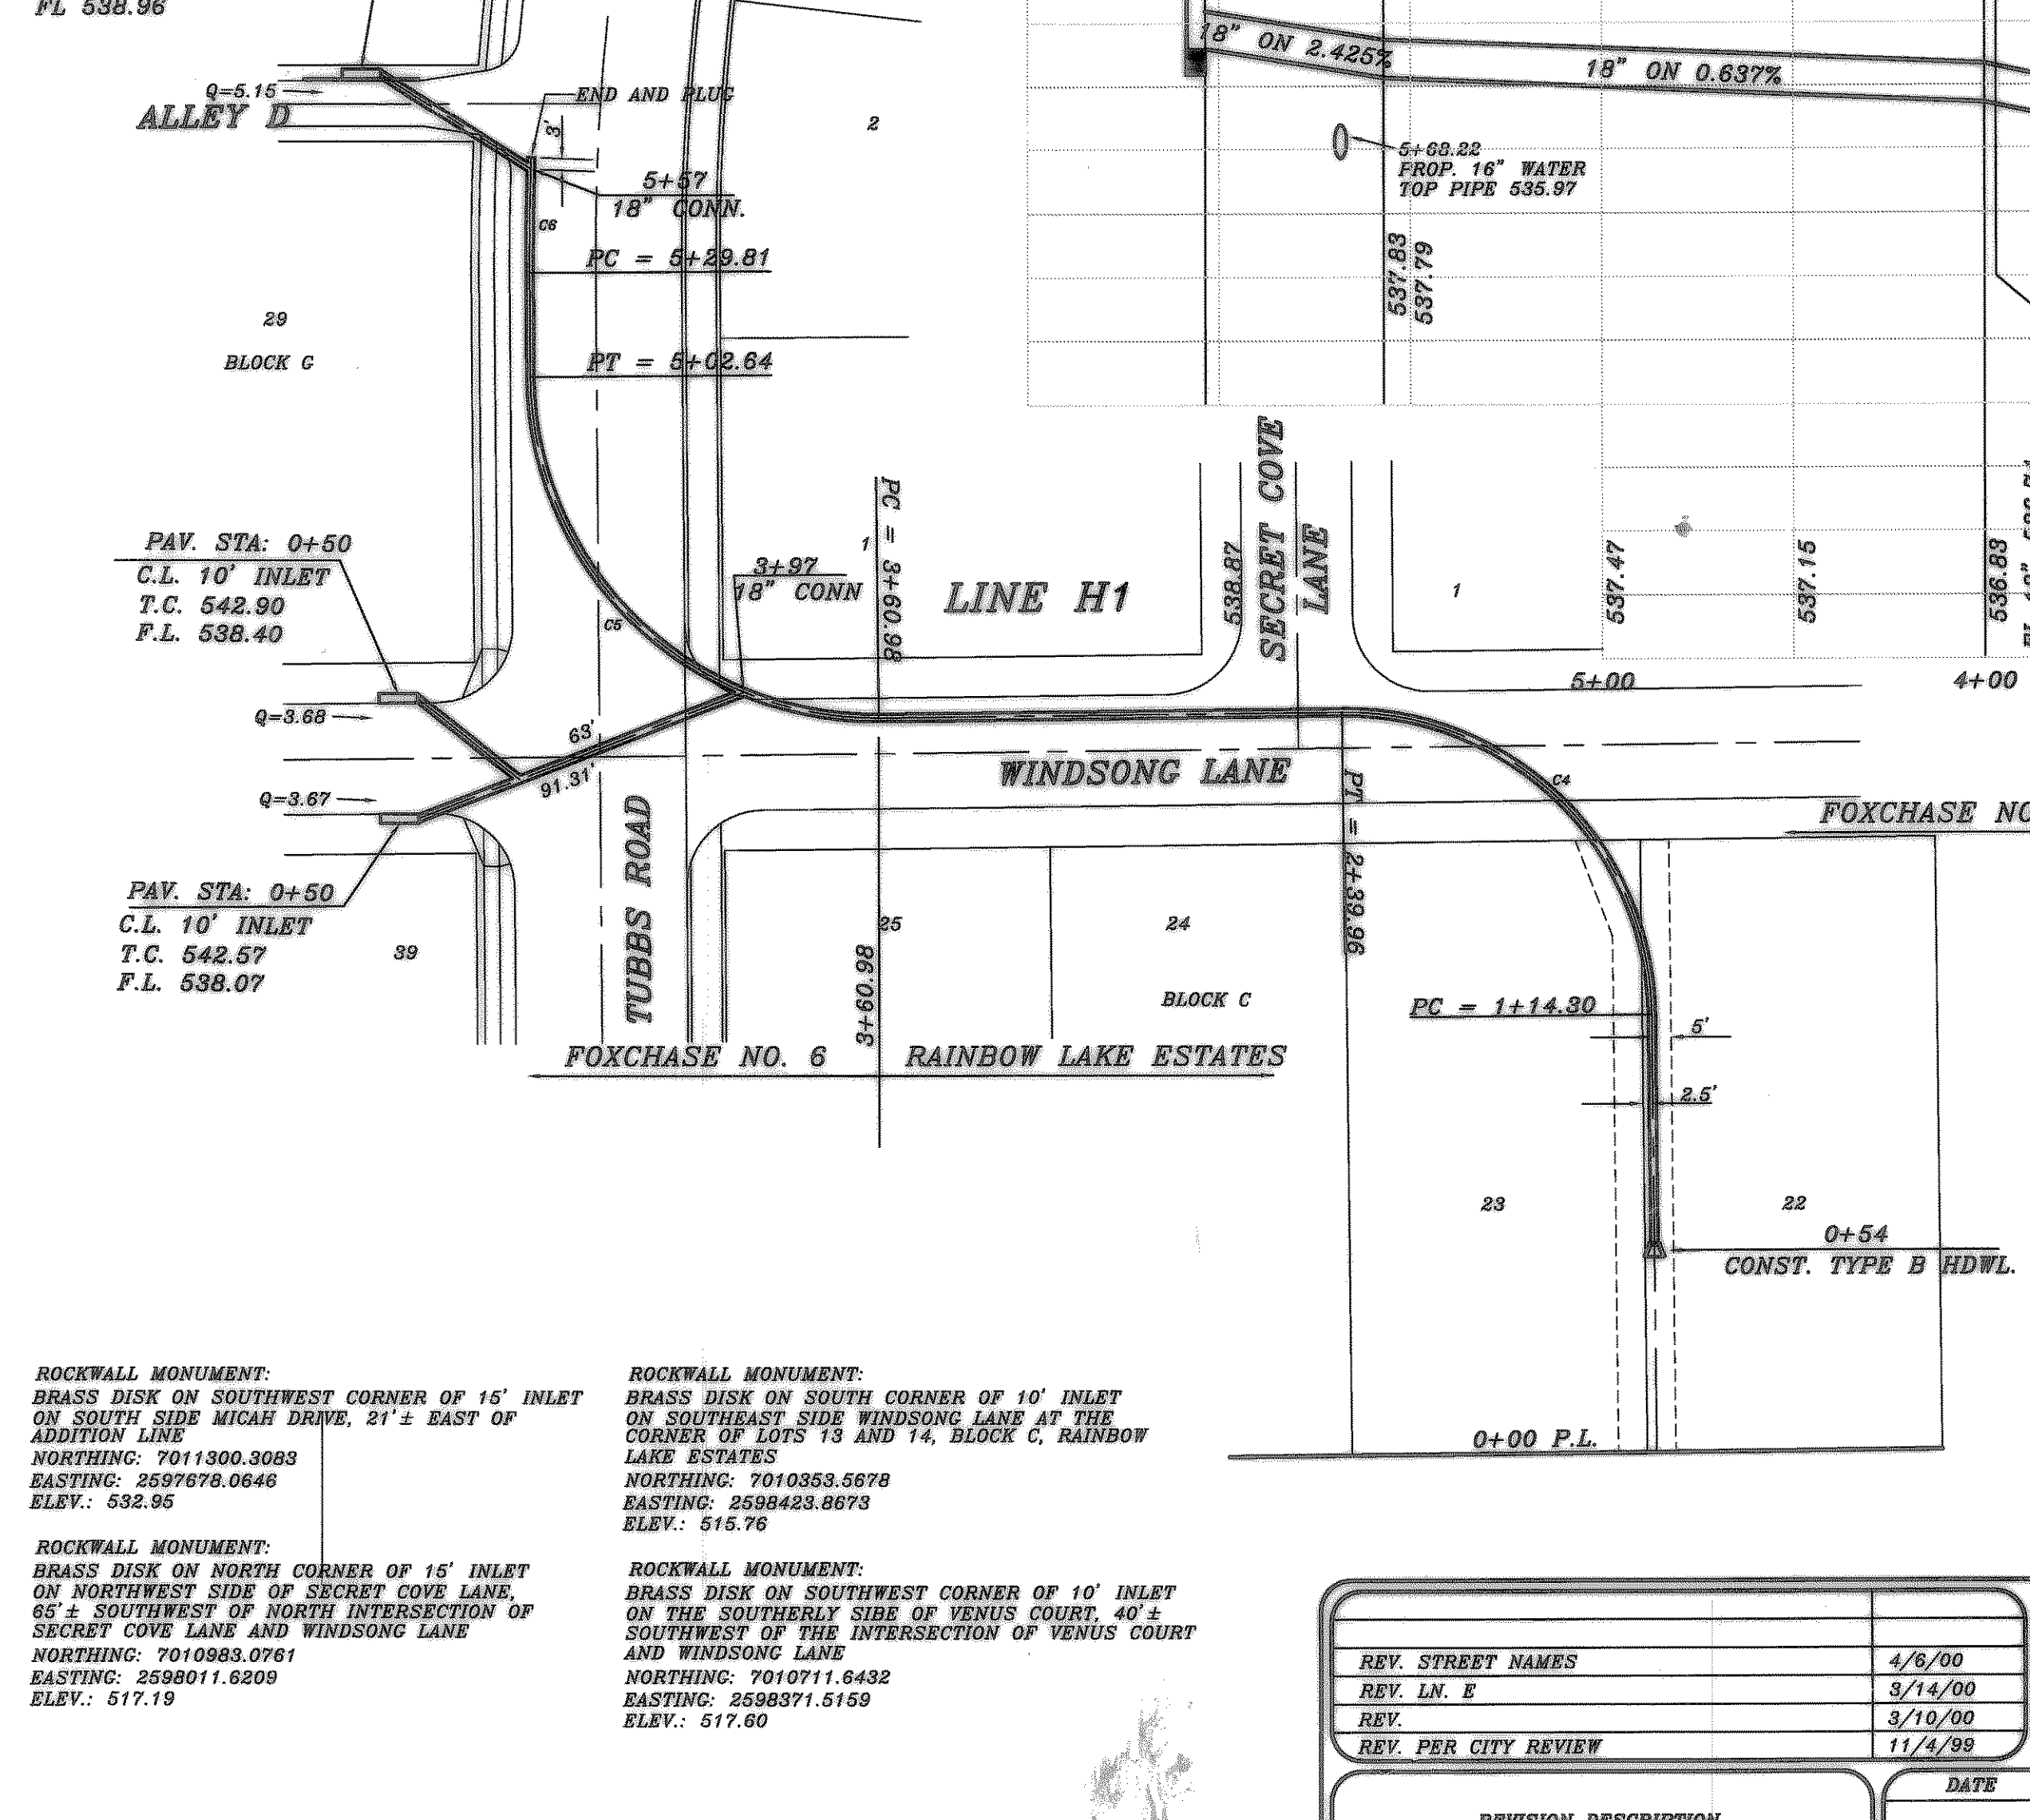
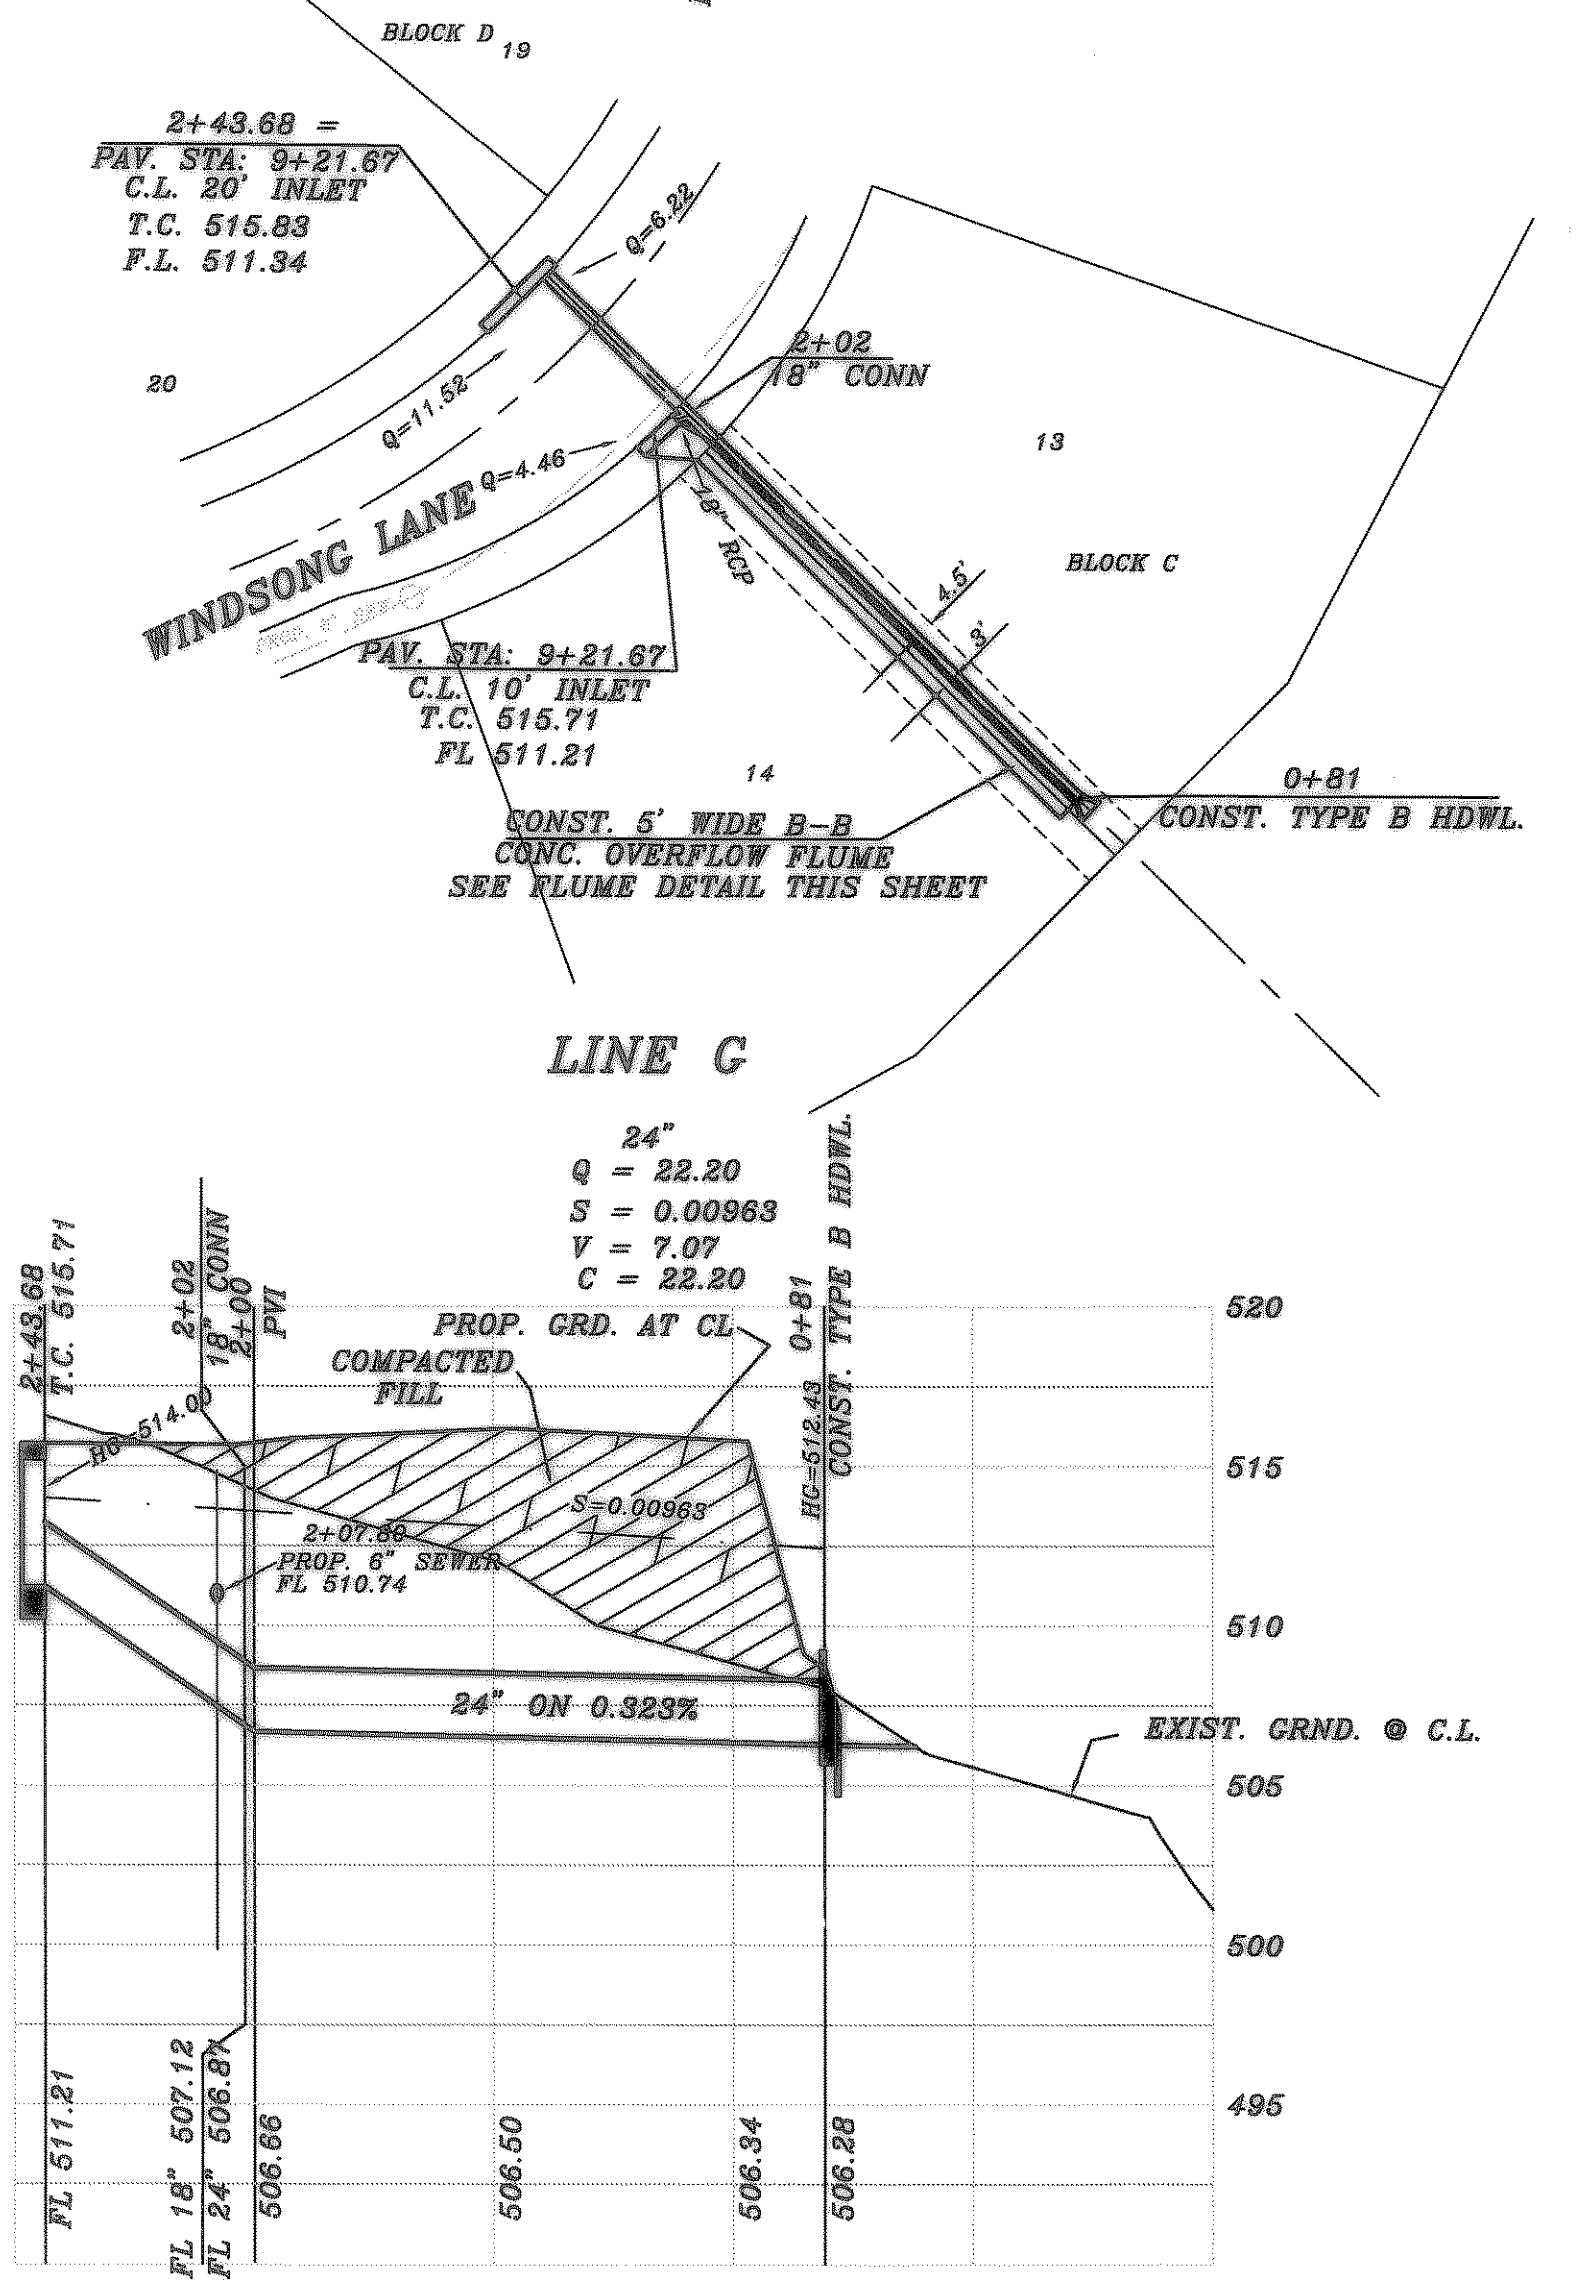
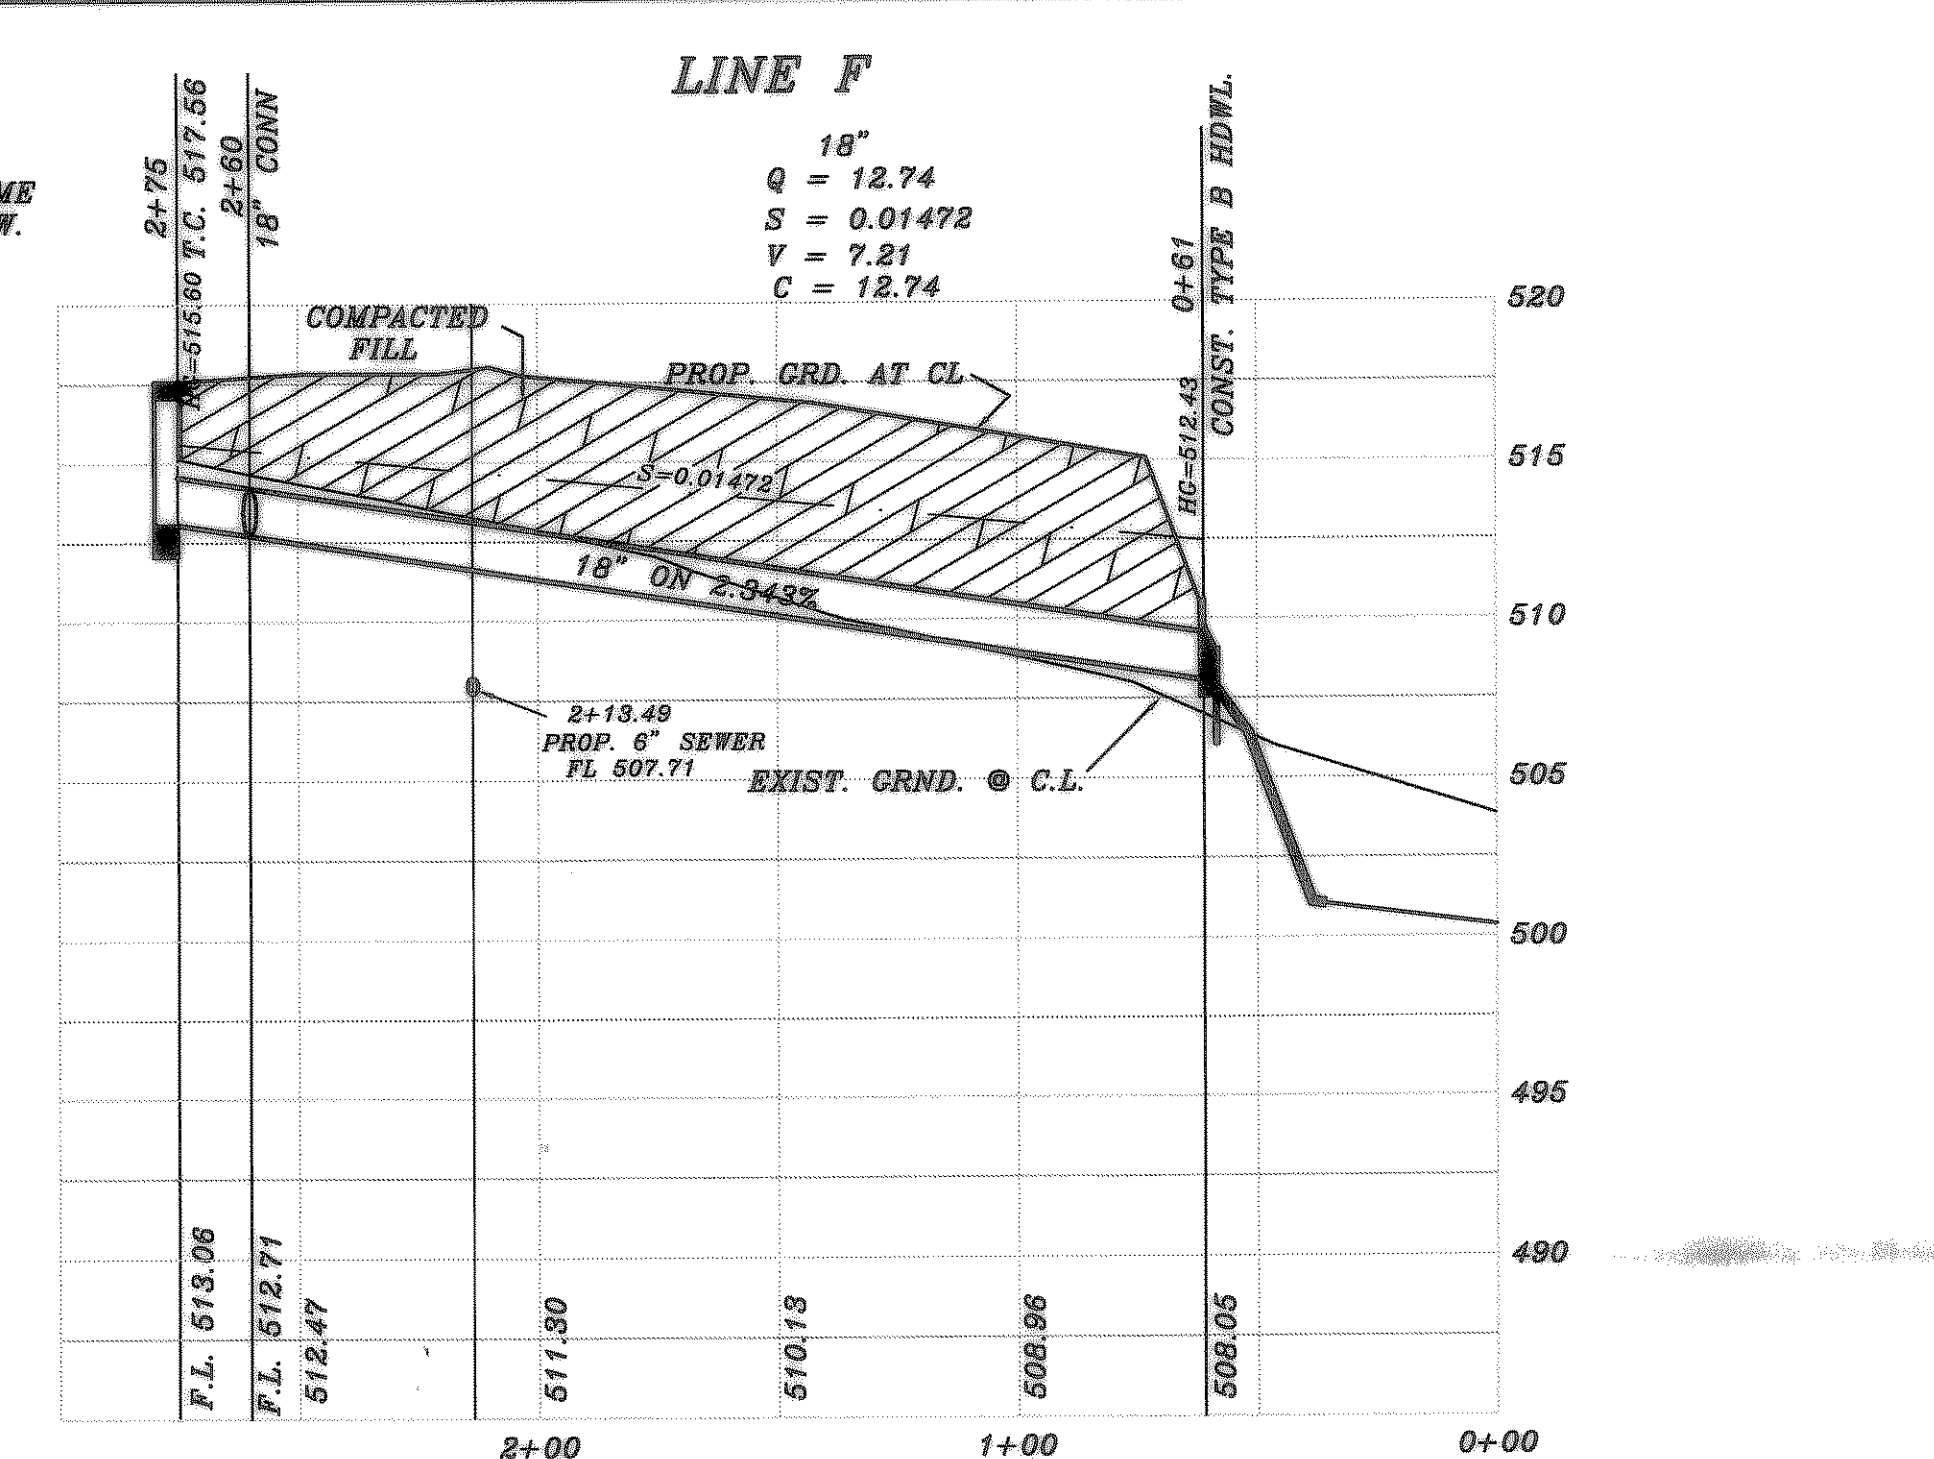
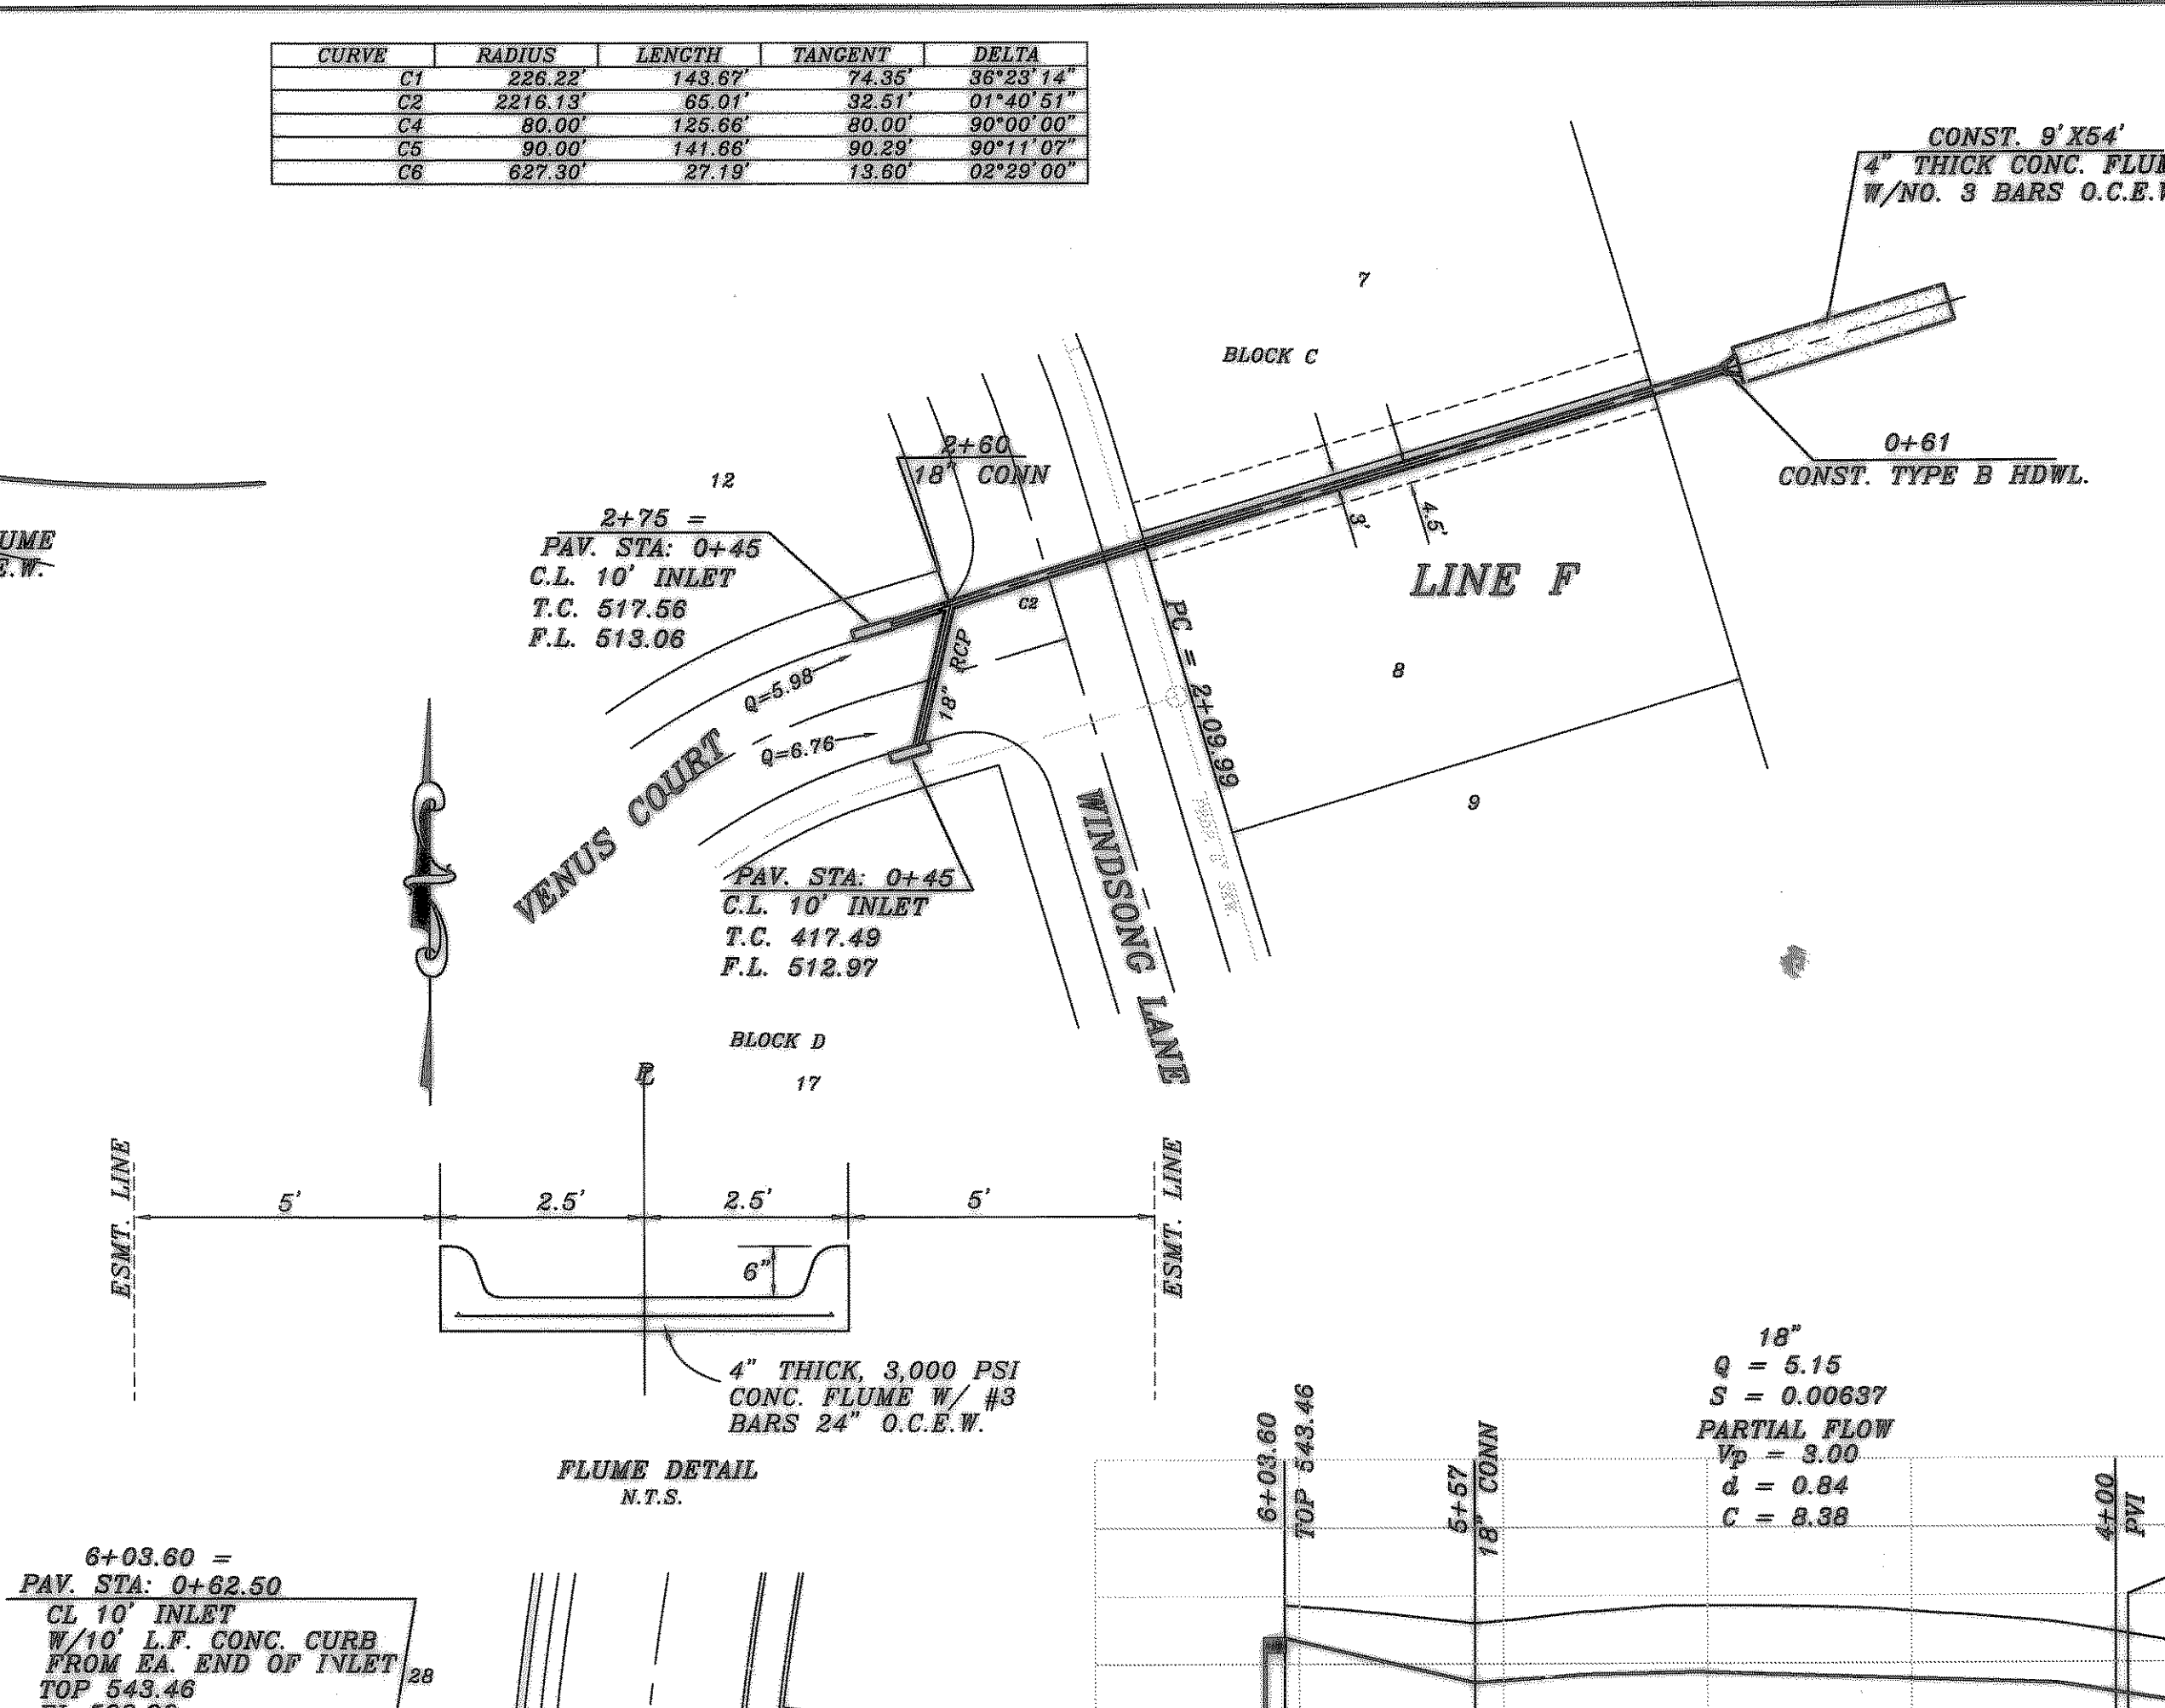


CURVE	RADIUS	LENGTH	TANGENT	DELTA
C1	228.22'	143.67'	74.35'	35°23'14"
C2	2216.13'	65.01'	32.51'	01°40'51"
C4	80.00'	125.66'	80.00'	90°00'00"
C5	90.00'	141.68'	90.29'	90°11'07"
C6	627.30'	27.19'	13.60'	02°29'00"

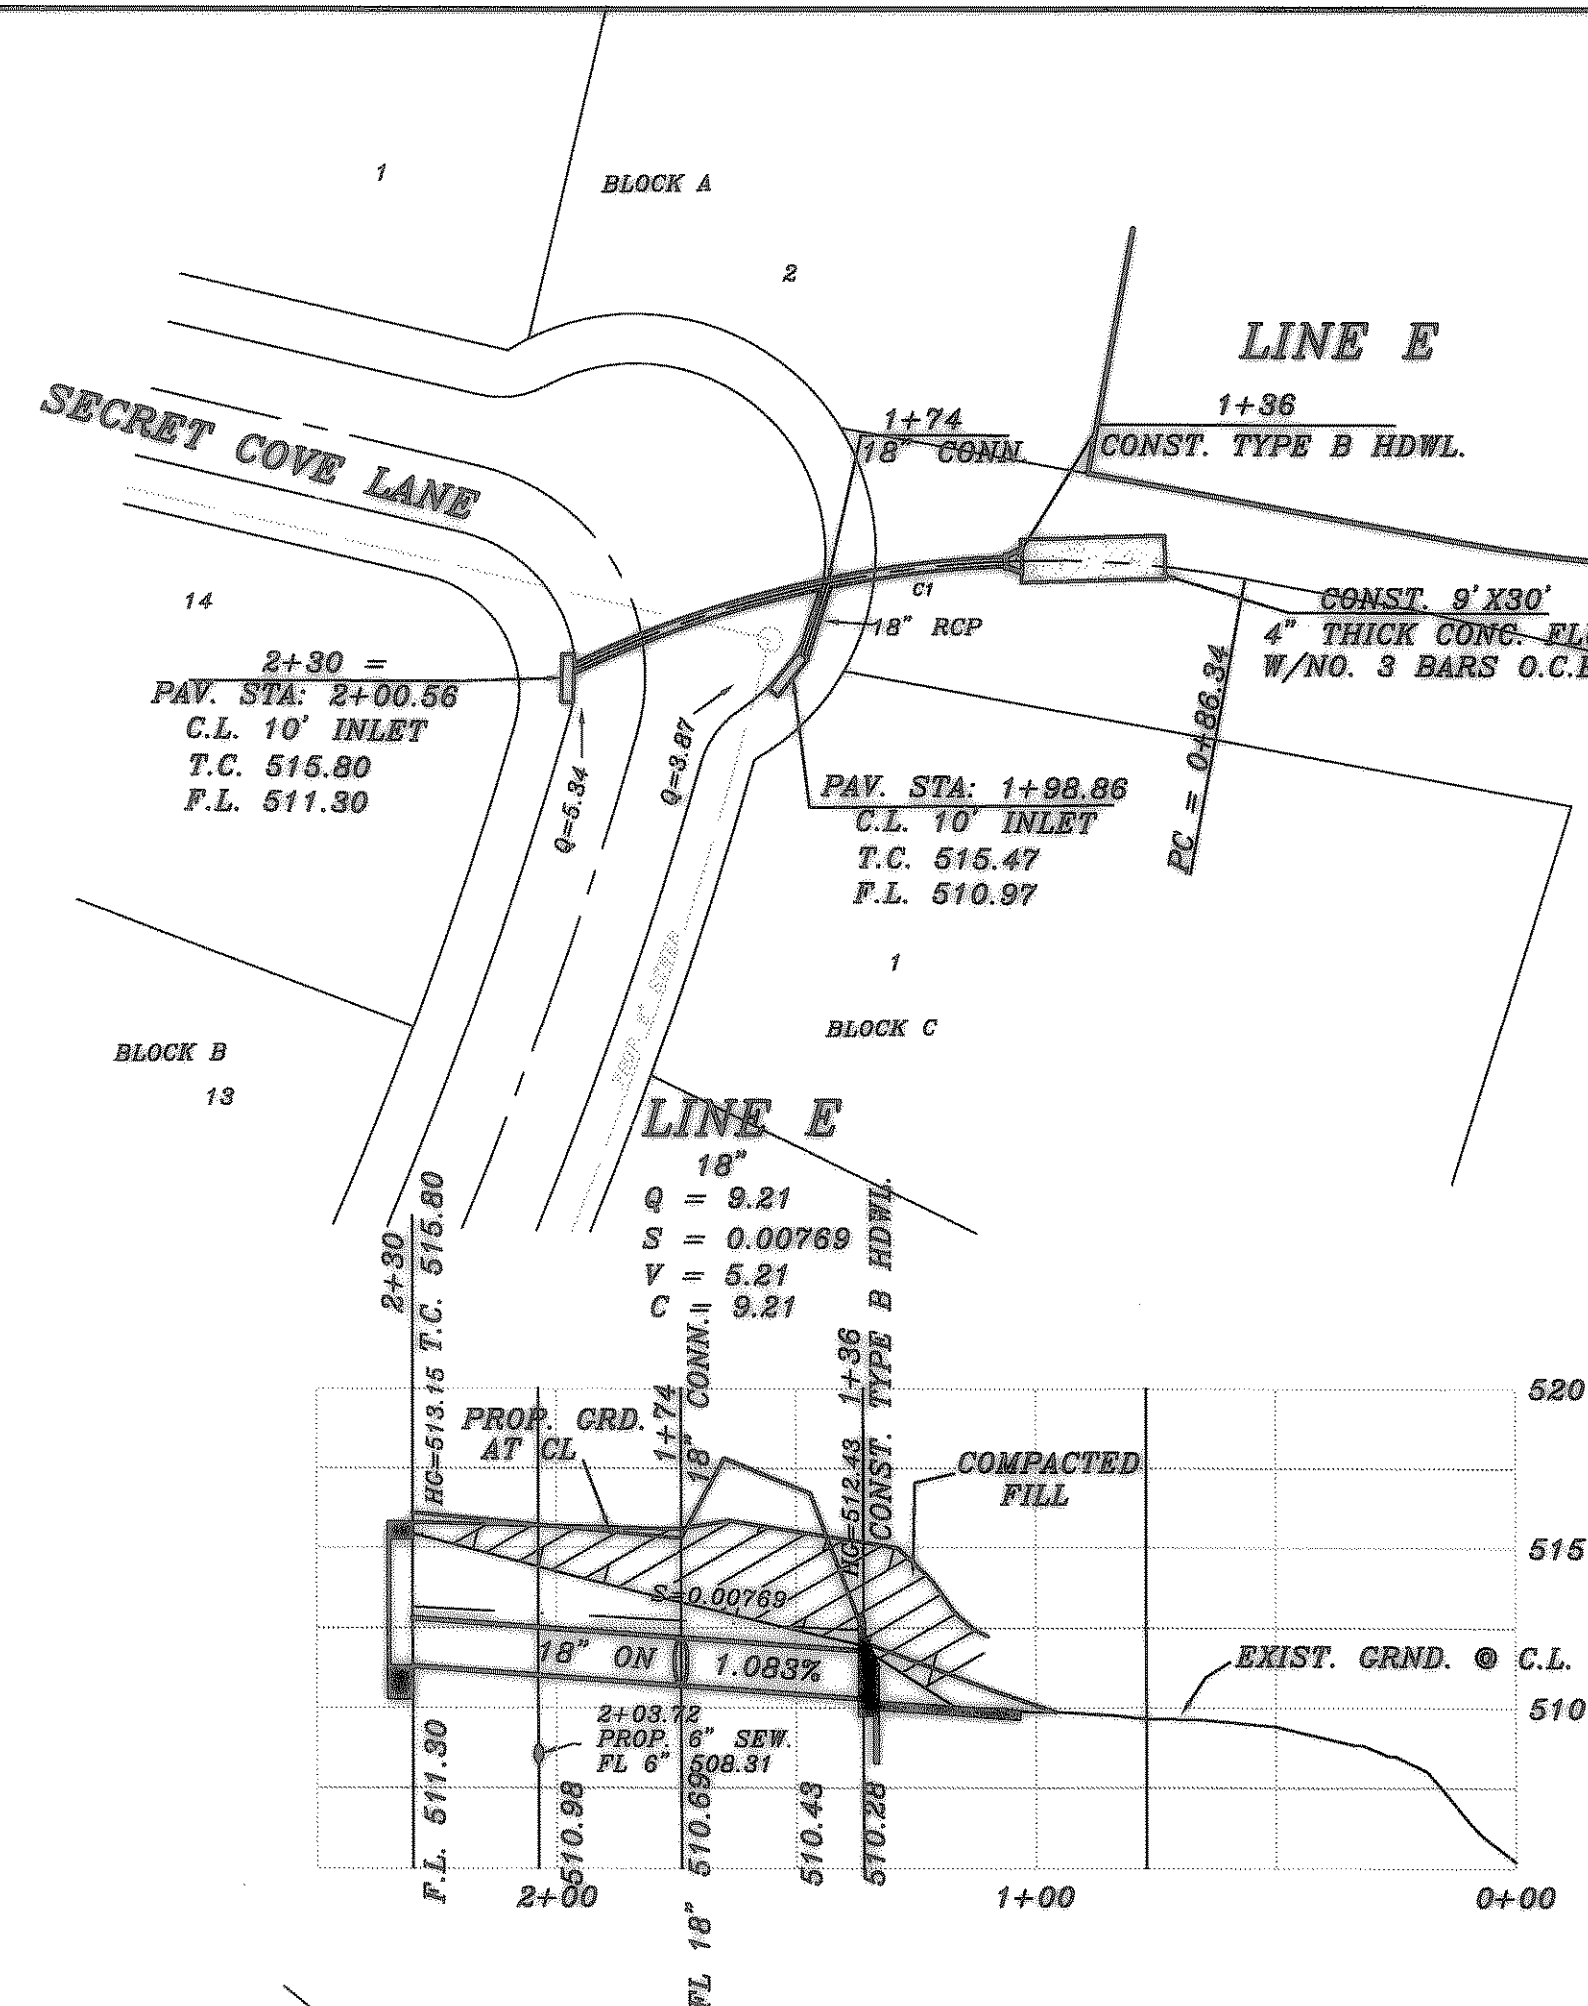

ROCKWALL MONUMENT:
 BRASS DISK ON SOUTHWEST CORNER OF 15' INLET ON SOUTH SIDE MICKA DRIVE, 21' ± EAST OF ADDITION LINE
 NORTHING: 7011300.3083
 EASTING: 2597678.0646
 ELEV.: 532.95

ROCKWALL MONUMENT:
 BRASS DISK ON SOUTHWEST CORNER OF 10' INLET ON SOUTHEAST SIDE WINDSONG LANE AT THE CORNER OF LOTS 13 AND 14, BLOCK C, RAINBOW LAKE ESTATES
 NORTHING: 7010353.5678
 EASTING: 2598423.8873
 ELEV.: 515.76

ROCKWALL MONUMENT:
 BRASS DISK ON NORTH CORNER OF 15' INLET ON NORTHWEST SIDE OF SECRET COVE LANE, 65' ± SOUTHWEST OF NORTH INTERSECTION OF SECRET COVE LANE AND WINDSONG LANE
 NORTHING: 7010983.0761
 EASTING: 2598011.6209
 ELEV.: 517.19

ROCKWALL MONUMENT:
 BRASS DISK ON SOUTHWEST CORNER OF 10' INLET ON THE SOUTHERLY SIDE OF VENUS COURT, 40' ± SOUTHWEST OF THE INTERSECTION OF VENUS COURT AND WINDSONG LANE
 NORTHING: 7010711.6432
 EASTING: 2598371.5159
 ELEV.: 517.80



AS-BUILT

REVISION DESCRIPTION REV. STREET NAMES 4/6/00 REV. LN. E 3/14/00 REV. 3/10/00 REV. PER CITY REVIEW 11/4/99		HAROLD L. EVANS CONSULTING ENGINEER P.O. BOX 28356 2331 CUS THOMASSON ROAD, SUITE 102 DALLAS, TEXAS 75228, (214) 328-8133		PROPOSED DRAINAGE LINE E, F AND G RAINBOW LAKE ESTATES CITY OF ROCKWALL	SHEET NO. 10 15 JOB NO. 98111
DATE SCALE DESIGN DRAWN 1" = 40' 1" = 6' H.L.E.		REVISION DESCRIPTION 98111372			