


CURVE	RADIUS	LENGTH	TANGENT	DELTA
C1	100.00'	50.00'	25.53'	28°38'52"
C2	90.00'	130.98'	60.17'	83°23'05"
C3	90.00'	132.05'	66.57'	84°34'52"
C4	80.00'	83.59'	46.15'	59°56'26"
C5	90.00'	54.46'	28.09'	34°40'17"
C6	670.63'	57.30'	28.67'	04°53'43"
C7	100.00'	48.09'	23.46'	26°24'22"

ROCKWALL MONUMENT:
BRASS DISK ON SOUTHWEST CORNER OF 15' INLET ON SOUTH SIDE MICAH DRIVE, 21' ± EAST OF ADDITION LINE
NORTHING: 7011900.3083
EASTING: 2597678.0646
ELEV.: 532.95

ROCKWALL MONUMENT:
BRASS DISK ON SOUTH CORNER OF 10' INLET ON SOUTHEAST SIDE WINDSONG LANE AT THE CORNER OF LOTS 13 AND 14, BLOCK C, RAINBOW LAKE ESTATES
NORTHING: 7010353.5678
EASTING: 2598423.8673
ELEV.: 515.78


ROCKWALL MONUMENT:
BRASS DISK ON NORTH CORNER OF 15' INLET ON NORTHERLY SIDE OF SECRET COVE LANE, 65' ± SOUTHWEST OF NORTH INTERSECTION OF SECRET COVE LANE AND WINDSONG LANE
NORTHING: 7010883.0761
EASTING: 2598011.6209
ELEV.: 517.19

ROCKWALL MONUMENT:
BRASS DISK ON SOUTHWEST CORNER OF 10' INLET ON THE SOUTHERLY SIDE OF VENUS COURT, 40' ± SOUTHWEST OF THE INTERSECTION OF VENUS COURT AND WINDSONG LANE
NORTHING: 7010711.6432
EASTING: 2598371.5159
ELEV.: 517.80

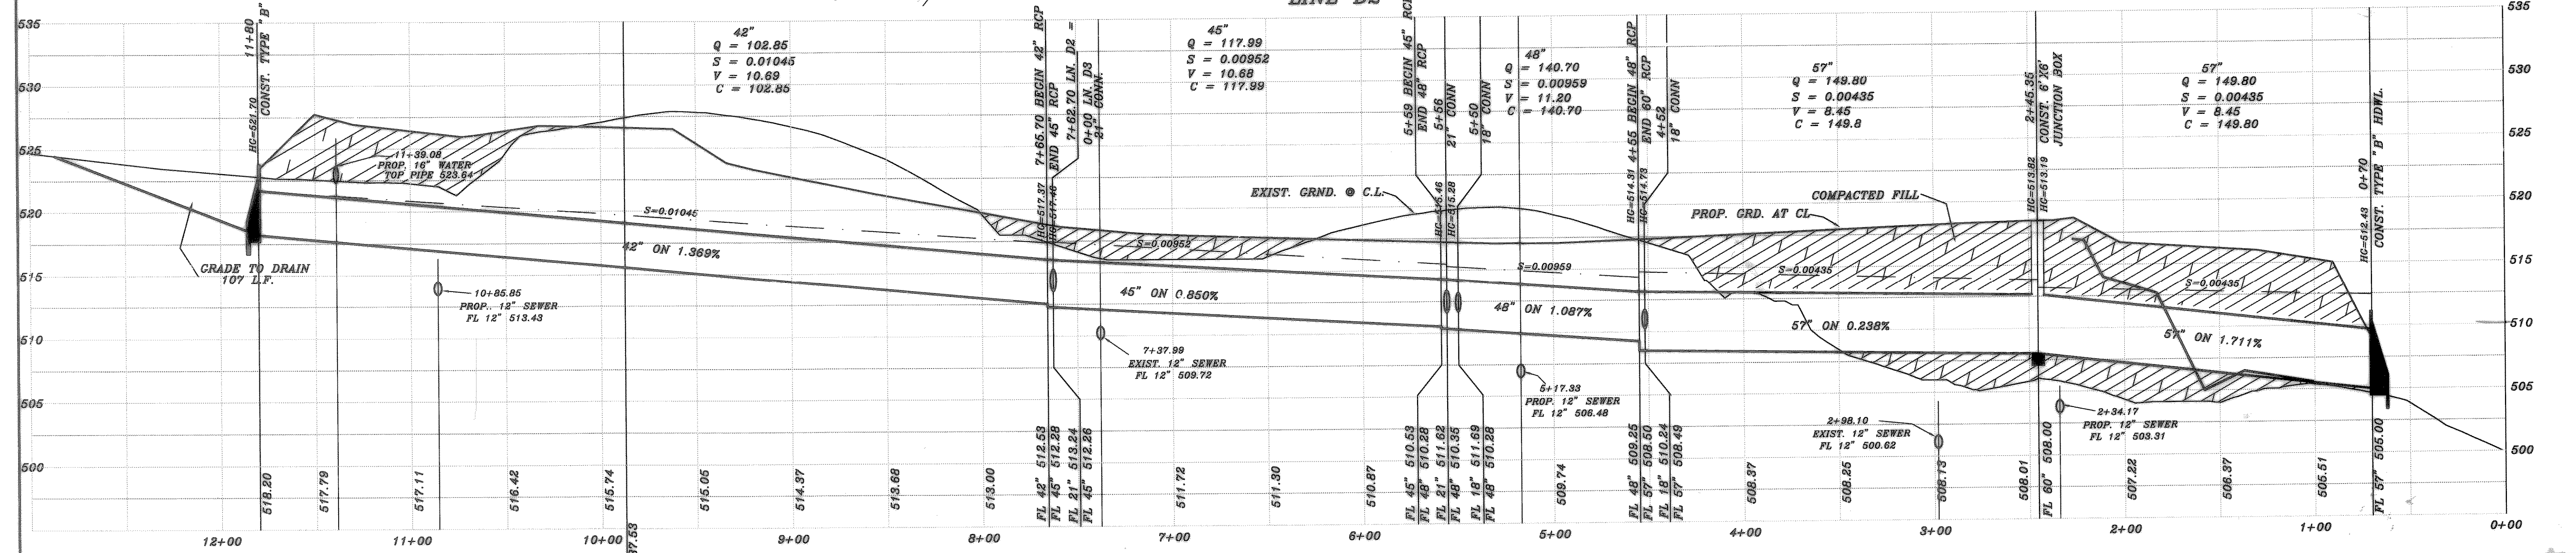

FOXCHASE NO. 6 RAINBOW LAKE ESTATES

AS-BUILT

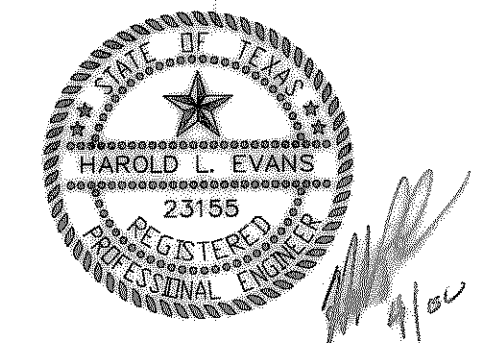

REV. STREET NAME	4/6/00
REV. LN. D3	3/10/00
REV. LN. D2, ADDED LN. D3	3/2/00
REVISION DESCRIPTION	DATE

HAROLD L. EVANS
CONSULTING ENGINEER
P.O. BOX 28355
2331 CUS THOMASSON ROAD, SUITE 102
DALLAS, TEXAS 75228. (214) 328-8133

SCALE: 1" = 40'
1" = 6'

DESIGN: H.L.E.
DRAWN:

PROPOSED DRAINAGE
LINE D2
RAINBOW LAKE ESTATES
CITY OF ROCKWALL

SHEET NO.	9
JOB NO.	98111