


AS-BUILT

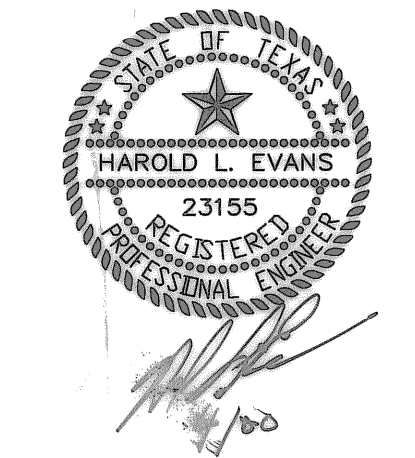

ROCKWALL MONUMENT:
BRASS DISK ON NORTH CORNER OF 15' INLET
ON SOUTH SIDE MICAH DRIVE, 21' ± EAST OF
ADDITION LINE
NORTHING: 7011300.3083
EASTING: 2597678.0646
ELEV.: 532.95

ROCKWALL MONUMENT:
BRASS DISK ON SOUTH CORNER OF 10' INLET
ON SOUTHEAST SIDE WINDSONG LANE AT THE
CORNER OF LOTS 13 AND 14, BLOCK C, RAINBOW
LAKE ESTATES
NORTHING: 7010353.5678
EASTING: 2598423.8673
ELEV.: 516.76

ROCKWALL MONUMENT:
BRASS DISK ON NORTH CORNER OF 15' INLET
ON NORTHWEST SIDE OF SECRET COVE LANE,
65' ± SOUTHWEST OF NORTH INTERSECTION OF
SECRET COVE LANE AND WINDSONG LANE
NORTHING: 7010983.0761
EASTING: 2598011.8209
ELEV.: 517.19

ROCKWALL MONUMENT:
BRASS DISK ON SOUTHWEST CORNER OF 10' INLET
ON THE SOUTHERLY SIDE OF VENUS COURT, 40' ±
SOUTHWEST OF THE INTERSECTION OF VENUS COURT
AND WINDSONG LANE
NORTHING: 7010711.6432
EASTING: 2598371.5159
ELEV.: 517.60

REVISION DESCRIPTION	DATE
REV. STREET NAMES	4/6/00
REV. LINE A	3/2/00
REV. PE'S CITY REVIEW	11/4/99

HAROLD L. EVANS
CONSULTING ENGINEER
P.O. BOX 28365
2331 GUS THOMASSON ROAD, SUITE 102
DALLAS, TEXAS 75228, (214) 388-8133

PROPOSED UTILITIES
RAINBOW LAKE ESTATES
CITY OF ROCKWALL

SHEET NO.	12
JOB NO.	98111