



FOR

CONSTRUCTION PLANS

PAVING, DRAINAGE & UTILITY IMPROVEMENTS

RALPH HALL COURT

CITY OF ROCKWALL, TEXAS

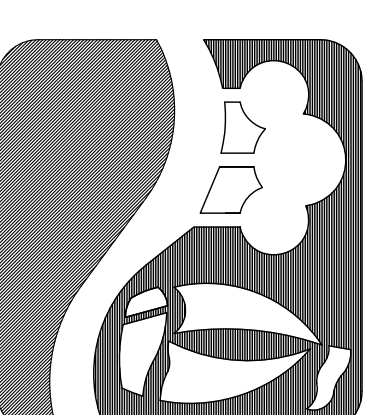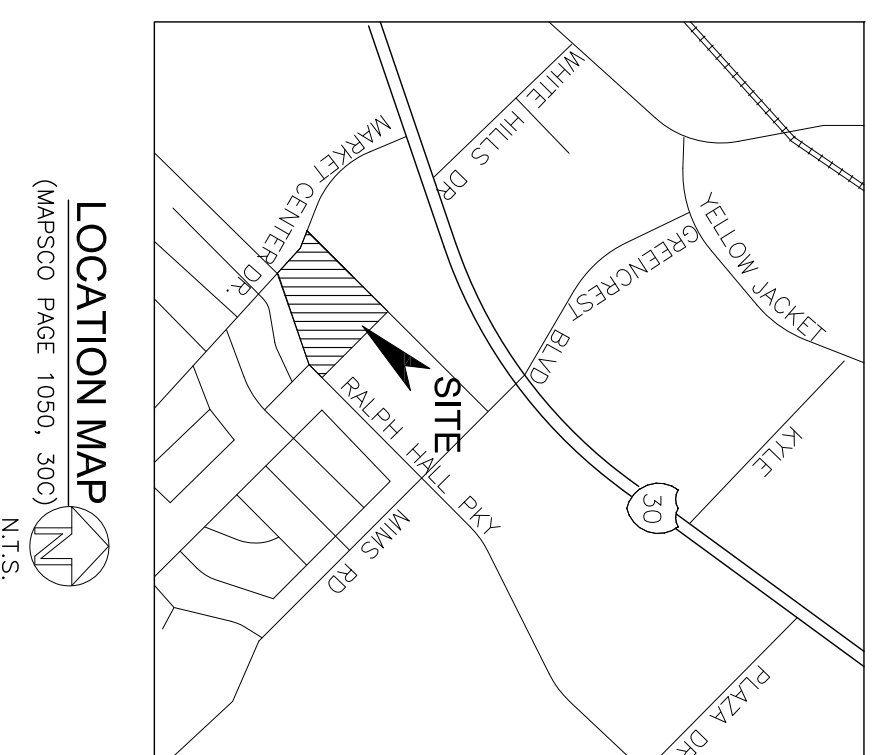

MAYOR
BILL CECIL

CITY COUNCIL

DAVID SWEET (PLACE 1)

GLEN FARRIS (PLACE 3, MAYOR PRO-TEM)

MATT SCOTT (PLACE 5)

CITY MANAGER

JULIE COUCH

MARK RUSSO (PLACE 2)

CLIFF SEVIER (PLACE 4)

MARGO NIELSEN (PLACE 6)

DIR OF PUBLIC WORKS & CITY ENGINEER

CHUCK TODD, P.E.

PROJECT ENGINEER

PANN S. SRIBHEN, P.E.

PROJECT ADMINISTRATOR

JIM MEARA

SHEET INDEX

- G-1 COVER SHEET
- G-2.1 FINAL PLAT
- G-2.2 FINAL PLAT
- G-3 GENERAL NOTES
- G-1 PROJECT SITE PLAN
- G-2 DRAINAGE AREA MAP
- G-3 TYPICAL ROADWAY CROSS SECTION
- G-4 RALPH HALL CT. PLAN AND PROFILE
- G-5 LEFT TURN LANE PLAN AND DETAILS
- G-6 DRAINAGE IMPROVEMENT PLAN
- G-6.2 GRADING PLAN
- G-7.1 UTILITY PLAN (WATERS)
- G-7.2 UTILITY PLAN (SANITARY SEWER)
- G-8 STREET LIGHT ON E. RALPH HALL PKWY
- G-9 EROSION CONTROL PLAN AND DETAILS
- G-10 BARRICADE PLAN
- G-11 TRAFFIC CONTROL PLAN

**STANDARD CONSTRUCTION DETAILS FOR CITY OF ROCKWALL NOT INCLUDE IN THIS SET

AS BUILT
THIS IS TO CERTIFY THAT CHANGES
HAVE BEEN MADE TO THE ORIGINAL
MADE TO CONFORM TO THE
CONTRACTOR'S RECORD OF THIS
PROJECT.



17819 DAVENPORT ROAD, SUITE 216
DALLAS, TEXAS 75232
(972) 248-9851 FAX (972) 248-9851
TX T.B.P.E. REGISTRATION # F-2008974

GJ DEVELOPMENT, L.C
1500 INDUSTRIAL BLVD
MCKINNEY, TX 75069
(972) 562-5555

SHEET
G-1

JUNE 22, 2011