


HORIZ: 1"=20'  
 VERT: 1"=2'

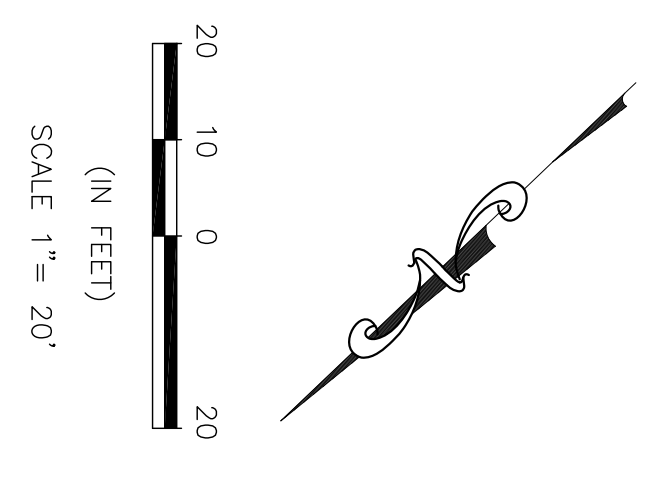

**BENCHMARK**  
 TOP NORTHEAST CORNER OF CONCRETE W/TE INLET LOCATED IN SOUTHWEST CORNER OF HOME DEPOT  
 ELEV = 540.89



**AS BUILT**  
 THIS IS TO CERTIFY THAT CHANGES AND CORRECTIONS HAVE BEEN MADE TO THE ORIGINAL DESIGN AND THE CONTRACTOR'S RECORD OF THIS PROJECT.

**RALPH HALL CT. PLAN AND PROFILE**

ROCKWALL MARKET CENTER SOUTH  
 ROCKWALL, TEXAS

**GU DEVELOPMENT, LP.**  
 PSA ENGINEERING

1500 E INDUSTRIAL BOULEVARD, MARLIN, TEXAS 75068, (972) 562-5555  
 17819 DANFORTH ROAD, SUITE 218 DALLAS, TX 75228, PH (972) 248-9851, FAX (972) 248-9881  
 T.B.P.E. REGISTRATION # F-6974, T.B.P.L.S. FROM REGISTERED NO. 100433

DESIGN	DRAWN	DATE	SCALE	CHECK	FILE	NO.
PSA	PSA	06/22/11	AS SHOWN	PSS	21009.RMS	<b>C4</b>